


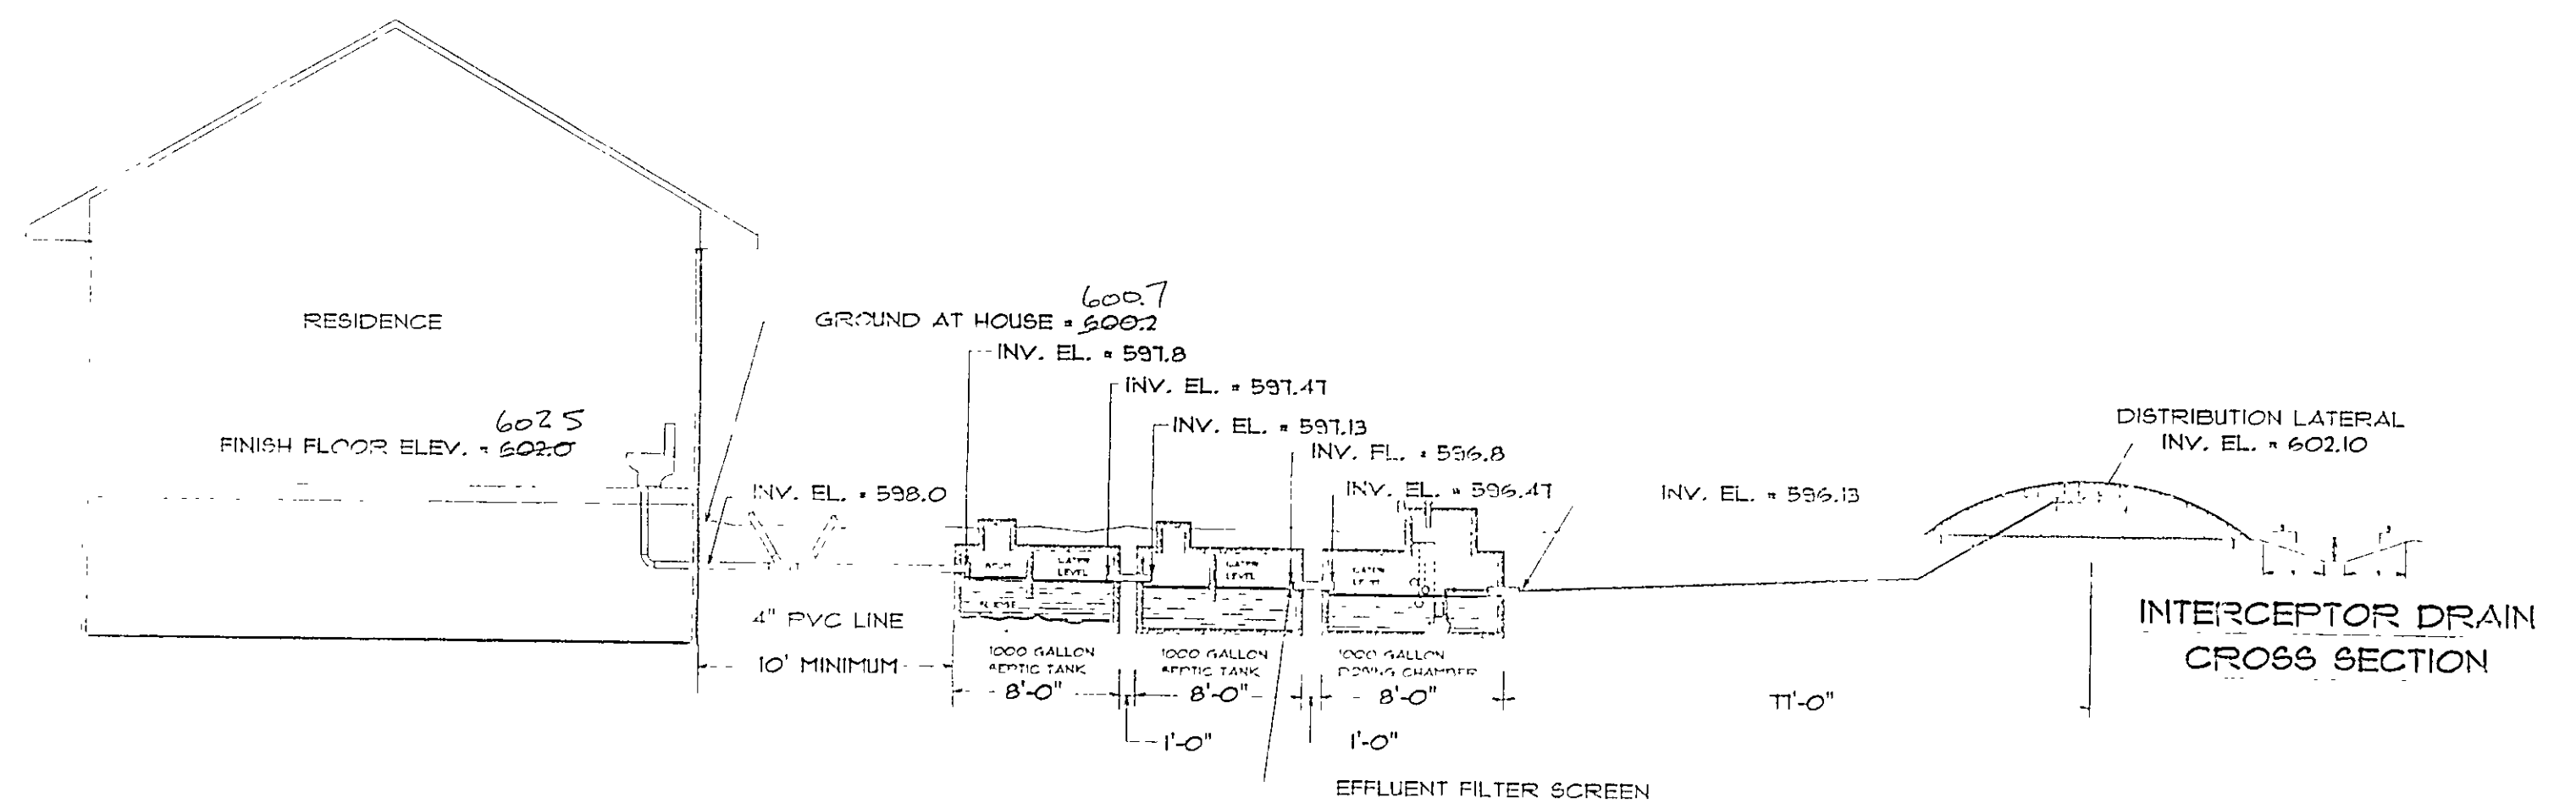

HYDRAULIC PROFILE
NTS

