

Madison Township

RECEIVED FEB 24 1998

SITE PLAN



MADISON LAKE COUNTY, OHIO

For: Bellevue, Inc.

1396 Bellevue Rd. Painesville, OH 44060

PROJECT NO.	13	DATE	3/24/98
DESIGNED BY	DAVE DR	SCALE	1" = 30'
CHECKED BY	DAVE DR	PROJECT NO.	357-1811
DATE	3/24/98	DRAWING NO.	85-120-13

Grading Plan Approved
as shown and/or noted
THOMAS P. GILLES, P.E.
Lake County Engineer
Date 3/24/98

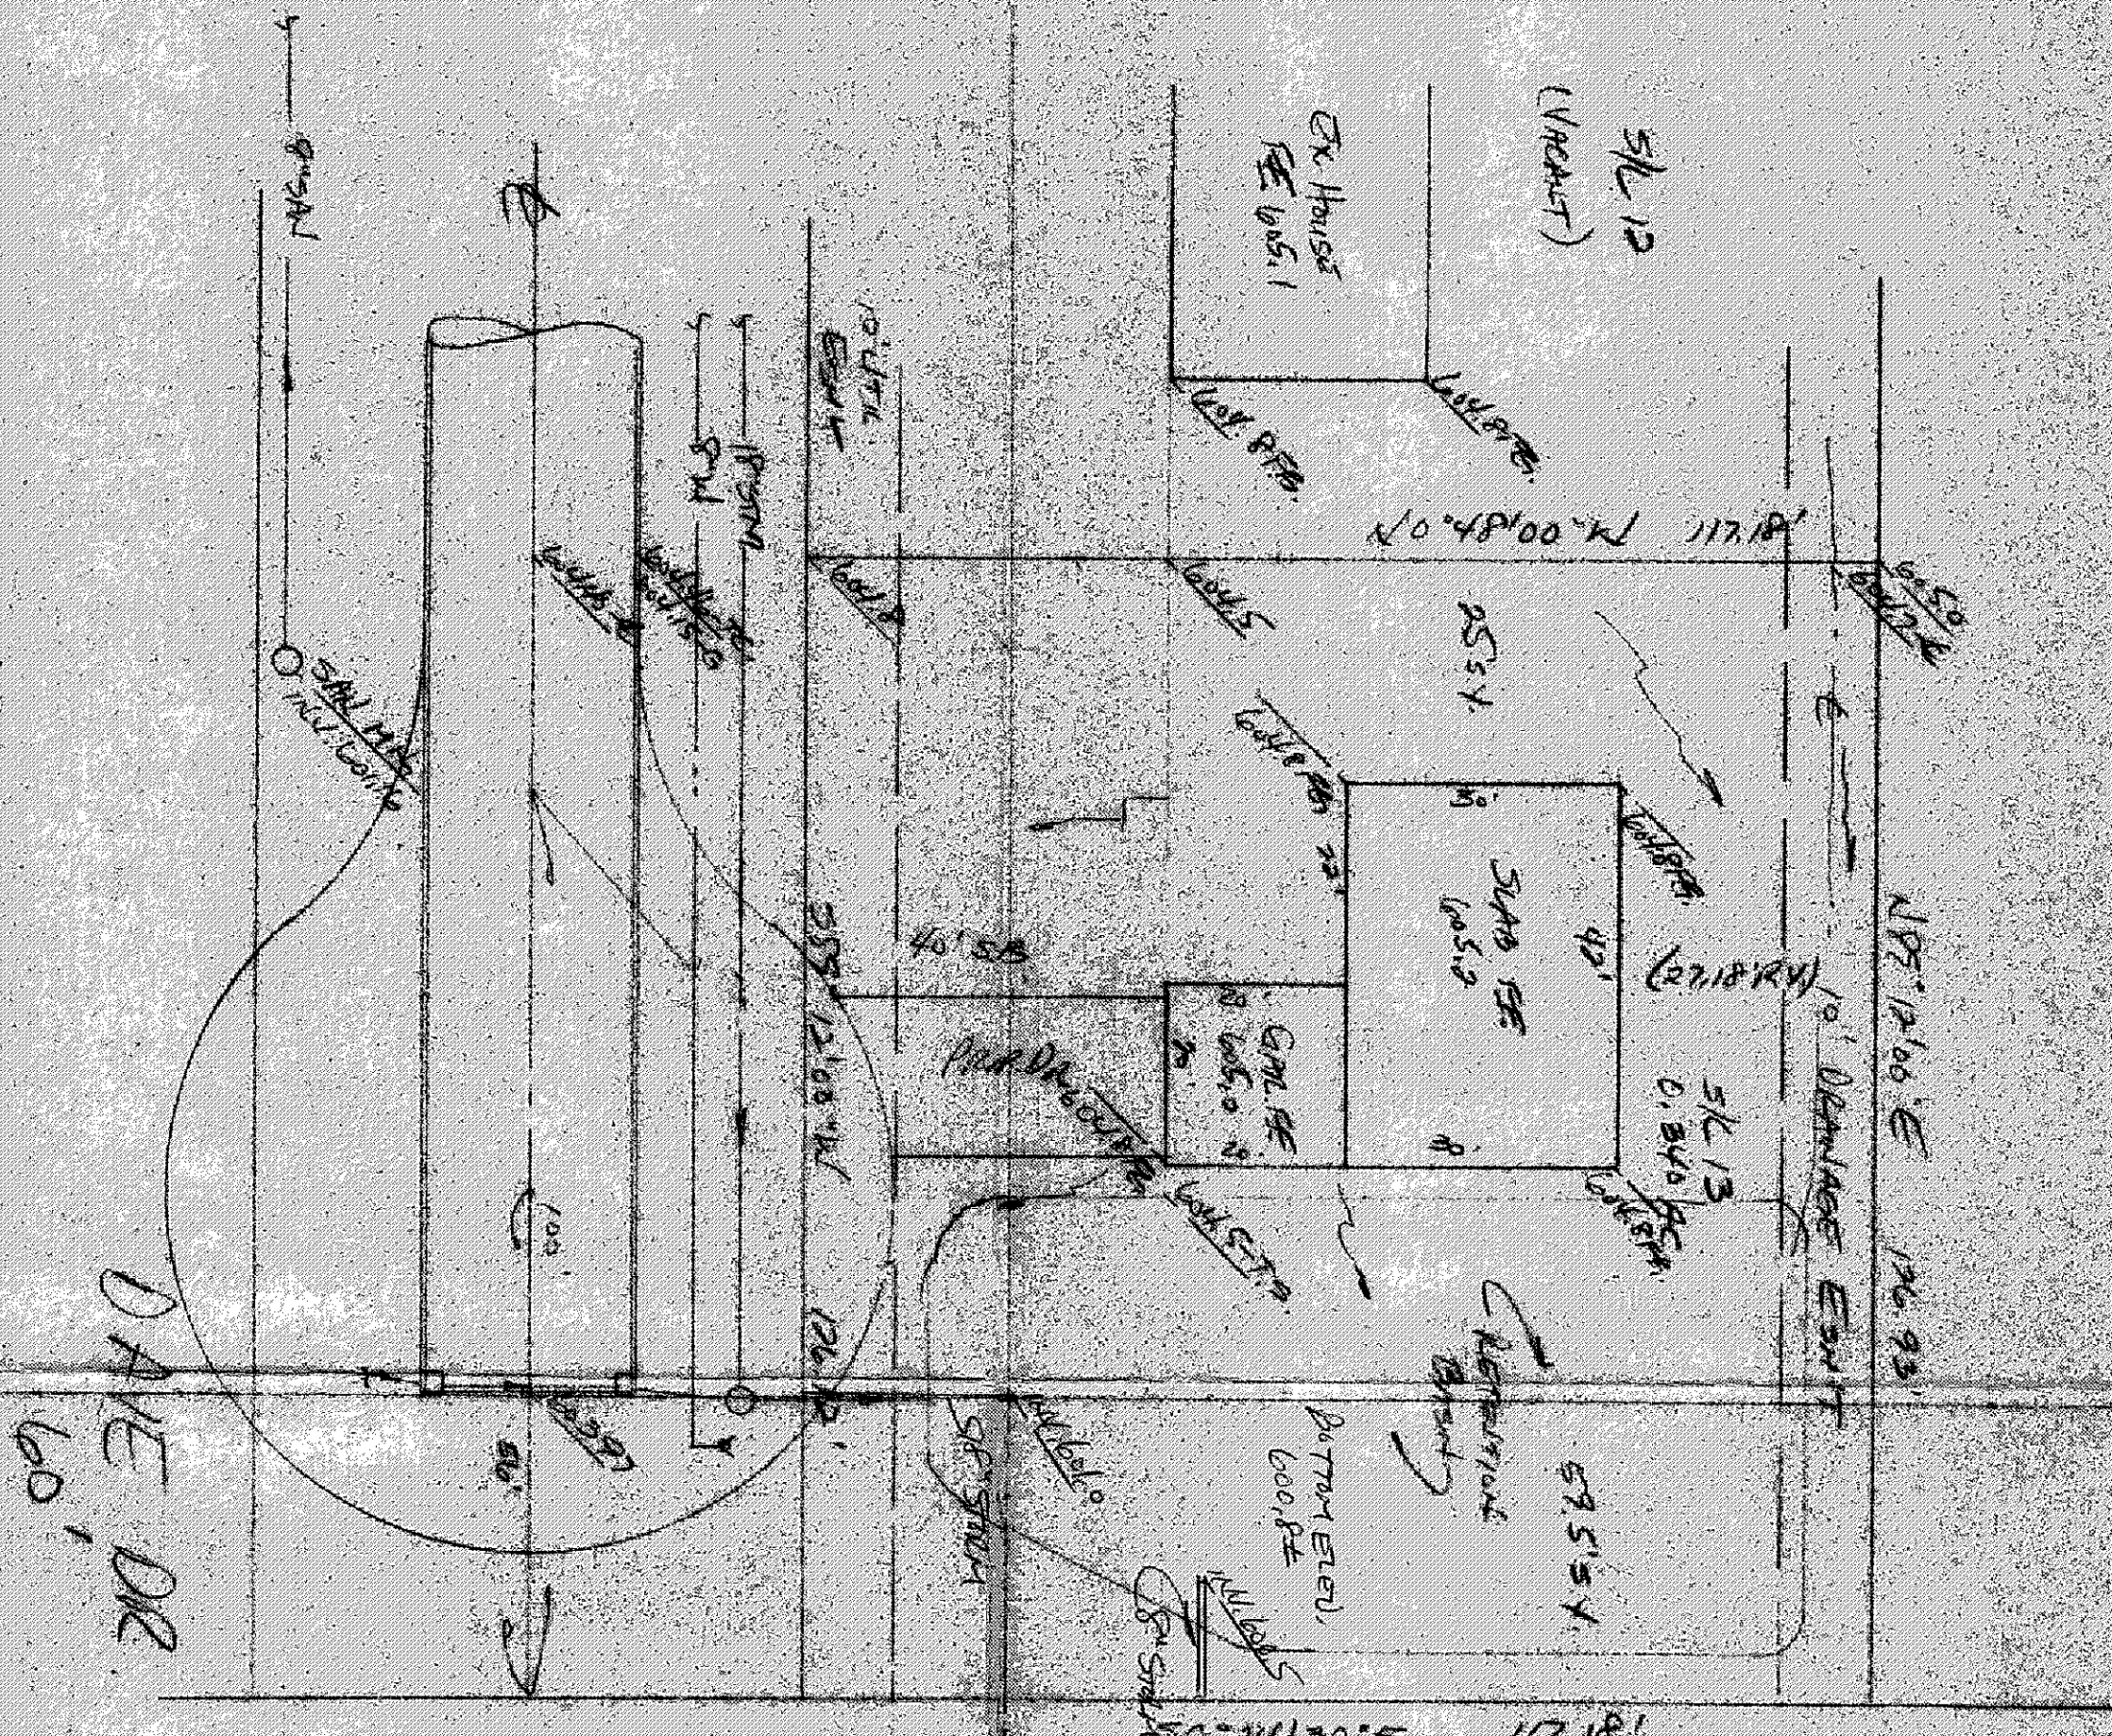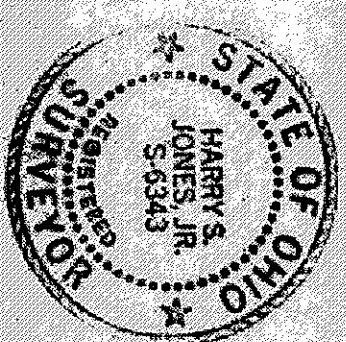

LEGEND	SYMBOL	DESCRIPTION
AS BUILT ELEVATION	Circle with 'x'	AS BUILT ELEVATION
INDICATES DIRECTION OF SURFACE DRAINAGE	Arrow	INDICATES DIRECTION OF SURFACE DRAINAGE

REMARKS

ALL BOUNDARY DATA SHOWN WAS OBTAINED FROM IDES, RECORDED
SUBDIVISION PLAT OR OTHER PUBLIC RECORDS
LOCATIONS AS SHOWN OF ADJACENT WELLS AND SEPTIC TANKS OBTAINED FROM
LAKE COUNTY HEALTH DEPARTMENT

DESIGN CERTIFICATION

THIS PLAT WAS PREPARED BY ME, AND IS CORRECT
TO THE BEST OF MY KNOWLEDGE AND BELIEF.

NAME Harry S. Jones, Jr. SURVEYOR REGISTRATION NO. 6343

CHECK LIST


PLAN PREPARED BY:

BABCOCK • JONES & ASSOCIATES, INC.
PAINESVILLE, OHIO

NO.	DATE	BY	SCALE	PROJECT NO.	DRAWING NO.
1	3/24/98	DAVE DR	1" = 30'	357-1811	85-120-13

"AS BUILT" CERTIFICATION

I, HEREBY CERTIFY THAT THE CIRCLED GRADES ARE EXISTING
FINISH GRADES CHECKED IN THE FIELD ON 19
AND ARE CORRECT TO THE BEST OF MY KNOWLEDGE AND BELIEF.

REGISTERED SURVEYOR REG. NO.

APPROVED

MADISON TWP. ZONING

Permit: 2816

Zoning Inspector: DAVE DR