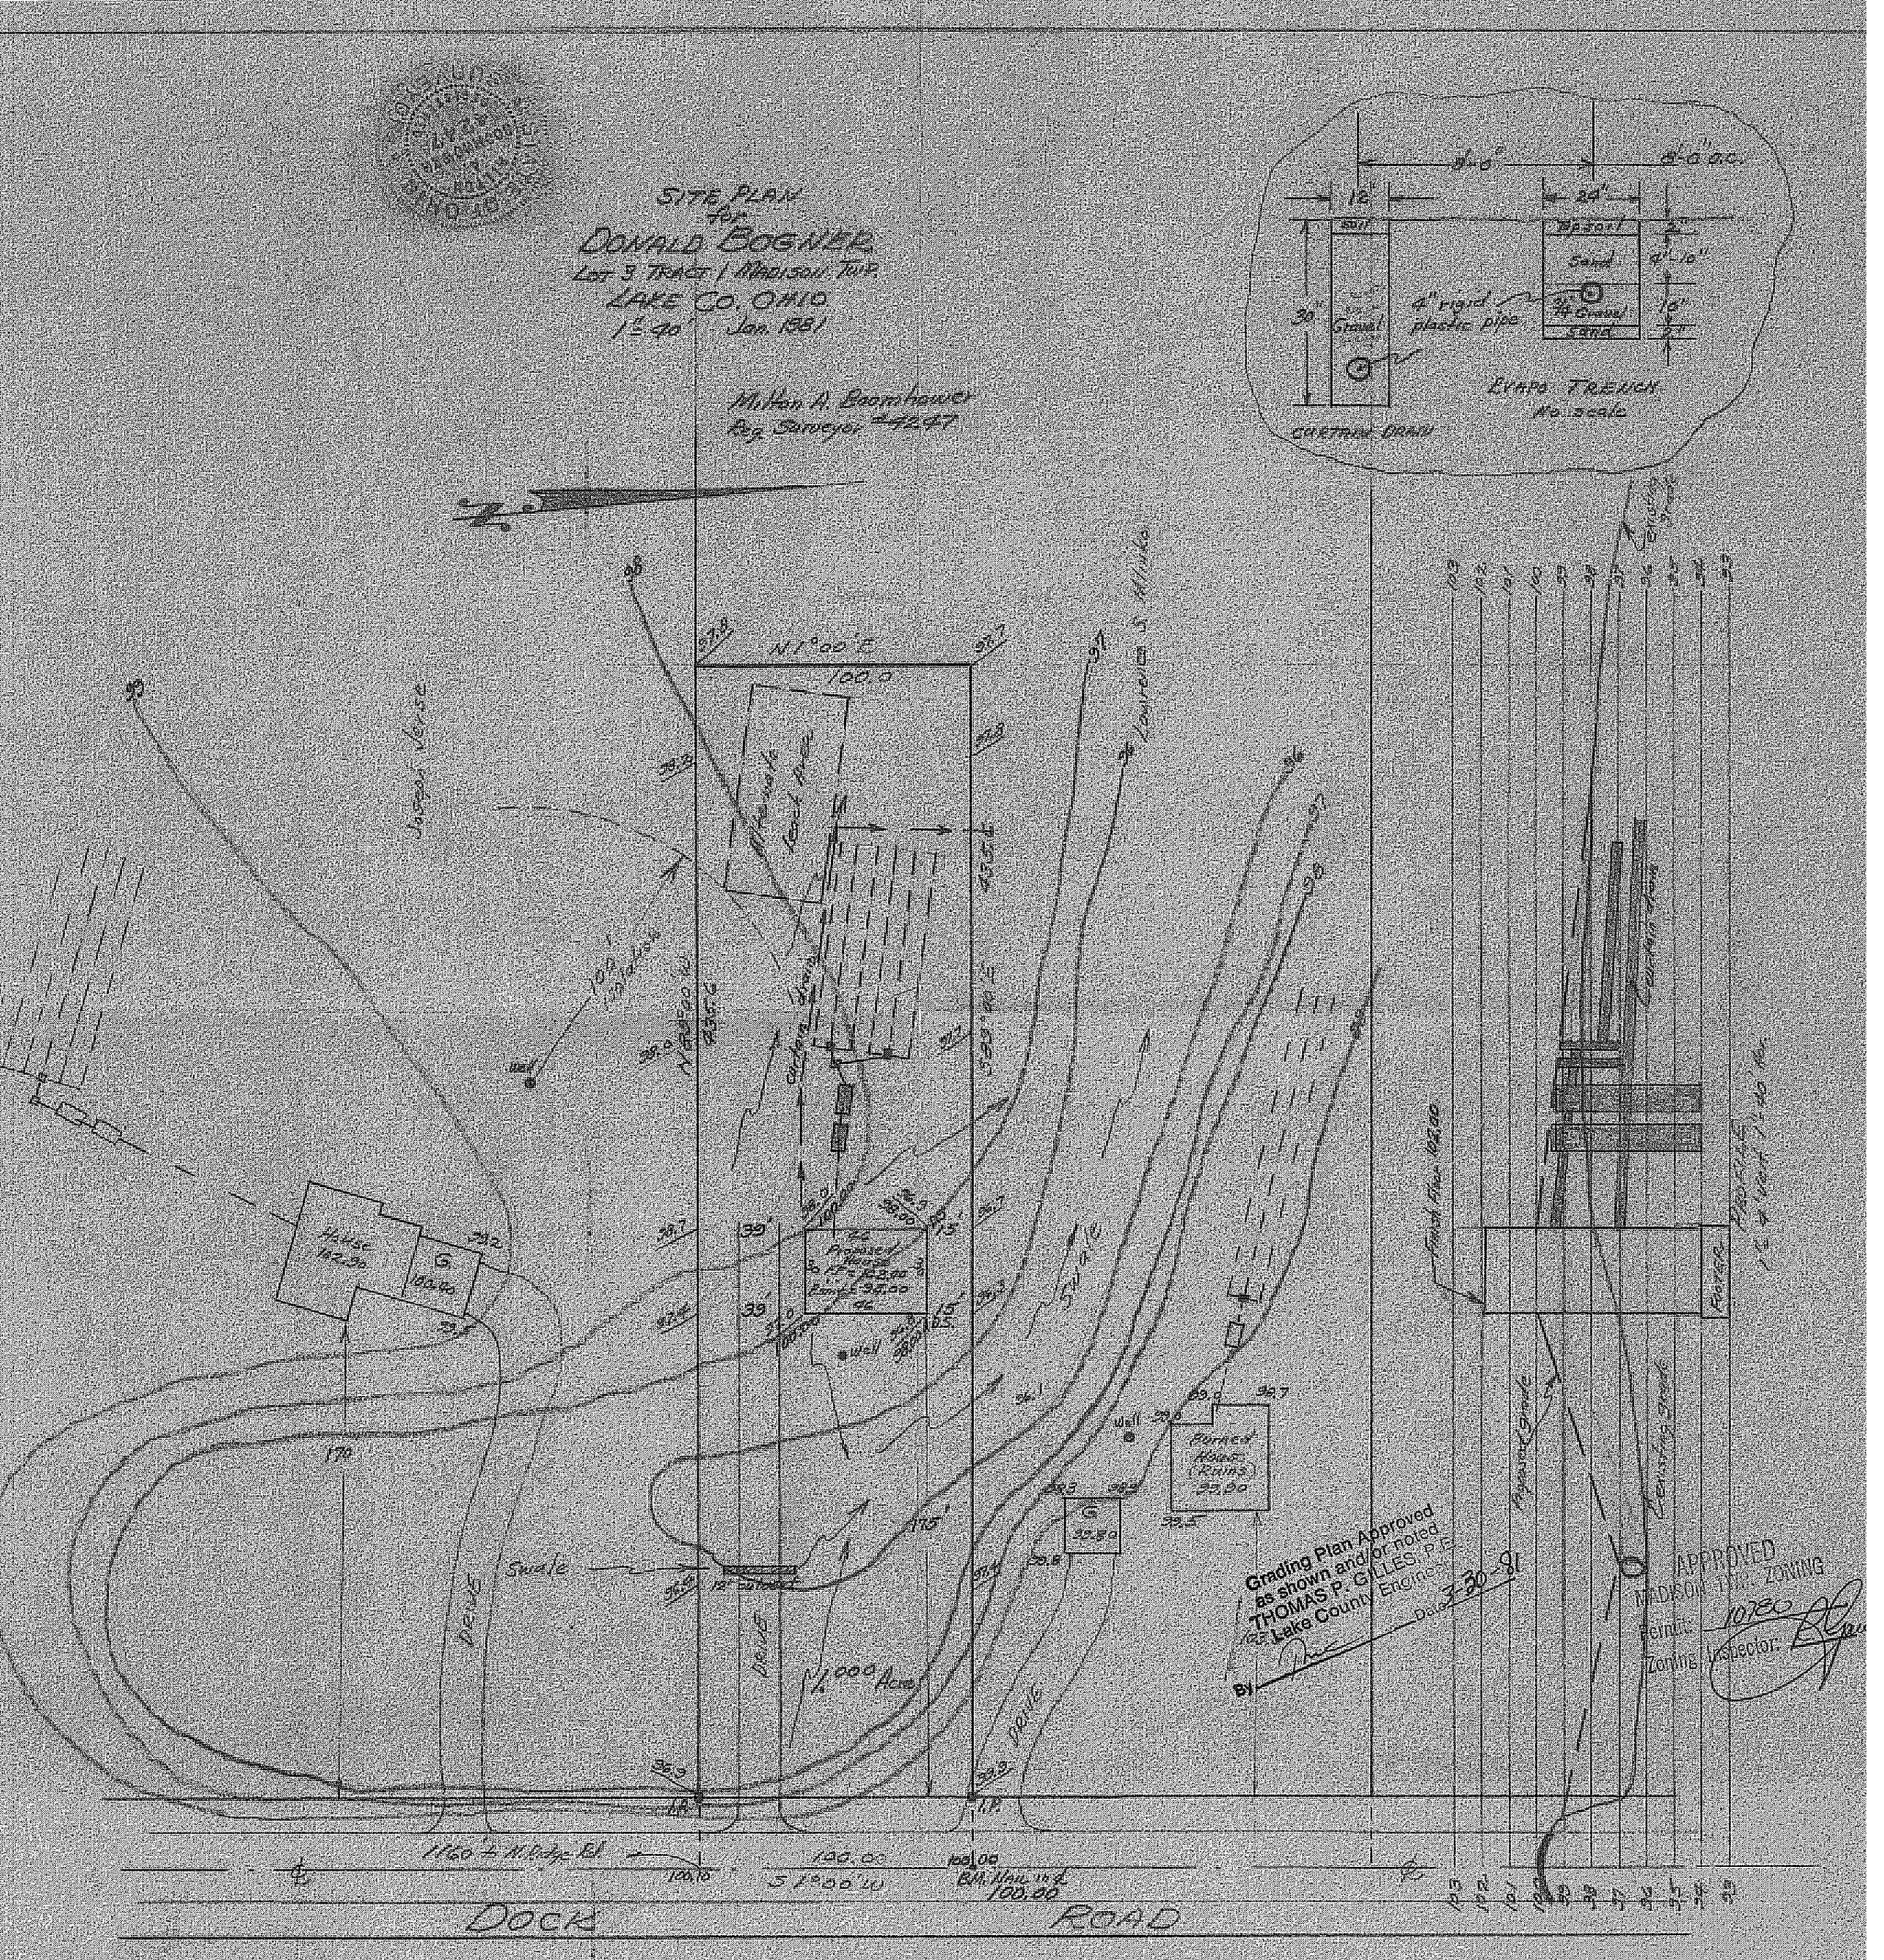
SITE PLAN
FOR
DONALD BOGNER
LOT 5 TRACT 1 MADISON TWP.
LAKE CO. OHIO
1" = 40' Jan. 1981
Milton A. Boomhower
Reg. Surveyor 4247
N 1° 00' E
100.0
Proposed House
Garage 30.00
Proposed House (Ruins) 25.00
House 182.30
Garage 18.00
Swale
12" Culvert
1160 ± N Ridge Rd
100.00
S 1° 00' W
100.00
BM. Nail in d
100.00
DOCK
ROAD
Grading Plan Approved as shown and/or noted
THOMAS P. GILLES, P.E.
Lake County Engineer
Date 7-30-81
APPROVED
MADISON TWP. ZONING
Permit: 10780
Zoning Inspector:
8'-0"
8'-0" SC.
12"
24"
Soil
Topsoil
Sand
4" rigid plastic pipe
3/4 Gravel
Sand
30"
Gravel
18"
EVAPO TRENCH
No scale
CULTURE DRAIN