


SITE PLAN
FOR
BILL BARBIS
BEING SUBLOT NOS. 522 & 523
OF MADISON LAKELANDS SUBD II.
IN THE TOWNSHIP OF MADISON,
COUNTY OF LAKE, STATE OF OHIO.

Grading Plan Approved
as shown and/or noted
THOMAS P. GILLES, P.E.
County Engineer
By 414 Date 8/30/91
DRIVE CULVERT REQUIRED

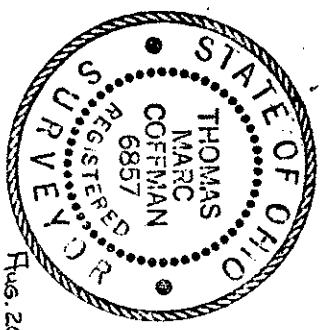

SEIBACK ADDRESS

37' 1547
39.5' 1547
34.5' 1541
34' CORN HAYWARD

I, the undersigned hereby certify that this topography, indicated by '1' contours and elevations shown hereon represents an actual field survey made by me on July 18, 1991 and that the elevations were taken at appropriate intervals and that as of that date they existed as indicated hereon.

APPROVED

VILLAGE SURVEYING CO.
202 THIRD ST., FAIRPORT HBR. OH 44107 MADISON TWP. ZONING
{216} 357-1359

Permit 13156
Zoning Inspector: MC
AUG. 29 1991

USGS = ELEV. +4.24
BENCHMARK- 592.72
N.R.M. SAN MH. INV. 589.73

