Grading Plan Approved
as shown and/or noted
JAMES R. GILLS, P.E.
Lake County Engineer

By TAM Date 3-15-01

1. Swale as shown
2. CONCRETE Apron SHALL BEGIN A MIN. OF 3' FROM GREEN Rd ℄ E/P.
3. ROOF DRAINS SHALL DISCHARGE TO SPLASH BLOCKS.
4. A permit will be required for utility work WITHIN GREEN Rd R/W

SCALE: 1" = 20'

N

EXIST. PROP.

EXIST. PROP.

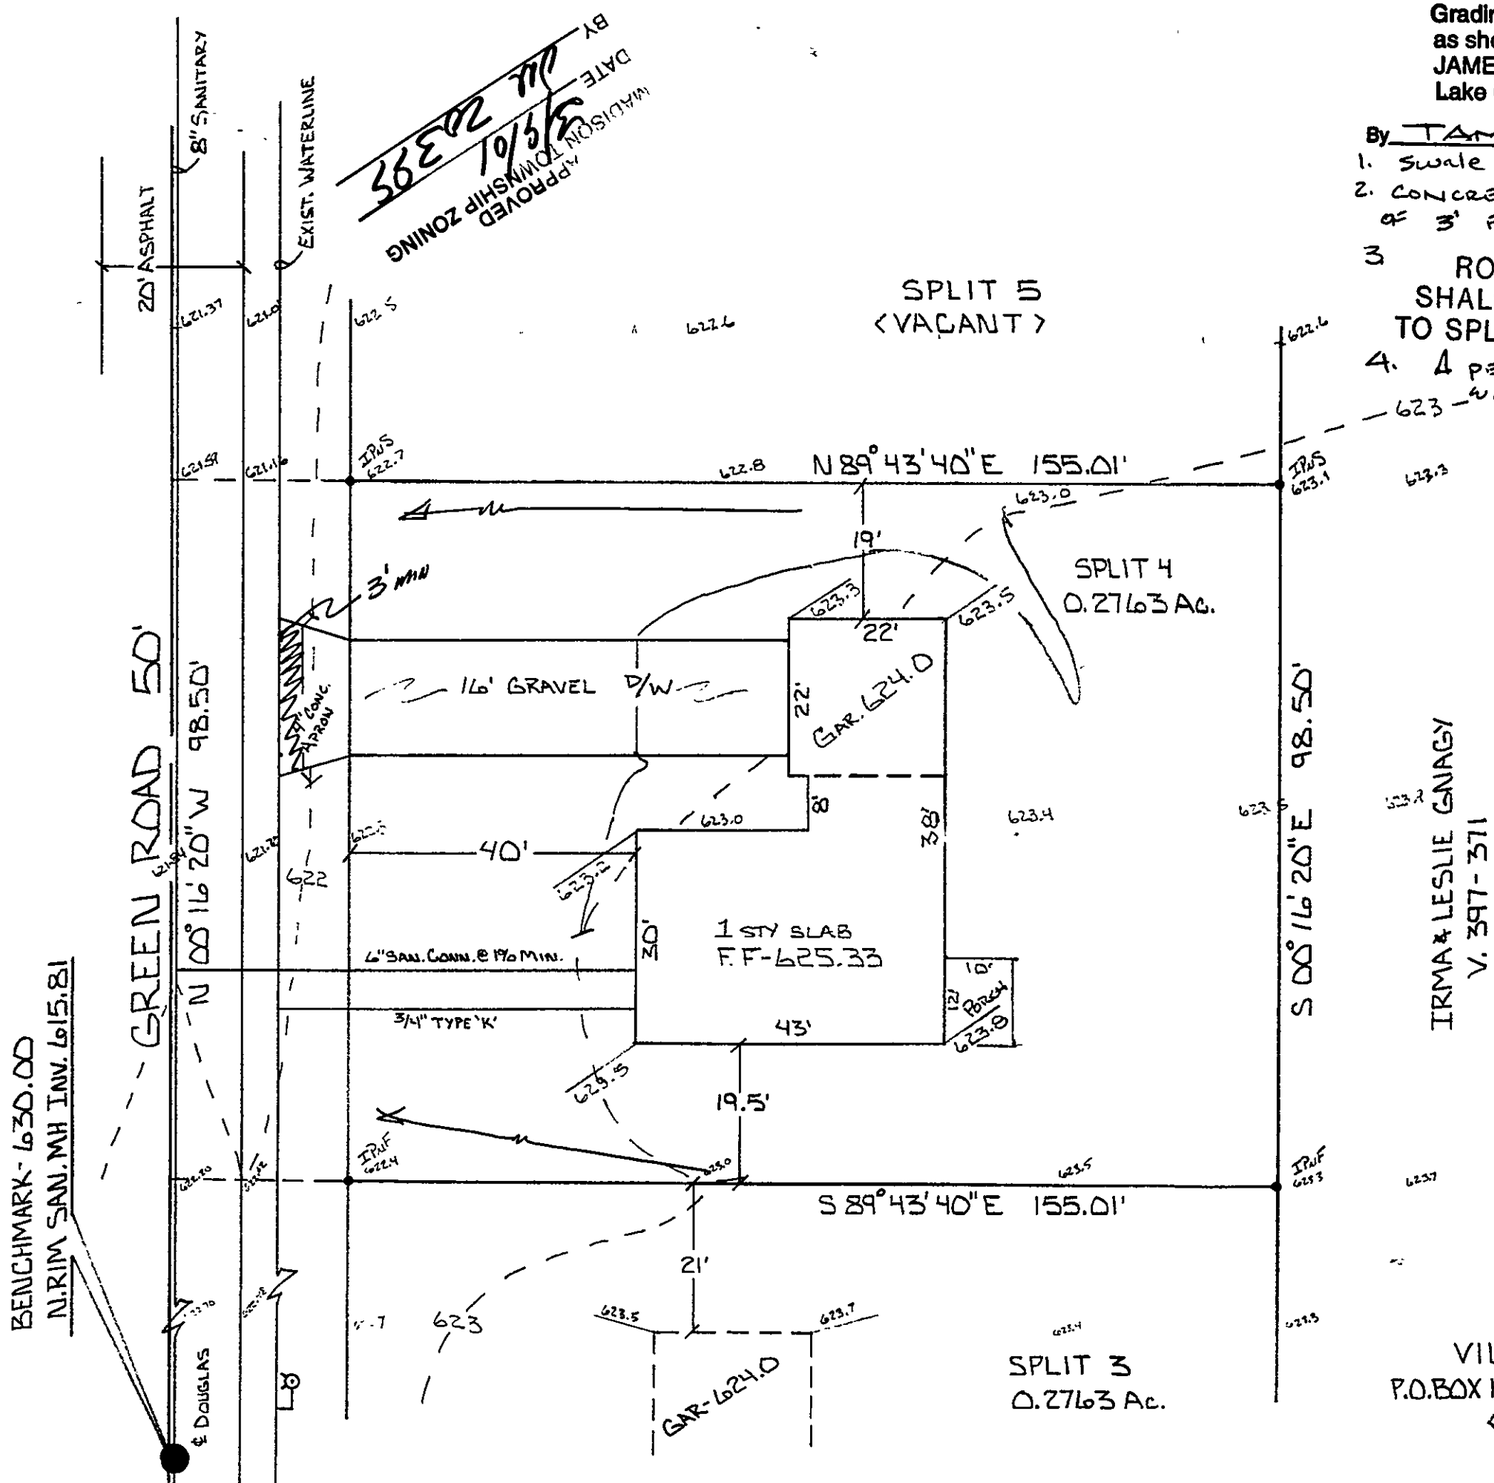

SITE PLAN
FOR
GLENN GNAGY

BEING KNOWN AS SPLIT NO. 4 OF THE IRMA & LESLIE GNAGY LOT SPLIT PART OF LOT NO. 1 TRACT NO. 5 IN MADISON TOWNSHIP, LAKE COUNTY, OHIO.

STATE OF OHIO
THOMAS MARC COFFMAN 6857
REGISTERED PROFESSIONAL SURVEYOR
MARCH 6, 2001

I, the undersigned hereby certify that this topograghy, indicated by 1' contours and elevations shown hereon represent an actual field survey made by me on 8-18-00 and that the elevations were taken at appropriate intervals and that as of that date they existed as indicated hereon.

T. M. Coffman P.S.
THOMAS M. COFFMAN P.S. No. 6857

VILLAGE SURVEYING CO.
P.O. BOX 1096 FAIRPORT HARBOR OHIO 44077
(440) 357-1359