REVISIONS	BY

Barrington
CONSULTING GROUP, INC.
9114 TYLER BLVD., MENTOR, OHIO 44060
PHONE 440.205.1260 FAX 440.205.1262
www.BarringtonCGI.com

STATE OF OHIO
DAVID W. NOVAK
S-7507
REGISTERED
SURVEYOR

SITE PLAN

S/L 13 GREENBRIAR LN. MADISON TWP. OHIO 44057
WHISPERING PINES SUBDIVISION PH. 1 VOL. 51 PG. 40

LITTLE MOUNTAIN HOMES, INC.

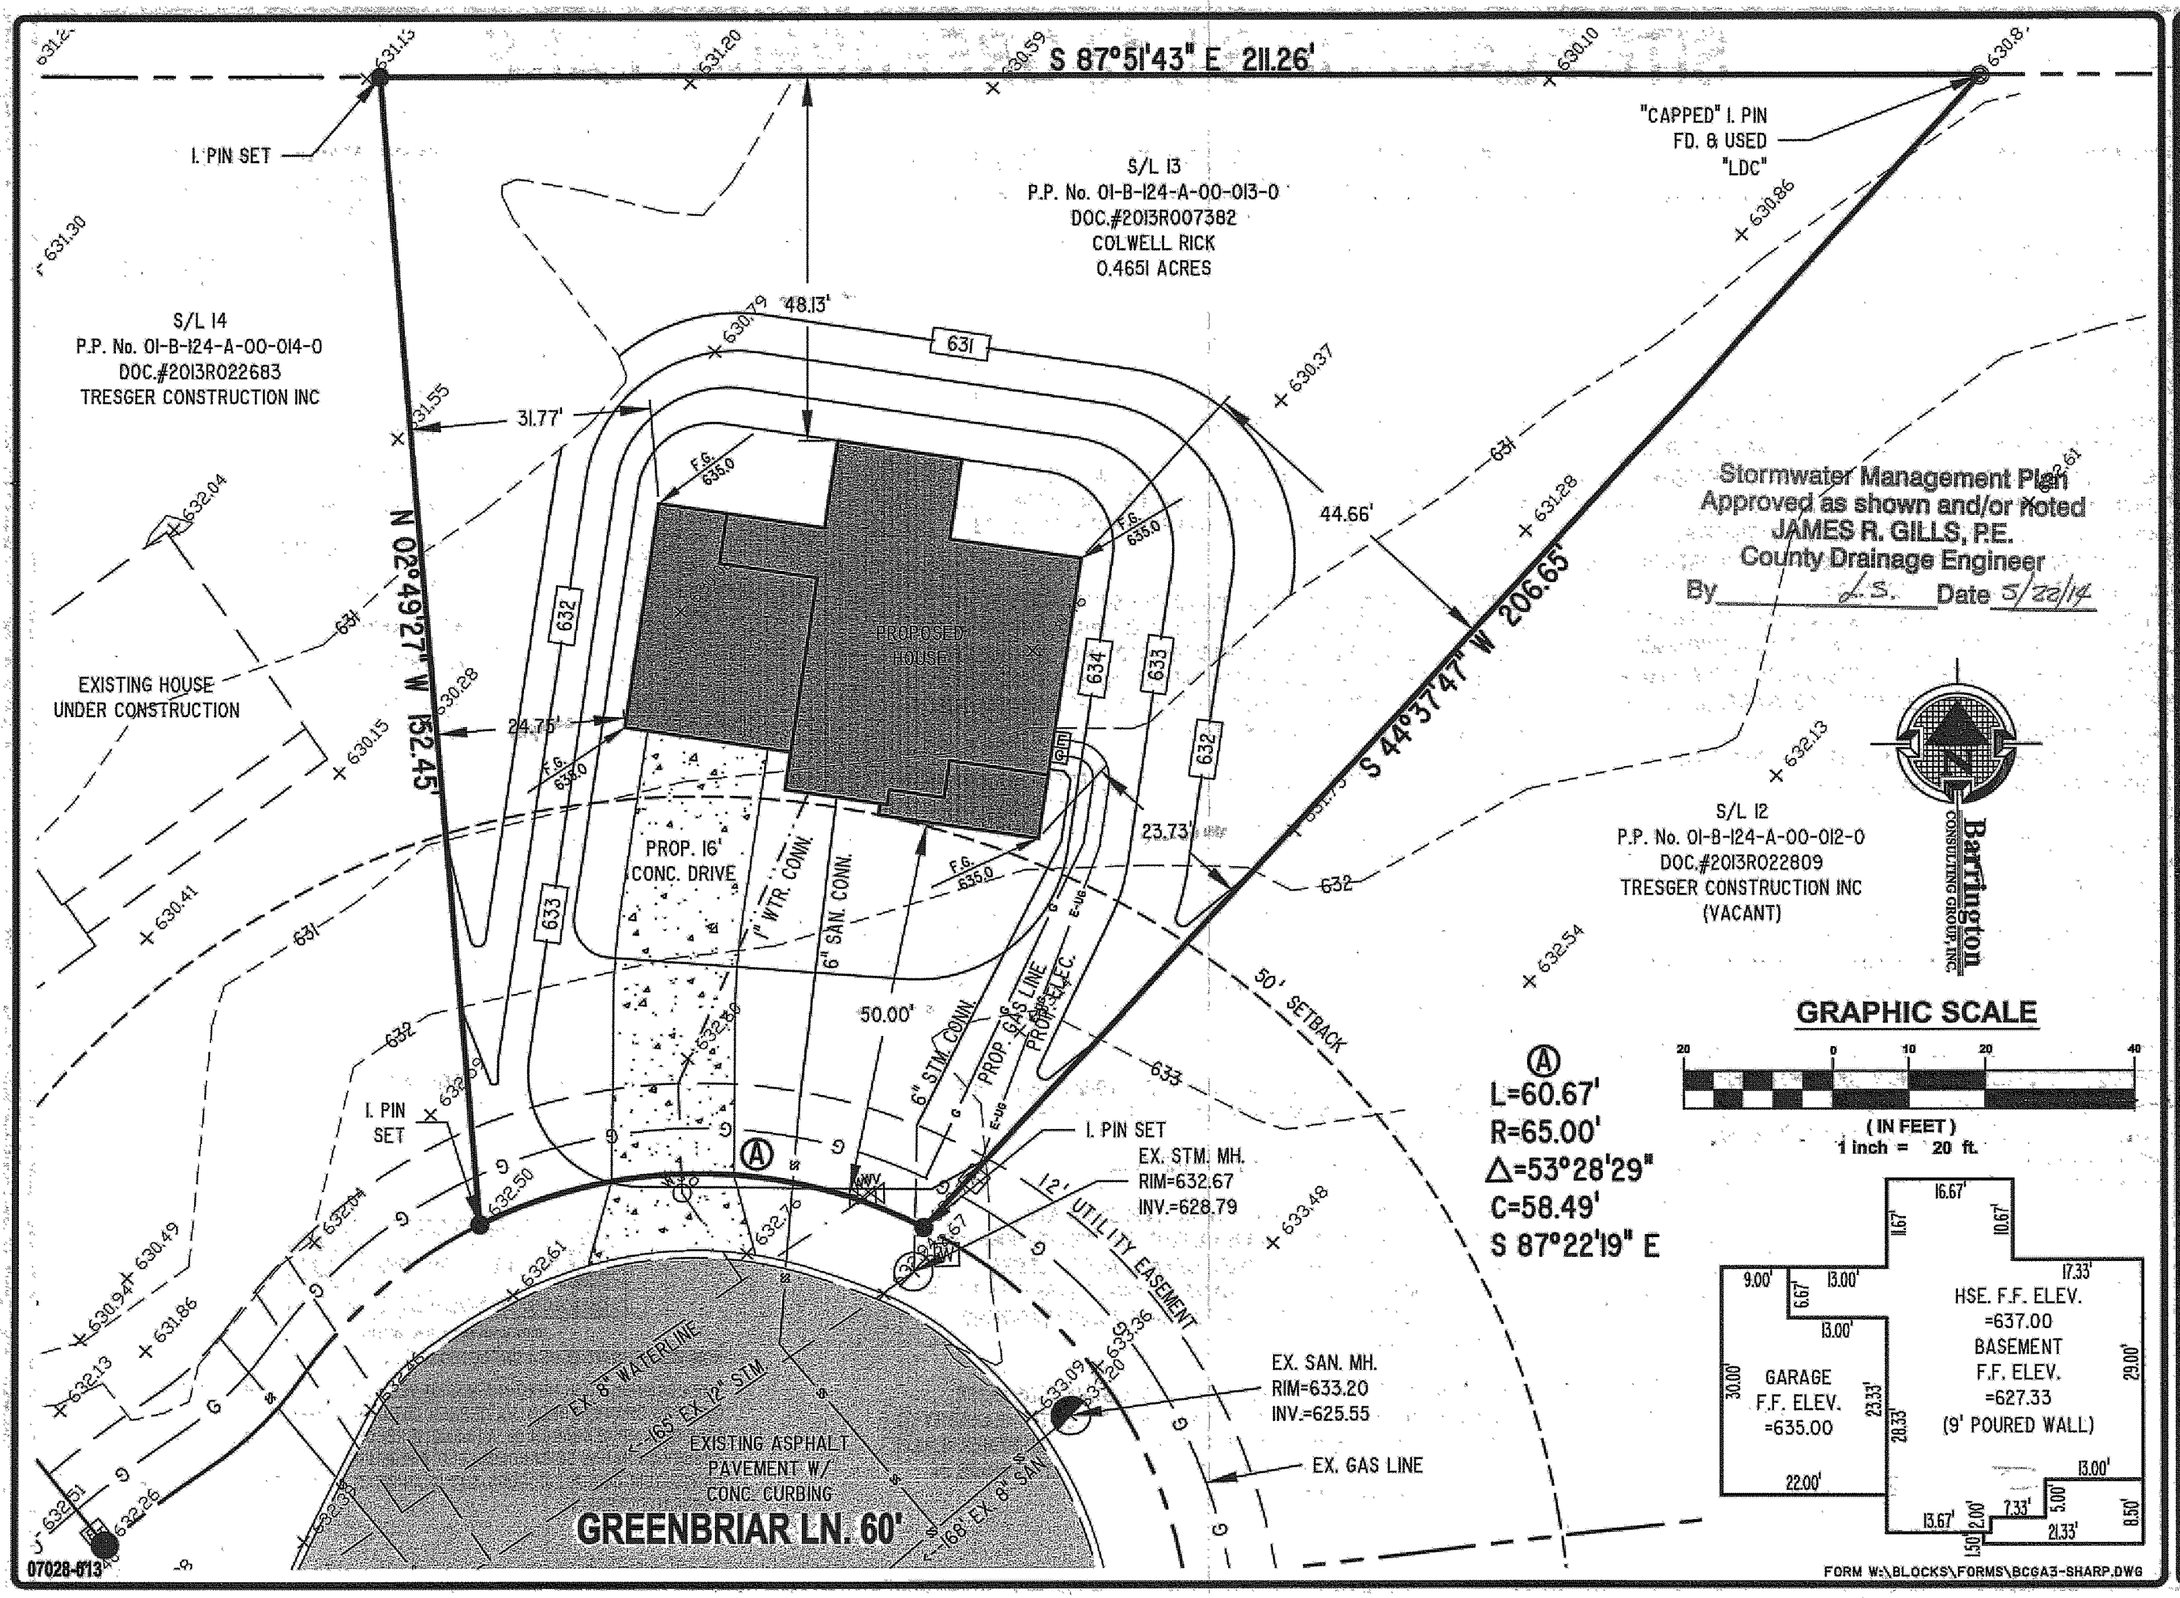

DRAWN	WSO
CHECKED	DWN
DATE	APR. 28, 2014
SCALE	1" = 20'
JOB NO.	07028-013
SHEET	2/3
OF	SHEETS

Civil Engineers - Surveyors - Land Planners

Barrington
CONSULTING GROUP, INC.
9114 TYLER BLVD., MENTOR, OHIO 44060
PHONE 440.205.1260 FAX 440.205.1262
www.BarringtonCGI.com