

for: IMA

2736 NORTH
ADDRESS

7 **WH**
SUBLOT No.


7 **4**
LOT TRACT

DE
THIS PLAT WAS PREPARED
BEST OF MY KNOWLEDGE

Timothy J. Sullivan
NAME

DRAWN BY **TJS** SCALE

BENCHMARK

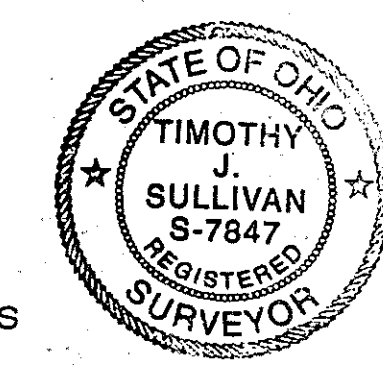

I, THE UNDERSIGNED,
TOPOGRAPHIC AND ELEVATION
SURVEYOR,
CERTIFY THAT THE
ACTUAL FIELD DATA
AND THAT INDICATED
ON THIS PLAT ARE
TRUE AND CORRECT.

Timothy J. Sullivan
TIMOTHY J. SULLIVAN

Remaining Lands
532,634 S.F.
12.2276 Ac.

P.P. # 01-B-124-0-00-034-0
Richmond Road Properties, LLC
Doc. #2005R035973

EXISTING UNDERGROUND UTILITIES NOT SHOWN
ON THIS PLAT. THE SIZE AND LOCATION BOTH HORIZONTAL AND VERTICAL
HEREON, HAVE BEEN OBTAINED BY A VISUAL SURVEY AND
DOES NOT GUARANTEE THE COMPLETENESS OF THE INFORMATION.