


Grading Plan Approved
as shown and/or noted
THOMAS B. GILLES, P.E.
Lake County Engineer

By J.W.K. Date 10-2-73

APPROVED
MADISON TWP. ZONING
Permit: 8968
Zoning Inspector: [Signature]

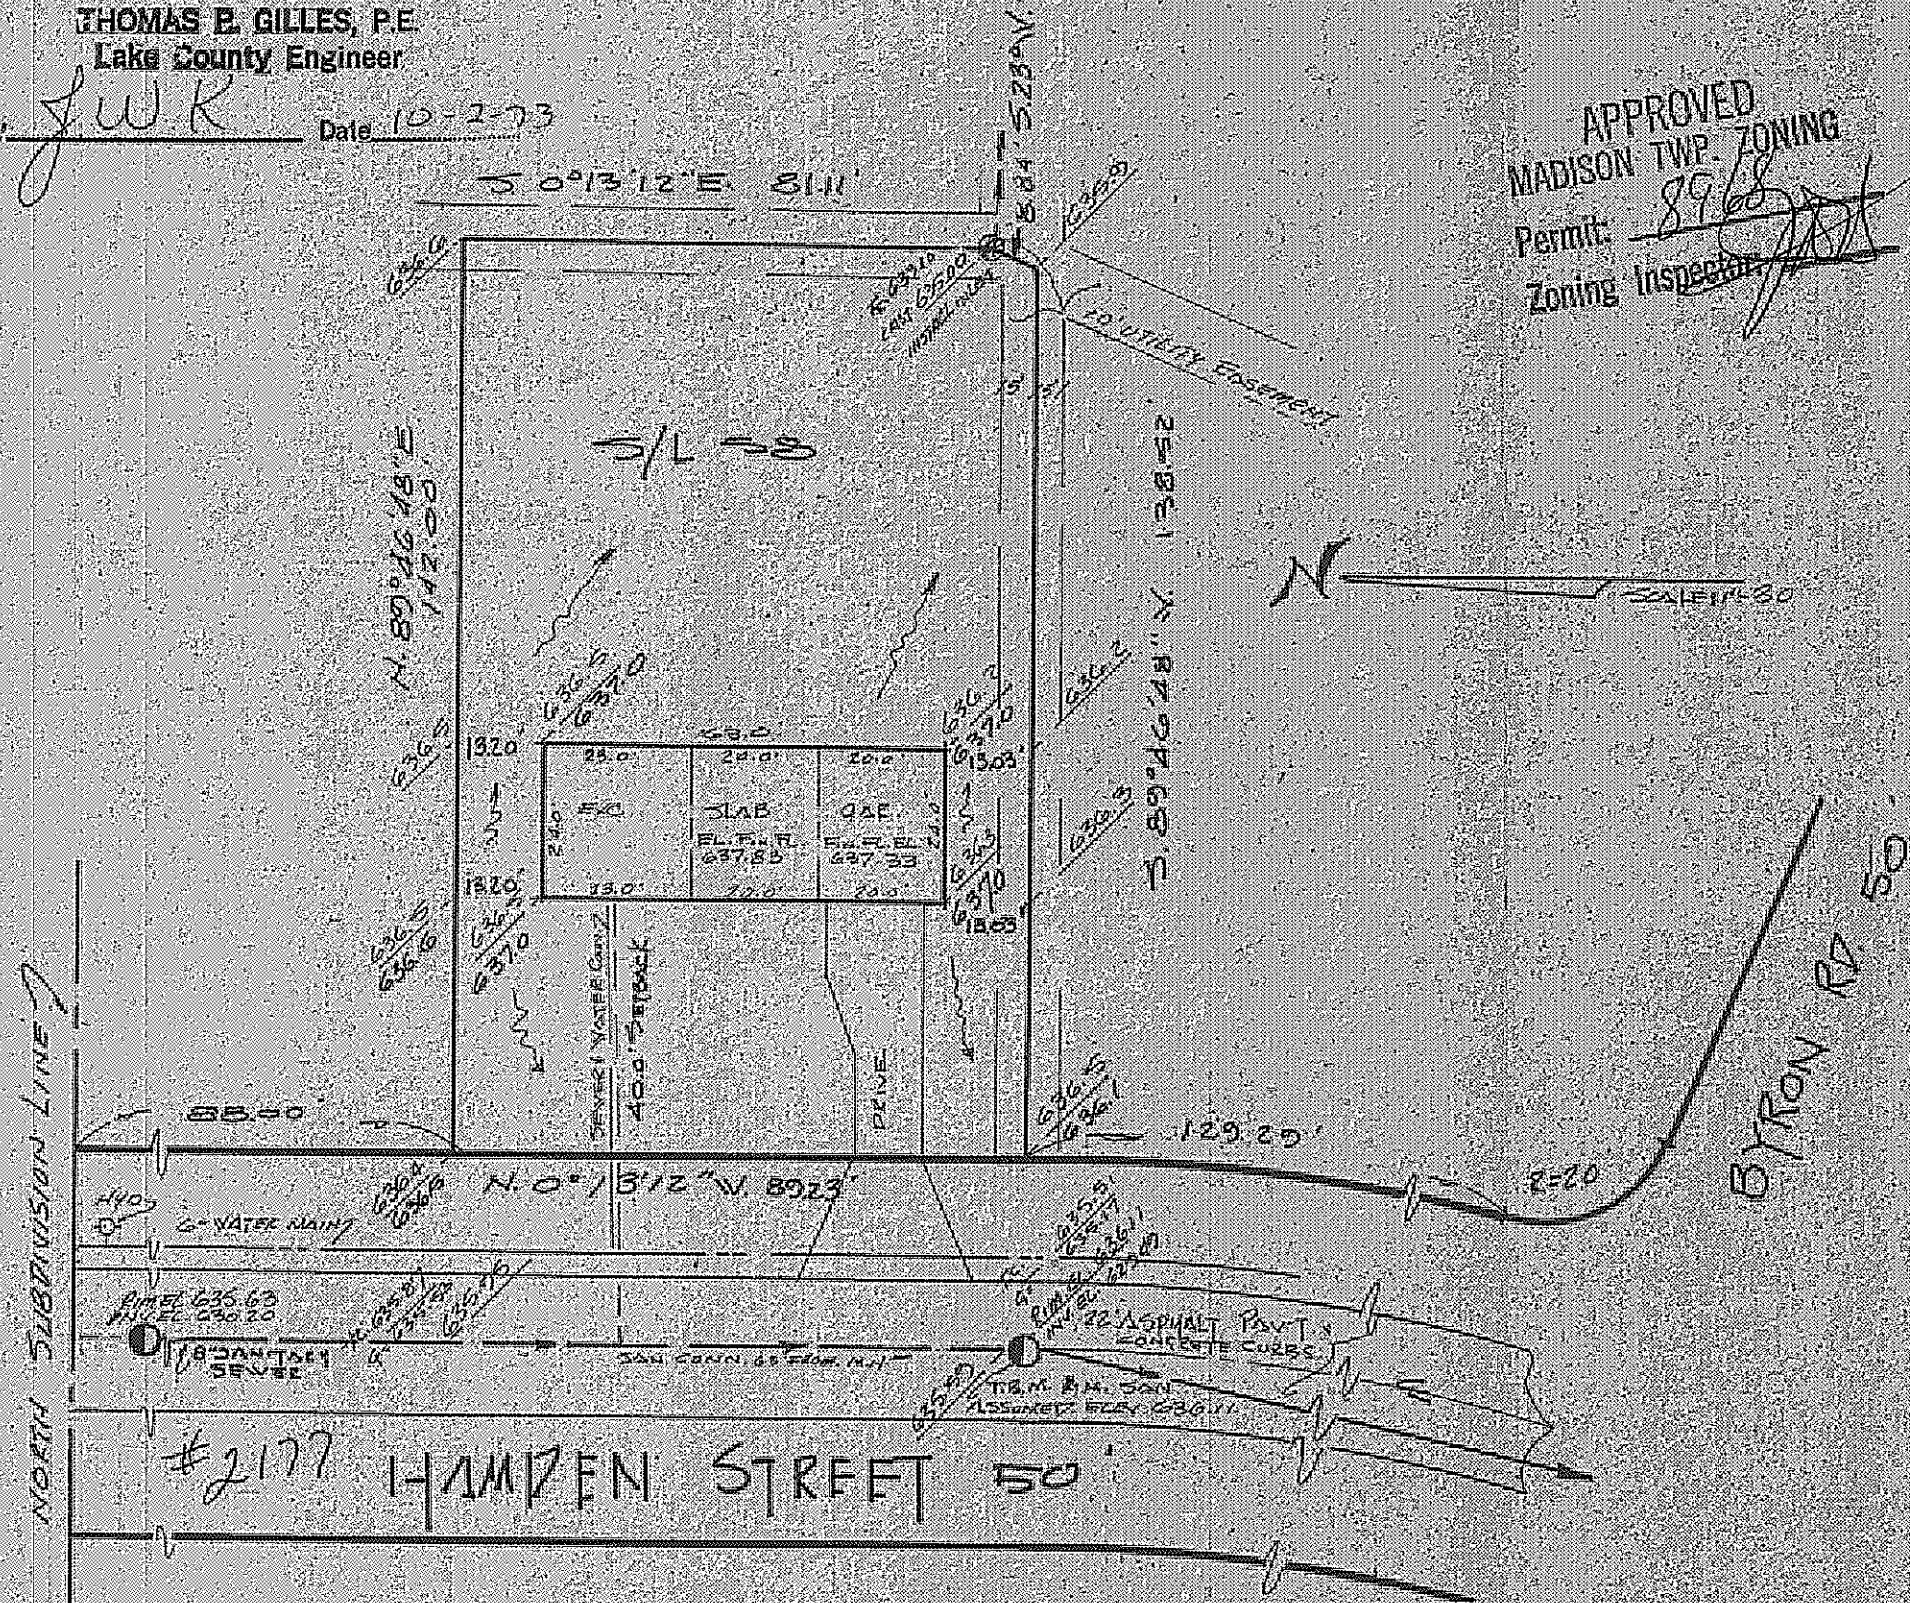

SITE PLAN

MADISON LAKE COUNTY, OHIO

for HALLMARK BLOKS

ADDRESS	STREET	CITY	ZIP
CHAPPL GROVE SBD			
SUBDIVISION	NAME	LOT	TRACT
58	HAMPDEN ST		
SUBJECT NO.	STREET	VOLUME	PAGE
		PERM. PARCELS	STREET

LEGEND

SANITARY MANHOLE	WATER VALVE (GAS)
STORM MANHOLE	WATER METER (GAS)
INLET OR CATCH BASIN	AS BUILT ELEVATION
HYDRANT	INDICATES DIRECTION OF SURFACE DRAINAGE
EXISTING CONTOUR	
PROPOSED CONTOUR	
EXIST. ELEV. 100.0	
PROPOSED ELEV. 100.0	

REMARKS

ALL BOUNDARY DATA SHOWN WAS OBTAINED FROM DEEDS RECORDED SUBDIVISION PLAT OR OTHER PUBLIC RECORDS

DESIGN CERTIFICATION

THIS PLAT WAS PREPARED BY ME, AND IS CORRECT TO THE BEST OF MY KNOWLEDGE AND BELIEF
NAME [Signature] SURVEYOR REGISTRATION NO. #5244

CHECK LIST

DIMENSIONS	WATER MAIN SIZE LOCATION
BEARINGS	SAN SEWER SIZE % GR LOC
TIE TO NEAREST STREET	SAN MH CAST ELEV INV ELEV
SUBLOT NO PARCEL NO	SAN CONN SIZE LOC DEPTH
SURROUNDING OWNERS	STORM SEWER SIZE % GR LOC
BDDG DIMENSIONS FIN GR	STORM MH CAST ELEV INV ELEV
BDDG TIES FLR GRADES	PAYT TYPE GRADE CURBS
APRON TYPE WIDTH THICKNESS	GASLINE LOC SIZE PRESSURE
SIDEWALK TYPE WIDTH THICKNESS	SEPTIC TANK SIZE LOC
CULVERT TYPE DIA LENGTH	WELL LOCATION

REVISIONS

NO	DATE	BY
1		
2		
3		
4		
5		

PLAN PREPARED BY

DEBEVEC-SALO & ASSOC, INC
NAME [Signature]
ADDRESS 130 EAST JACKSON ST, PAINESVILLE
DRAWN BY S. G.B. SCALE 1" = 30' PHONE NO. 3609-58
CHKD [Signature] DATE 30 Oct 73 DRAWING NO.
CREW CHIEF [Signature] APP'D [Signature]

"AS BUILT" CERTIFICATION

I HEREBY CERTIFY THAT THE CIRCLED GRADES ARE EXISTING FINISH GRADES CHECKED IN FIELD ON 19 BY [Signature] SURVEYING AND ARE CORRECT TO THE BEST OF MY KNOWLEDGE AND BELIEF

REGISTERED SURVEYOR REG NO