# SITE PLAN
for
Pac Homes

Sublots 573 & 574, Madison Lakeland Subd.
Madison Twp., Lake Co., Ohio
Aug., 1978 1" = 20'

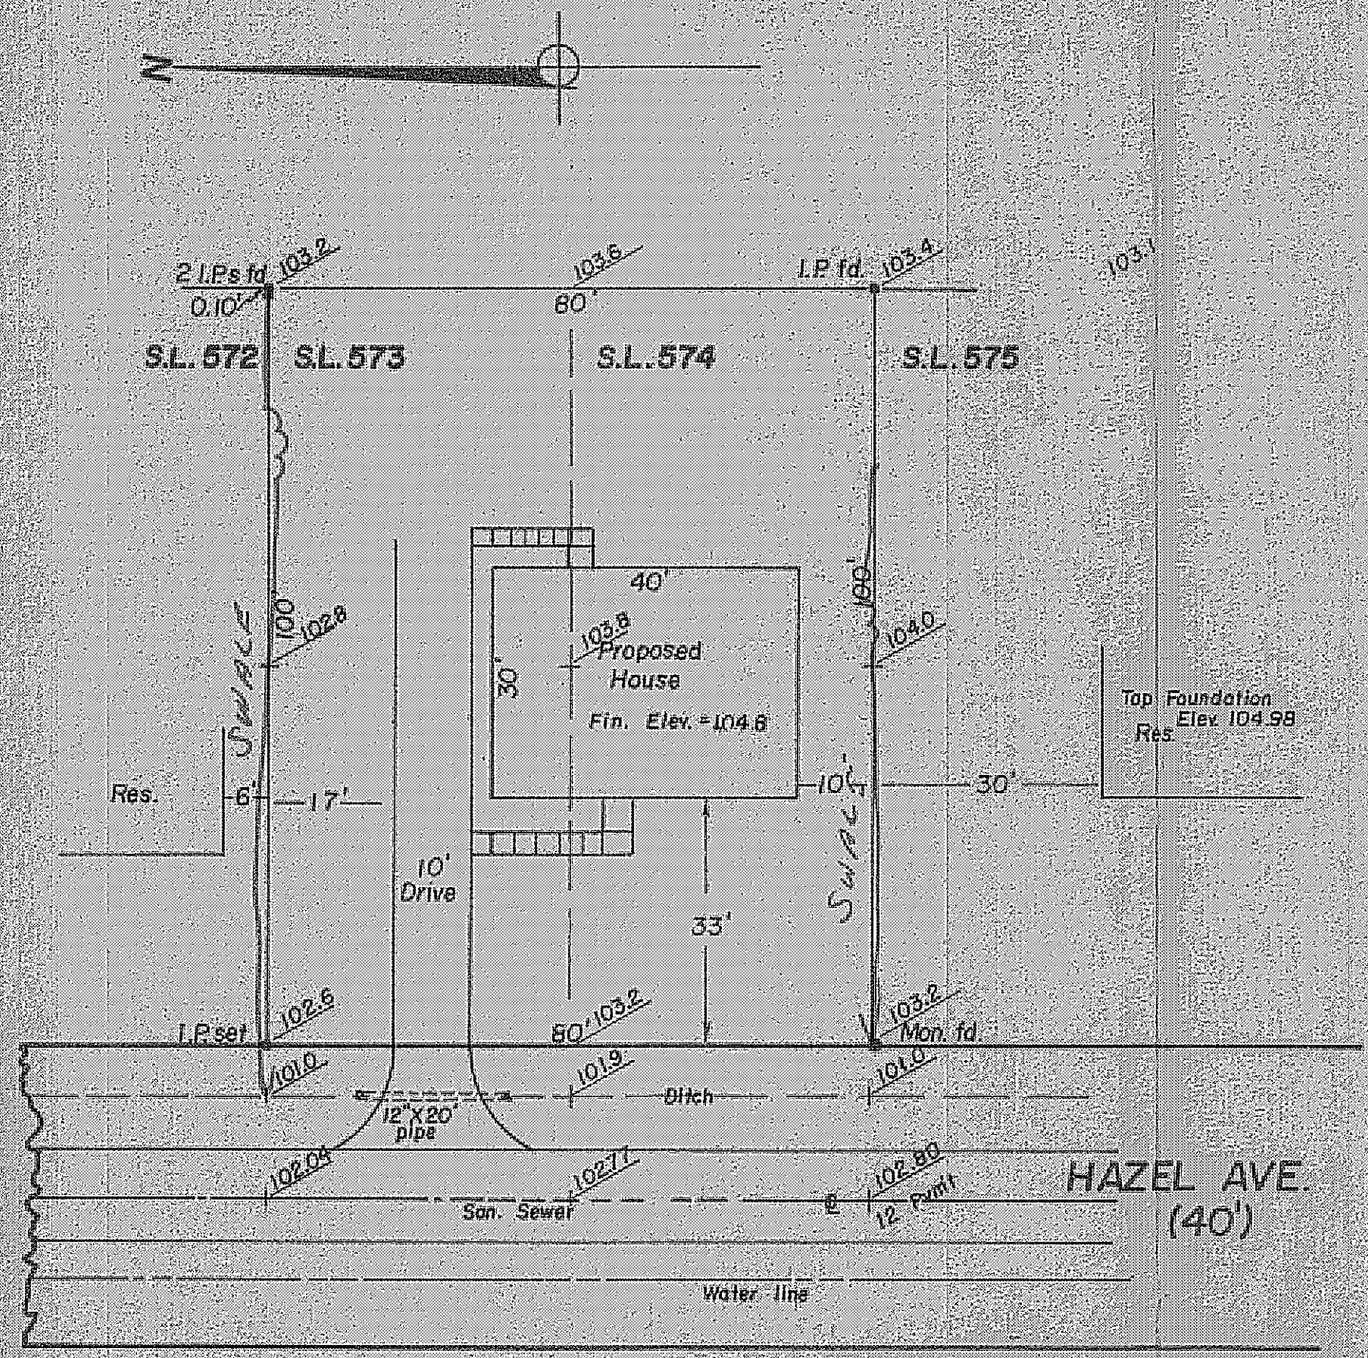


B.M. Top of San. M.H.
15' S. of S.P.L. S.L. 569
Elev. = 100.00
Inv. = 93.43

Grading Plan Approved
as shown and/or noted
THOMAS P. GILLES, P.E.
Lake County Engineer
By _____ Date 10 6 78
Zoning # 10044

STATE OF OHIO
THOMAS
GROMLEY
4848
REGISTERED
SURVEYOR

Thomas L. Gromley & Assoc.
Jefferson, Ohio