


CHAPEL ROAD 50' R/W

GRAPHIC SCALE

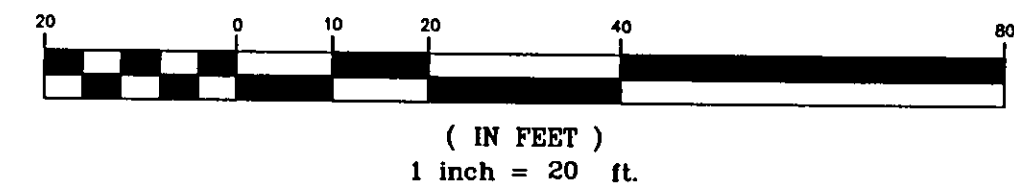

HERITAGE AVENUE

SAN. MH.
RIM 626.0
INV. 617.20

PATRICIA A. WELCH
VOL. 563 PG. 539

PATRICIA A. WELCH
VOL. 563 PG. 537
PP#1B-129-028

BENCHMARK
EX. SAN. MH.
RIM 623.00
INV. 616.20

Grading Plan Approved
as shown and/or noted
JAMES R. GILLS, P.E.
Lake County Engineer

By JAM Date 7/3/01

1. A permit will be required for utility work within R/W.
2. Roadside Slope must be maintained

ROOF DRAINS
SHALL DISCHARGE
TO SPLASH BLOCKS.

- NOTES : 1. The Contractor Shall Verify the Following Before Starting:
Finish Floor Elevations and House Size
Location and elevation of existing utility connections.
2. Contractor Shall Contact OUPS at least 2 Working Days prior to construction, 1-800-362-2764.

"I, the undersigned hereby certify that this topography, indicated by 1' contours and elevations shown hereon represents an actual field survey made by me in June, 2001 and that the elevations were taken at appropriate intervals and that as of that date they existed as indicated hereon."

David A. Rapp 6/28/01
David A. Rapp Reg. No.

APPROVED
MADISON TOWNSHIP ZONING
DATE 6/28/01
BY HL 20574



COR Consultants, Inc.

23 S. Forest Street Geneva, Ohio 44041
440-466-8085

DATE: MAY, 2001
DRAWN BY: DAR
CHECKED BY: RMO
APPROVED BY: DAR
P.S. No. 7597

DAVID WELCH
HAINES ROAD
MADISON TOWNSHIP

SITE PLAN

Hor. Scale 1" = 20'	Vert. Scale
21066	
SHEET No. 1	OF 1