

SITE PLAN

FOR

GLENN GNAGY

BEING SUBLOTS No. 76, No. 93 AND No. 94
IN THE MADISON LAKELANDS SUBDIVISION,
IN THE TOWNSHIP OF MADISON,
COUNTY OF LAKE, STATE OF OHIO

*NOTE: BEARINGS PER RECORD DEED
& MONUMENTATION FOUND

NOTE: All lots Irma H. and Leslie K. Gnagy
Vol 397-371 & Vol 383-628 unless otherwise noted.

APPROVED
MADISON TOWNSHIP ZONING

DATE 8/6/98
BY WA 15919

L.E. & E.F. MAY
Vol 187-P. 28

Grading Plan Approved
as shown and/or noted
THOMAS P. GILLES, P.E.
Lake County Engineer


By WH Date 8.2.98
12" Drive Culvert

N
1" = 20'

EXIST
PROP
EXIST
PROP

I, the undersigned hereby certify this
topography, indicated by 1' contours,
and elevations shown hereon represent
an actual field survey by me on 2-27-98
and that the were taken at appropriate
intervals and that as of that date they
existed as indicated hereon.

J.M. Coffman P.E.
No 6857

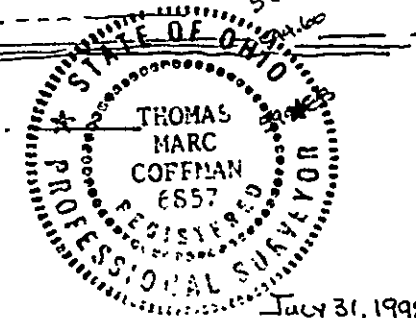

VILLAGE SURVEYING CO.

P.O. BOX 1096, FAIRPORT HARBOR, OH 44077
(216) 357-1359

