CRABBS' SURVEYING SERVICE
WESTERN RESERVE BUILDING
70 NORTH ST. CLAIR STREET SUITE 300
PAINESVILLE, OHIO 44077
PHONE: (216) 357-5941
FAX: (216) 357-1816
1-800-488-3968

SURVEY SITE PLAN FOR

FOR SUBLOT 592 IN THE MADISON-LAKELAND SUBDV. NO. 2. TOWNSHIP OF MADISON. LAKE COUNTY . OHIO PLAT VOL. D PAGE 27

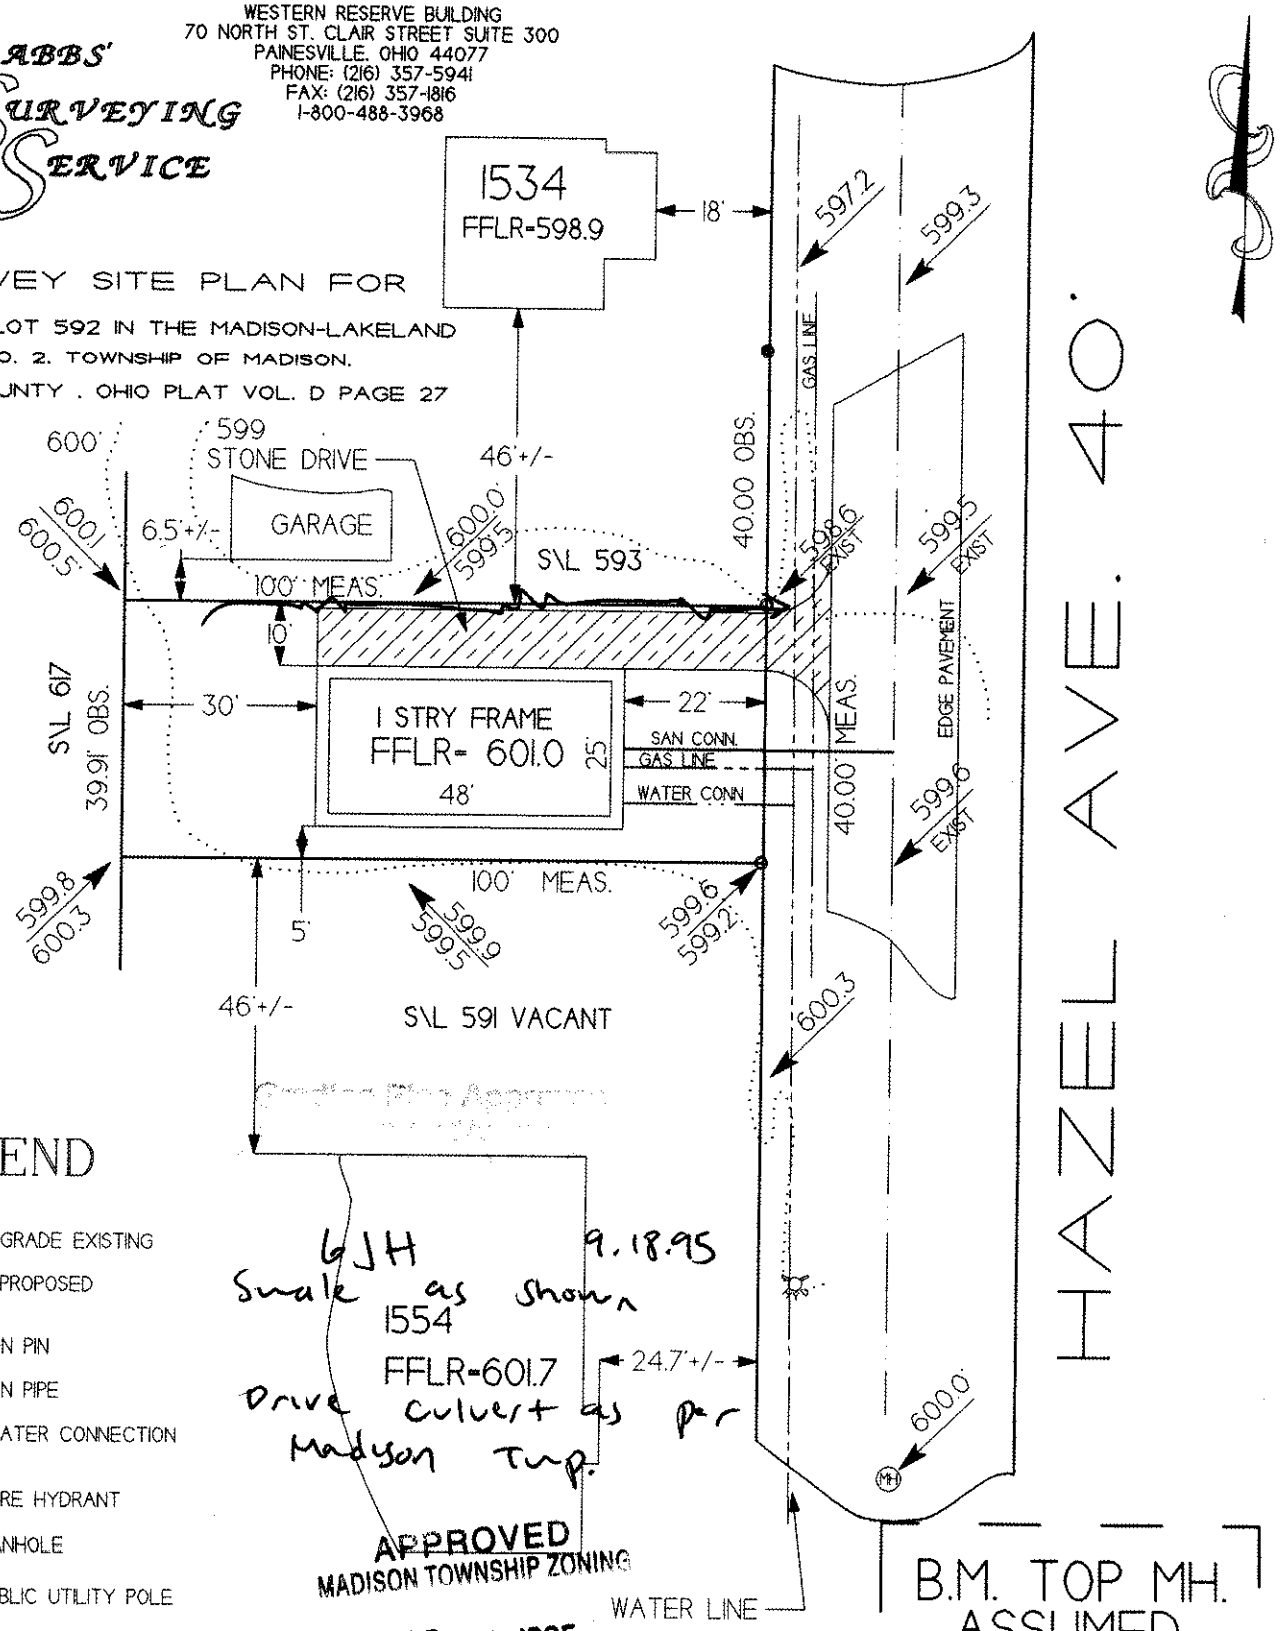

GJH 9.18.95
Swale as shown
Drive culvert as per Madison Twp.

APPROVED
MADISON TOWNSHIP ZONING
APR 11 1995
PERMIT # 14504
ZONING INSPECTOR

LEGEND

- EXIST / PROP — GRADE EXISTING / PROPOSED
- IRON PIN
- IRON PIPE
- WATER CONNECTION
- FIRE HYDRANT
- MANHOLE
- PUBLIC UTILITY POLE

15 0 15 30 60
1" = 30'

COPYRIGHT 1995 CRABBS' SURVEYING SERVICE

THIS PROPERTY SURVEY IS PURSUANT TO CHAPTER 4733-37 OF THE OHIO ADMINISTRATIVE CODE.

JOB 1239PLOT.GCD