
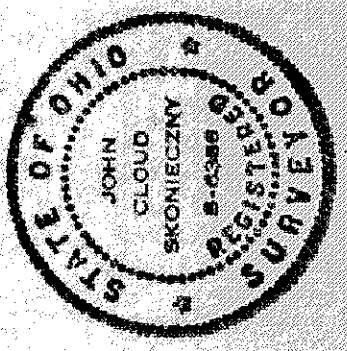


NORTH

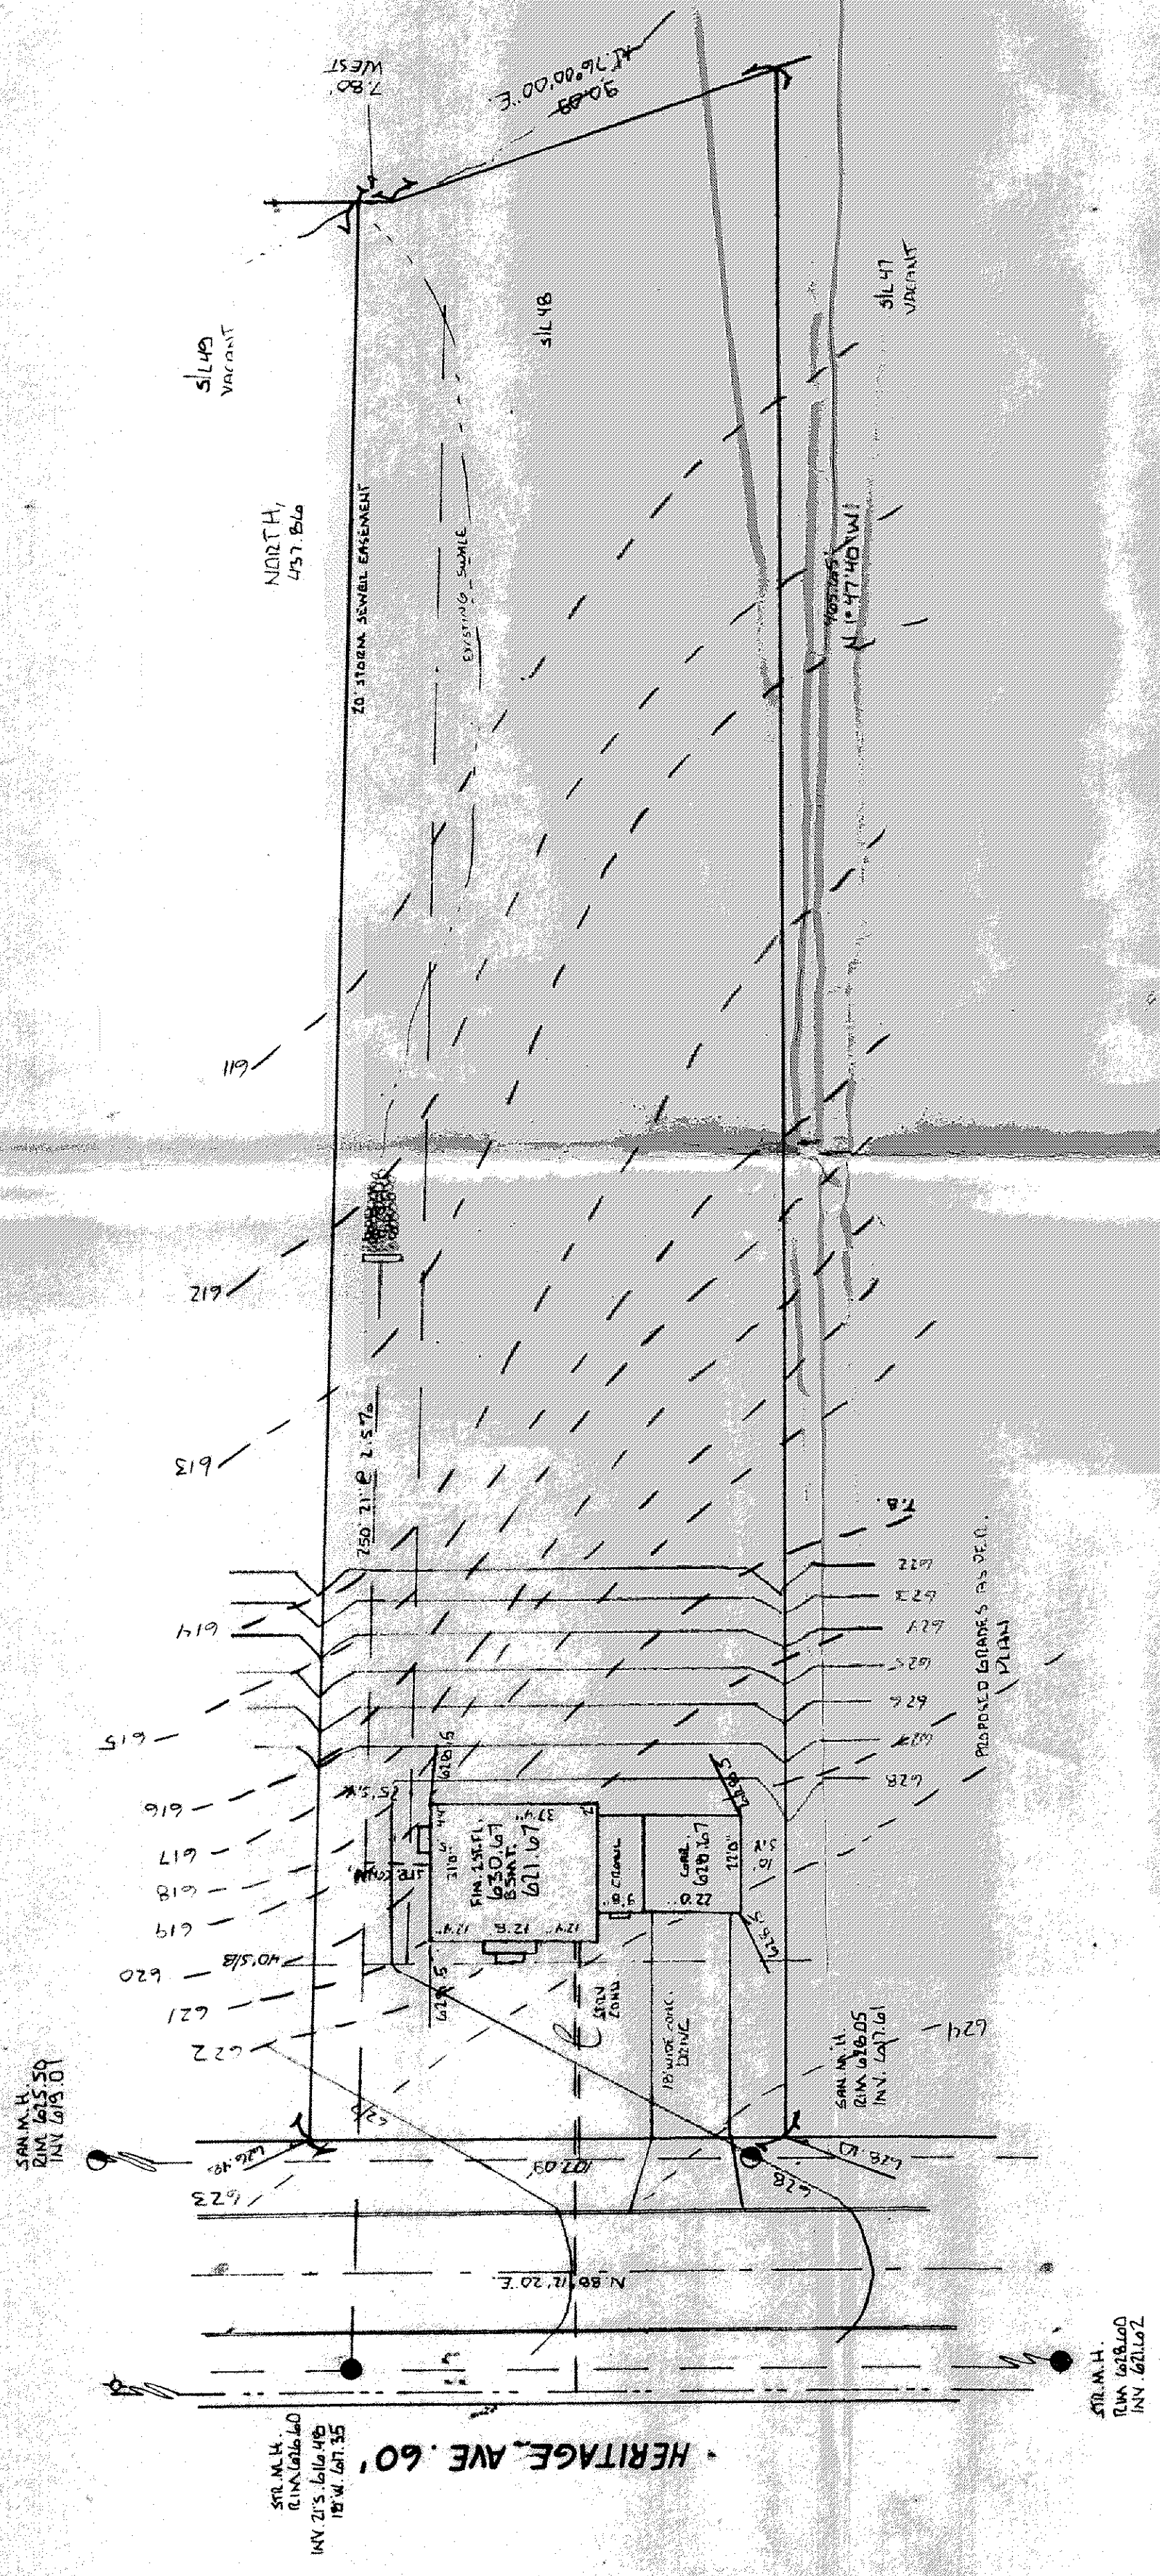

I CERTIFY THAT THIS PLAN
WAS PREPARED BY ME AND
IS CORRECT TO THE BEST OF
MY KNOWLEDGE AND BELIEF

John C. Skonieczny
REG. SURVEYOR #6355

JOHN C. SKONECZNY
7739 VIEWMOUNT DR.
PAINESVILLE, OHIO 44077
PH. 352-7742

EXISTING GRADES
PROPOSED GRADES
WATER

SITE PLAN FOR:
SIMMONS HOMES

SCALE: 1" = 30'	APPROVED BY	DRAWN BY F.J.H.
DATE: JULY 92		
BEING SUBLT 48 IN THE HERITAGE HILL ESTATES SUBDIVISION TOWNSHIP OF MADISON, LAKE COUNTY, OHIO		
DRAWING NUMBER 100 - 1047		

Grading Plan Approved
as shown and/or noted
THOMAS P. GILLES, P.E.
Lake County Engineer

By *G.H.* Date *7/21/92*
REAR PORTION OF LOT 15
WITHIN 100 YR FLOOD ZONE

APPROVED
MADISON TWP. ZONING
OFFICE
7/23/92