FOR

PAC HOMES INC.

SUBLOT NO. 4 & 5 HOMESTEAD ALLOTMENT
MADISON TOWNSHIP, LAKE COUNTY, OHIO

29 MAY 1991 SCALE 1" = 20 ft.

PLAT BK G PG 36

JIM PETER LAND SURVEY
4759 CROSBY-COOK RD.
ROME, OHIO 44085

STATE OF OHIO JAMES M. PETER REGISTERED SURVEYOR
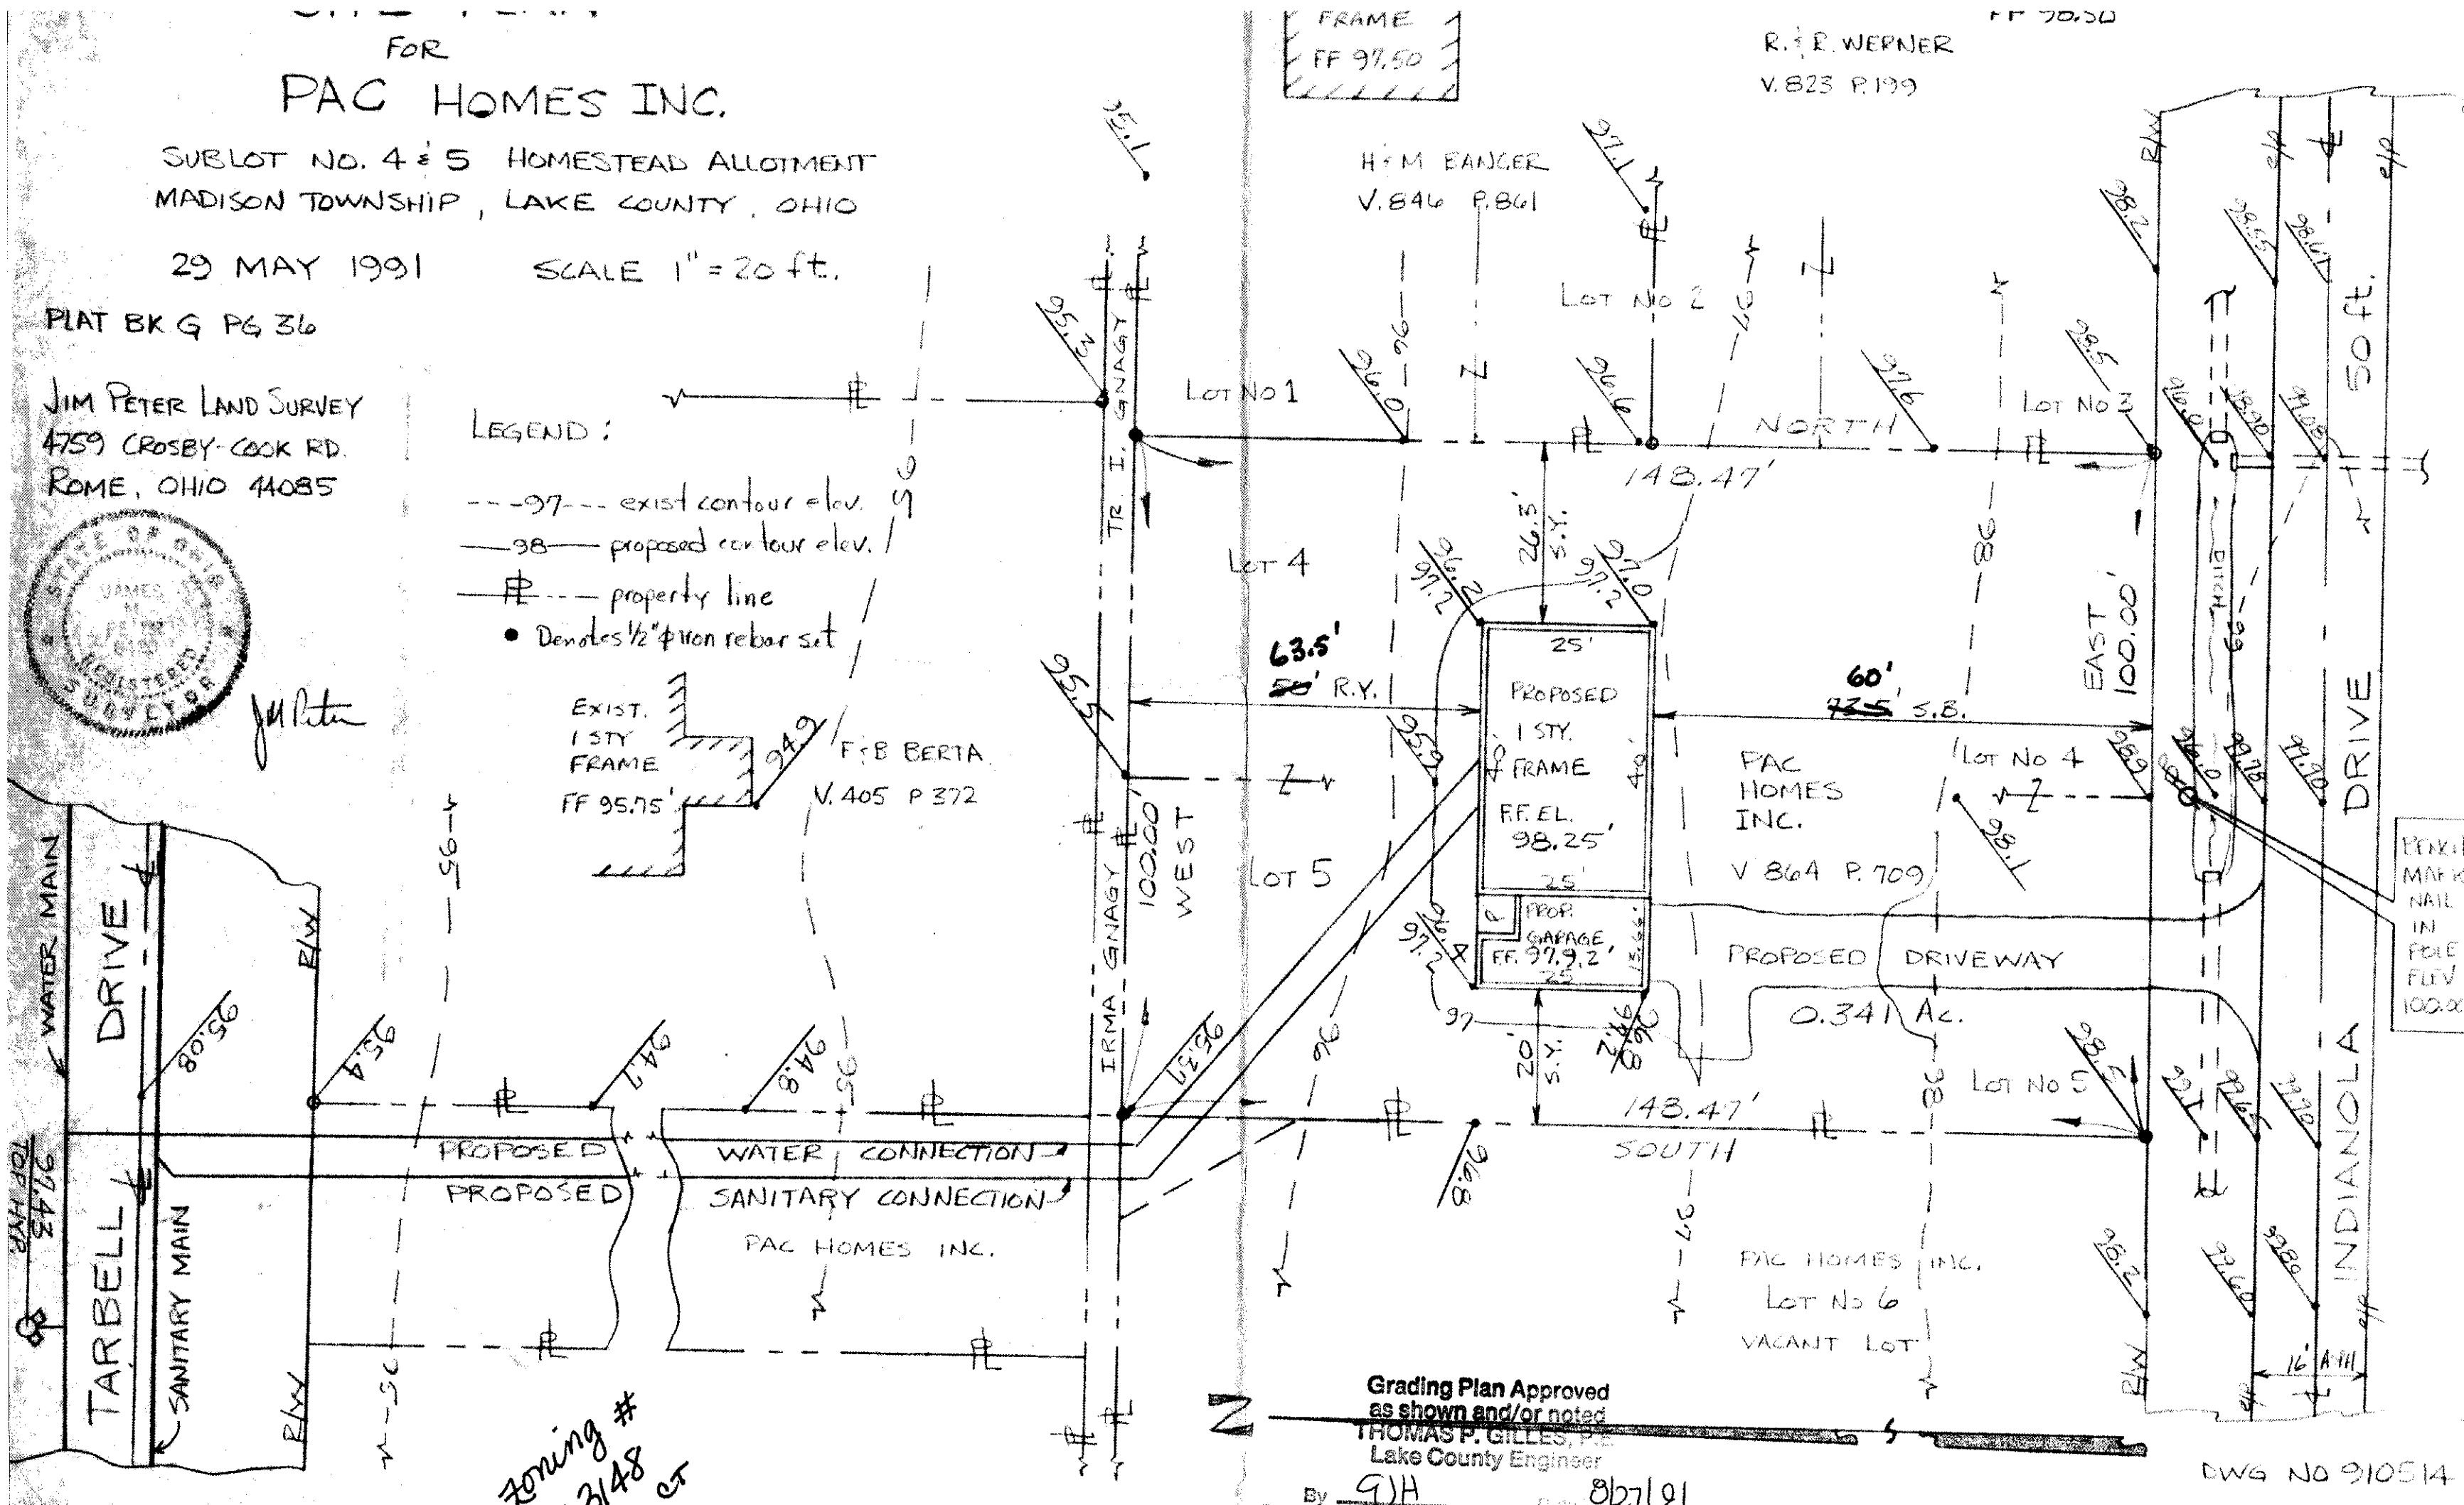
Jim Peter