


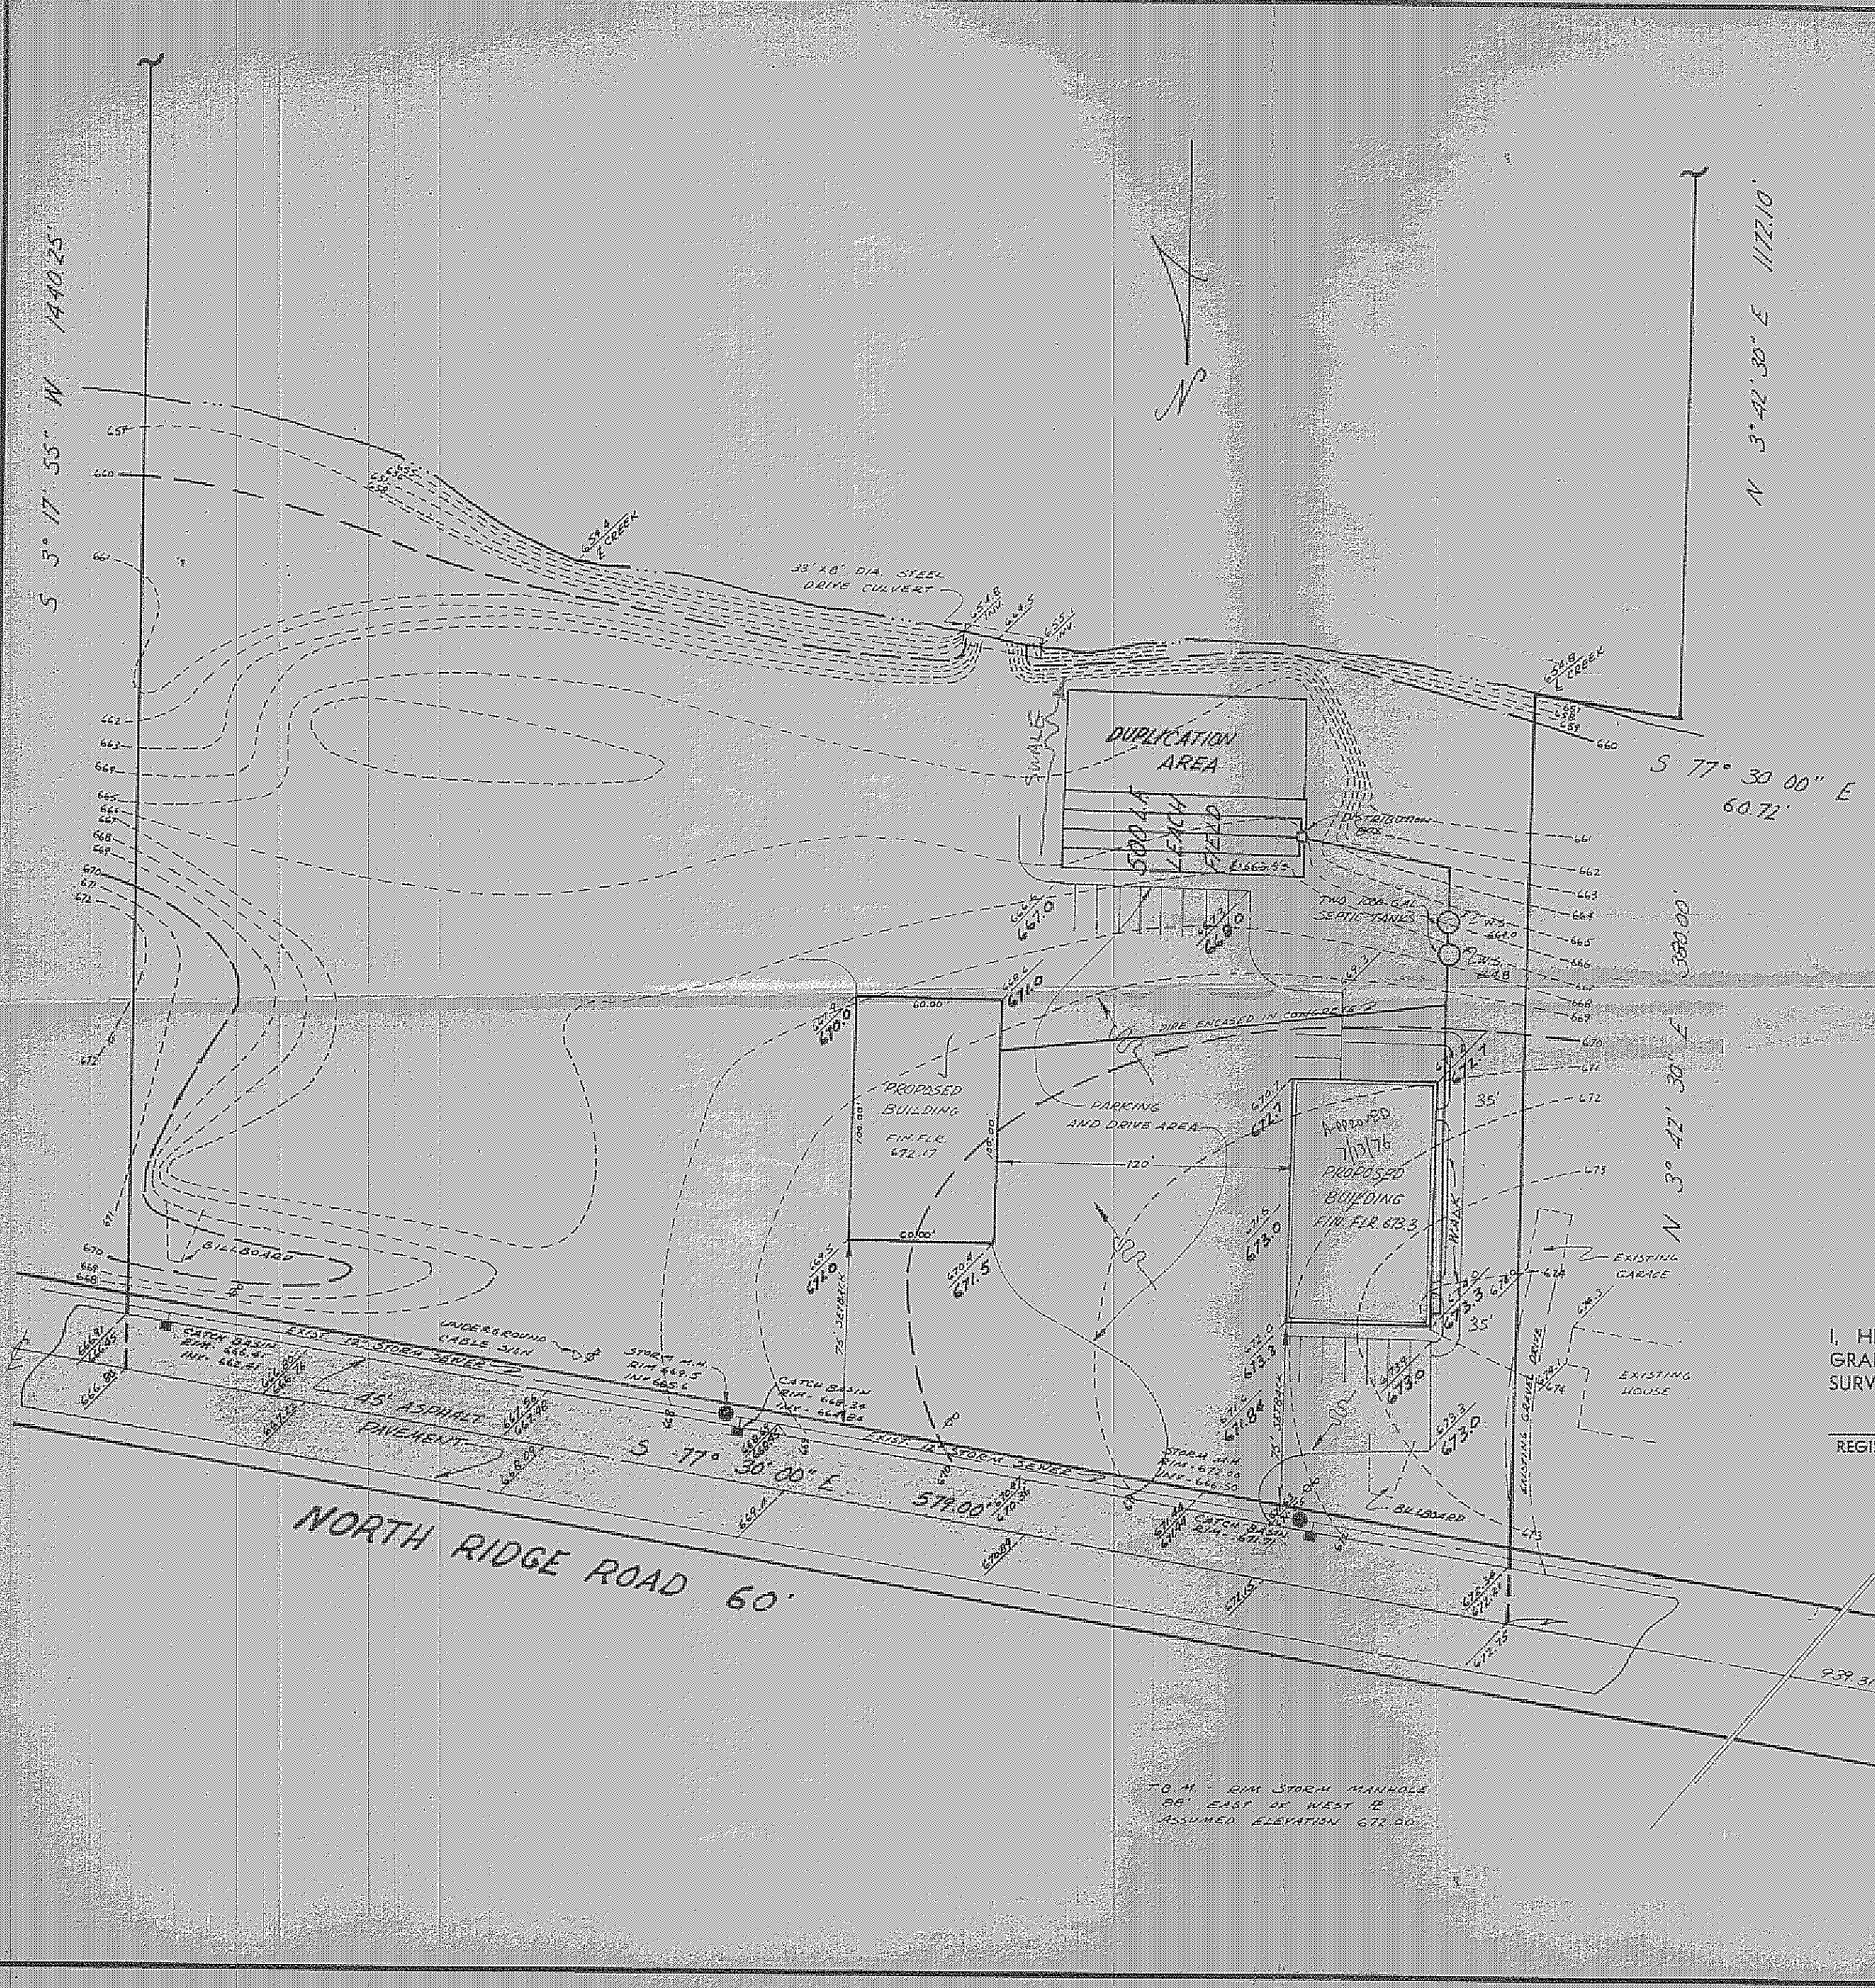

SITE PLAN

MADISON TOWNSHIP LAKE COUNTY, OHIO

for: **WALT ROLERS**
CLIENT OWNER

ADDRESS STREET CITY ZIP

SUBDIVISION	NAME	LOT	TRACT
VOL. 10	RD. 60	VOLUME	PAGE
SUBLOT NO.	NORTH RIDGE STREET	PERM. PARCEL NO.	STREET

LEGEND

SANITARY MANHOLE	---●---	WATER VALVE (GAS)	---●---
STORM MANHOLE	---●---	WATER METER (GAS)	---●---
INLET OR CATCH BASIN	---●---	AS BUILT ELEVATION	100.0
HYDRANT	---●---	INDICATES DIRECTION OF SURFACE DRAINAGE	100.0
EXISTING CONTOURS	---●---		
PROPOSED CONTOURS	---●---		
EXIST. ELEV.	100.0	PROP. ELEV.	100.0

REMARKS

ALL BOUNDARY DATA SHOWN WAS OBTAINED FROM (DEEDS, RECORDED SUBDIVISION PLAT OR OTHER PUBLIC RECORDS).
LOCATIONS AS SHOWN OF ADJACENT WELLS AND SEPTIC TANKS OBTAINED FROM LAKE COUNTY HEALTH DEPARTMENT

DESIGN CERTIFICATION

THIS PLAN WAS PREPARED BY ME, AND IS CORRECT TO THE BEST OF MY KNOWLEDGE AND BELIEF.

NAME SURVEYOR REGISTRATION NO.

CHECK LIST

NO. OF BEDROOMS	WATER MAIN SIZE, LOCATION
DIMENSIONS	SAN. SEWER SIZE % GR. LOC.
BEARINGS	SAN. MH. CAST ELEV. INV. ELEV.
TIE TO NEAREST STREET	SAN. CONN. SIZE, LOC. DEPTH
SUBLOT NO. PARCEL NO.	STORM SEWER SIZE % GR. LOC.
SURROUNDING OWNERS	STORM MH. CAST ELEV. INV. ELEV.
BDDG. DIMENSIONS, FIN. GR.	PAV'T TYPE GRADE CURBS
BDDG. TIES FLR. GRADES	GAS LINE LOC. SIZE PRESSURE
APRON TYPE WIDTH THICKNESS	SEPTIC TANK LOCATION & DUBLICATION AREA
SIDEWALK TYPE WIDTH THICKNESS	WELL LOCATION
CULVERT TYPE DIA. LENGTH	ISOLATION RADIUS FROM WELL
ROCK OUTCROPPINGS	

REVISIONS

NO.	DATE	BY
1		
2		
3		
4		
5		

PLAN PREPARED BY:

DEBEVEC-SALO & ASSOCIATES, INC.

PAINESVILLE, OHIO

DRAWN BY	SCALE	PHONE NO.
D. U.	1" = 50'	352-9250
CHK'D.	DATE	DRAWING NO.
	3-22-77	4949
CREW CHIEF	APP'D.	

"AS BUILT" CERTIFICATION

I, HEREBY CERTIFY THAT THE CIRCLED GRADES ARE EXISTING FINISH GRADES CHECKED IN FIELD ON 19 BY SURVEYING AND ARE CORRECT TO THE BEST OF MY KNOWLEDGE AND BELIEF.

REGISTERED SURVEYOR

REG. NO.

MAD. Twp. Zoning # 9923

Grading Plan Approved as shown and/or noted
THOMAS P. GILLES, P.E.
Lake County Engineer
By **DJL** Date **8/3/77**

BENNETT

RD. 60