
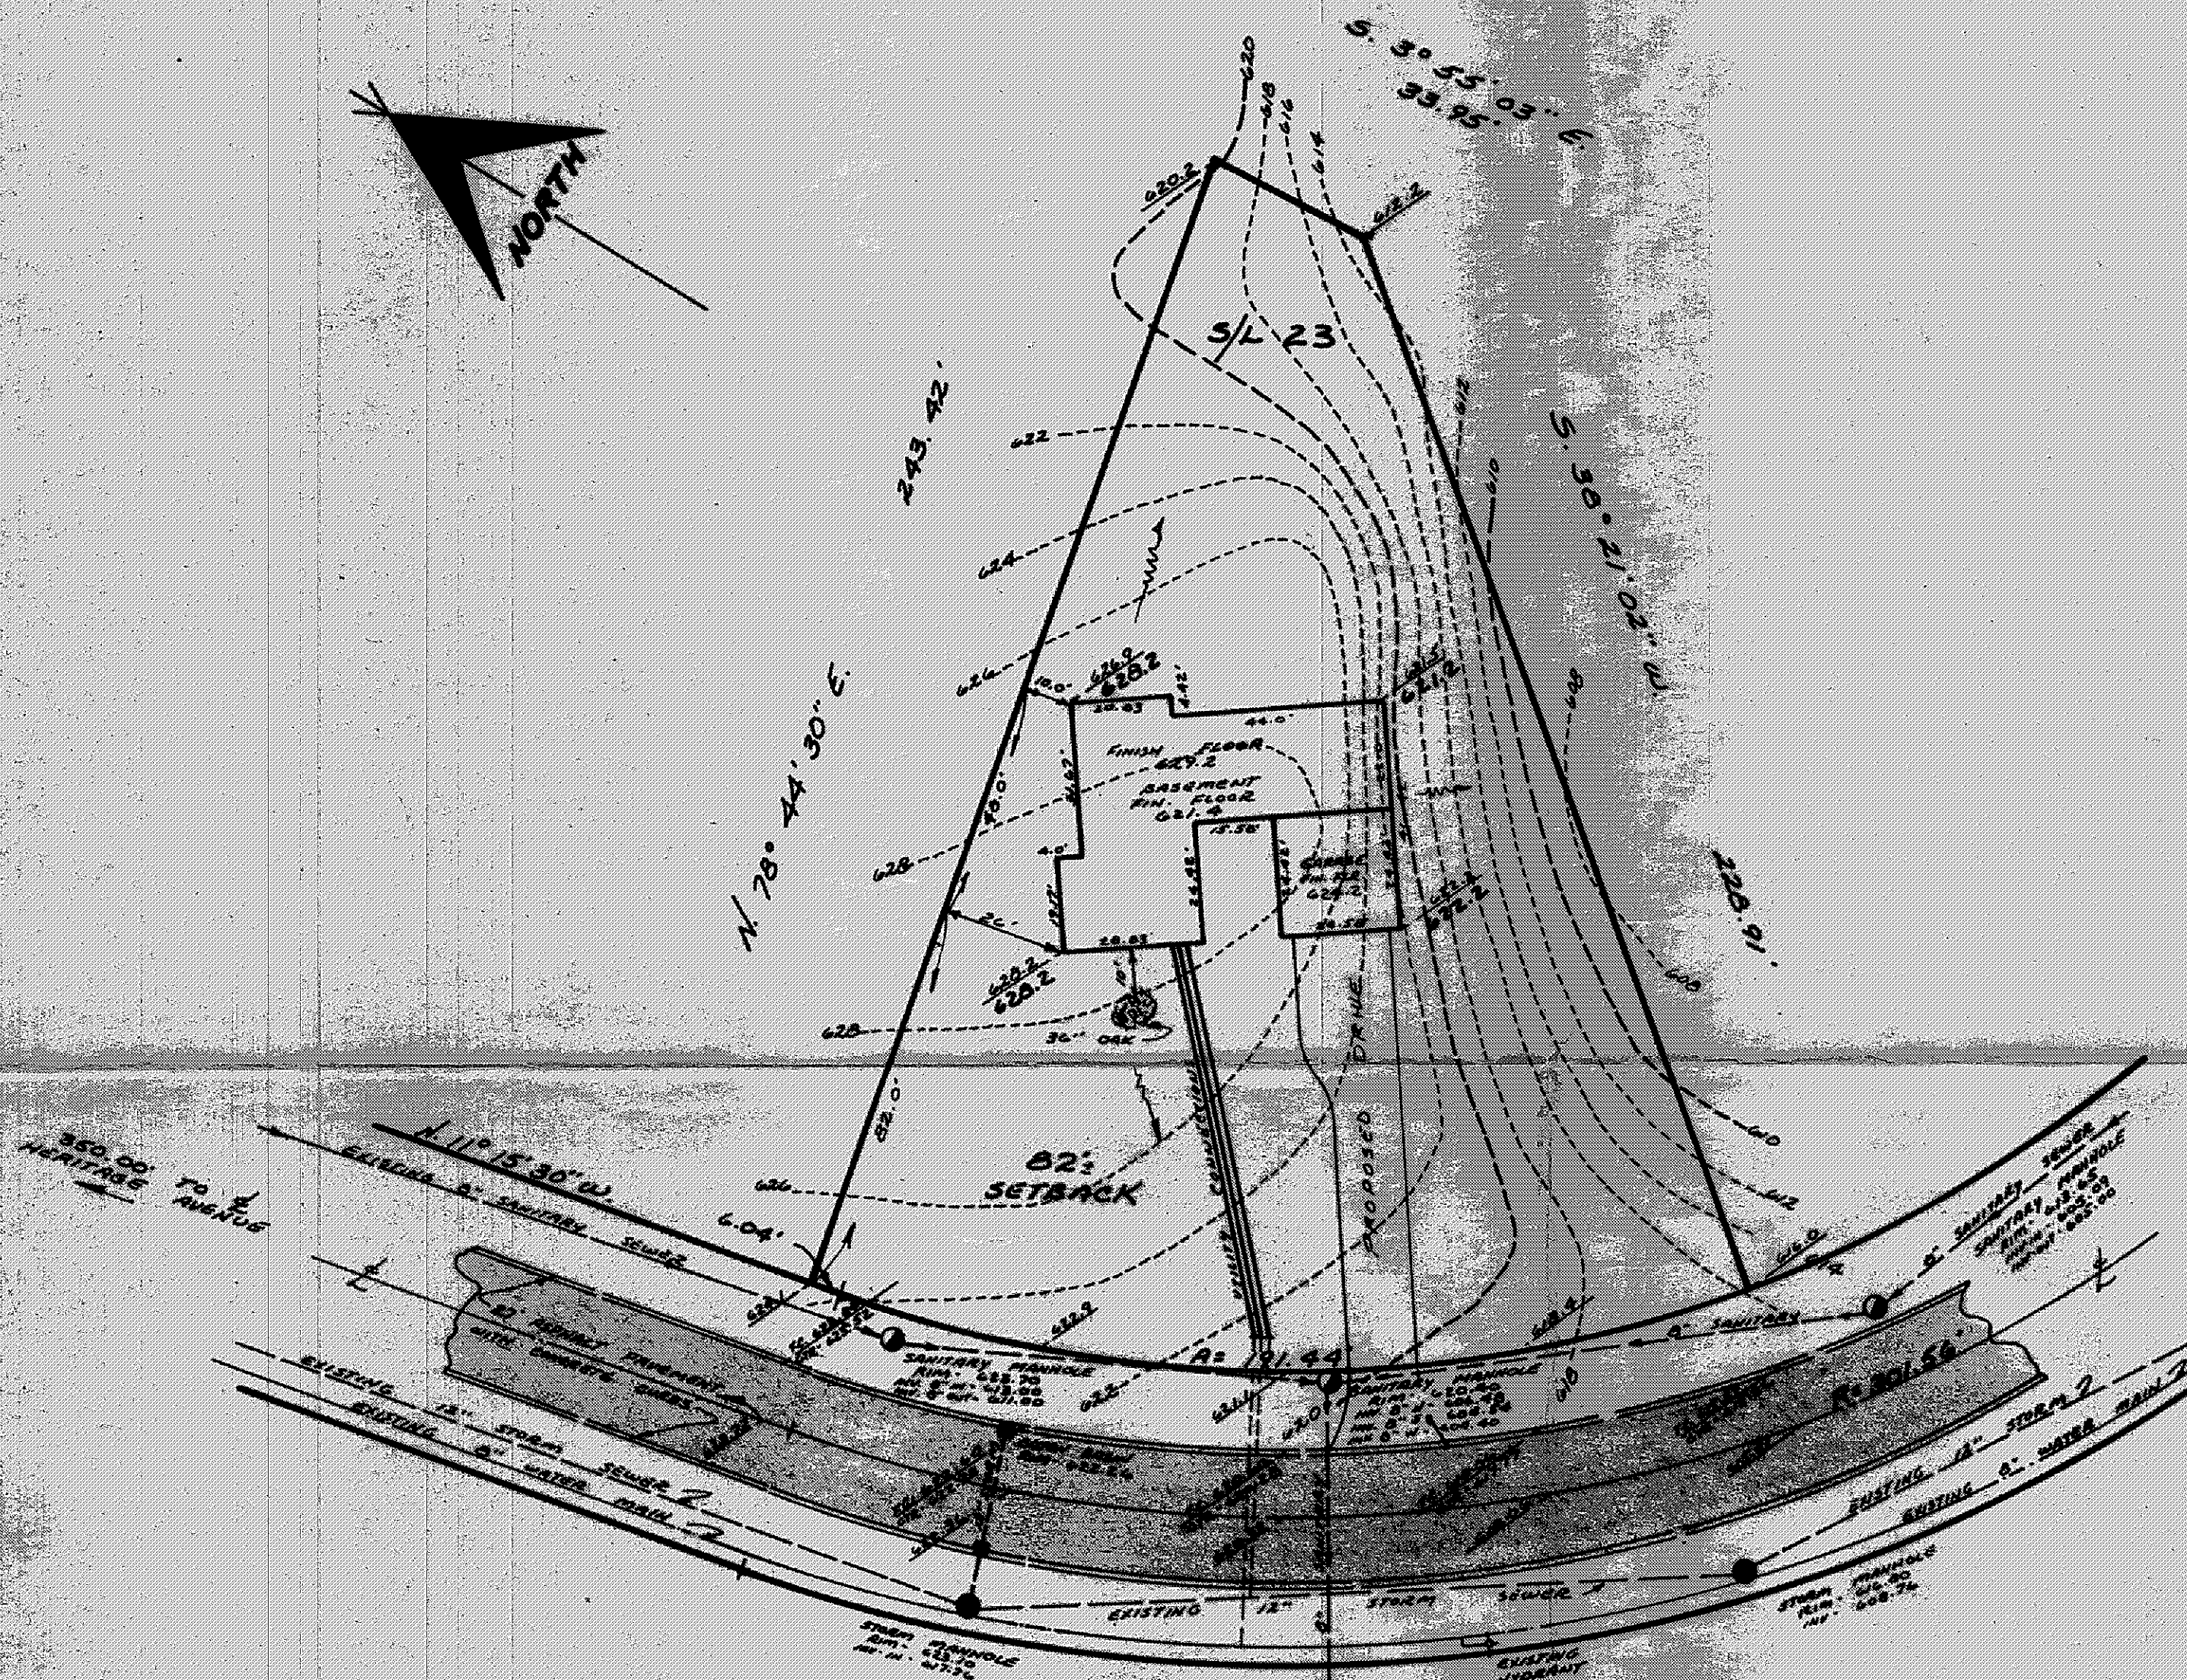


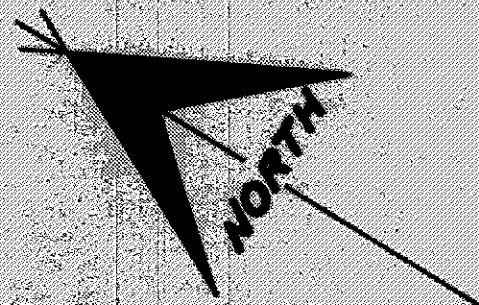

OLD MILL ROAD 60'

# SITE PLAN

MADISON TOWNSHIP LAKE COUNTY, OHIO

for: RAY ZIRKLE  
CLIENT OWNER

ADDRESS STREET CITY ZIP

|                       |                         |                  |        |
|-----------------------|-------------------------|------------------|--------|
| RAY ZIRKLE SUBD. N° 2 |                         | LOT              | TRACT  |
| SUBDIVISION           | NAME                    |                  |        |
| 23                    | VOL - PG. OLD MILL ROAD | VOLUME           | PAGE   |
| SUBLOT NO.            | STREET                  | PERM. PARCEL NO. | STREET |

## LEGEND

|                      |         |                                         |         |
|----------------------|---------|-----------------------------------------|---------|
| SANITARY MANHOLE     | ---○--- | WATER VALVE (GAS)                       | ---●--- |
| STORM MANHOLE        | ---●--- | WATER METER (GAS)                       | ---○--- |
| INLET OR CATCH BASIN | ---○--- | AS BUILT ELEVATION                      | 100.0   |
| HYDRANT              | ---○--- | INDICATES DIRECTION OF SURFACE DRAINAGE | 100.0   |
| EXISTING CONTOURS    | ---○--- |                                         |         |
| PROPOSED CONTOURS    | ---○--- |                                         |         |
| EXIST. ELEV.         | 100.0   | PROP. ELEV.                             | 100.0   |

## REMARKS

ALL BOUNDARY DATA SHOWN WAS OBTAINED FROM (DEEDS, RECORDED SUBDIVISION PLAT OR OTHER PUBLIC RECORDS)  
LOCATIONS AS SHOWN OF ADJACENT WELLS AND SEPTIC TANKS OBTAINED FROM LAKE COUNTY HEALTH DEPARTMENT

## DESIGN CERTIFICATION

THIS PLAT WAS PREPARED BY ME, AND IS CORRECT TO THE BEST OF MY KNOWLEDGE AND BELIEF.  
Richard J. Debevec, P.S. # 5244  
NAME SURVEYOR REGISTRATION NO.

## CHECK LIST

|                                 |                                         |
|---------------------------------|-----------------------------------------|
| NO. OF BEDROOMS                 | WATER MAIN SIZE, LOCATION               |
| DIMENSIONS                      | SAN. SEWER SIZE, GR. LOC.               |
| BEARINGS                        | SAN. MH. CAST ELEV. INV. ELEV.          |
| TIE TO NEAREST STREET           | SAN. CONN. SIZE, LOC. DEPTH             |
| SUBLOT NO., PARCEL NO.          | STORM SEWER SIZE, GR. LOC.              |
| SURROUNDING OWNERS              | STORM MH. CAST ELEV. INV. ELEV.         |
| BLDG. DIMENSIONS FIN. GR.       | PAV'T TYPE, GRADE CURBS                 |
| BLDG. TIES FL'R. GRADES         | GAS LINE LOC. SIZE, PRESSURE            |
| APPROX. TYPE, WIDTH, THICKNESS  | SEPTIC TANK LOCATION & DUPLICATION AREA |
| SIDEWALK TYPE, WIDTH, THICKNESS | WELL LOCATION                           |
| CULVERT TYPE DIA., LENGTH       | ISOLATION RADIUS FROM WELL              |
| ROCK OUTCROPPINGS               |                                         |

| REVISIONS |      |    | PLAN PREPARED BY:                      |        |             |
|-----------|------|----|----------------------------------------|--------|-------------|
| NO.       | DATE | BY | DEBEVEC-SALO & ASSOCIATES, INC.        |        |             |
| 1         |      |    | 130 EAST JACKSON ST. PAINESVILLE, OHIO |        |             |
| 2         |      |    | DRAWN BY                               | SCALE  | PHONE NO.   |
| 3         |      |    | CHK'D.                                 | DATE   | DRAWING NO. |
| 4         |      |    | CREW CHIEF                             | APP'D. | 4730-23     |

## "AS BUILT" CERTIFICATION

I, HEREBY CERTIFY THAT THE CIRCLED GRADES ARE EXISTING FINISH GRADES CHECKED IN FIELD ON 19 BY SURVEYING AND ARE CORRECT TO THE BEST OF MY KNOWLEDGE AND BELIEF.

REGISTERED SURVEYOR REG. NO.

Grading Plan Approved  
as shown and/or noted  
THOMAS P. GILLES, P.E.  
Lake County Engineer

By JWK Date 11-15-76

APPROVED  
MADISON TWP. ZONING  
Permit: 9758  
Zoning Inspector: B. P. Brown