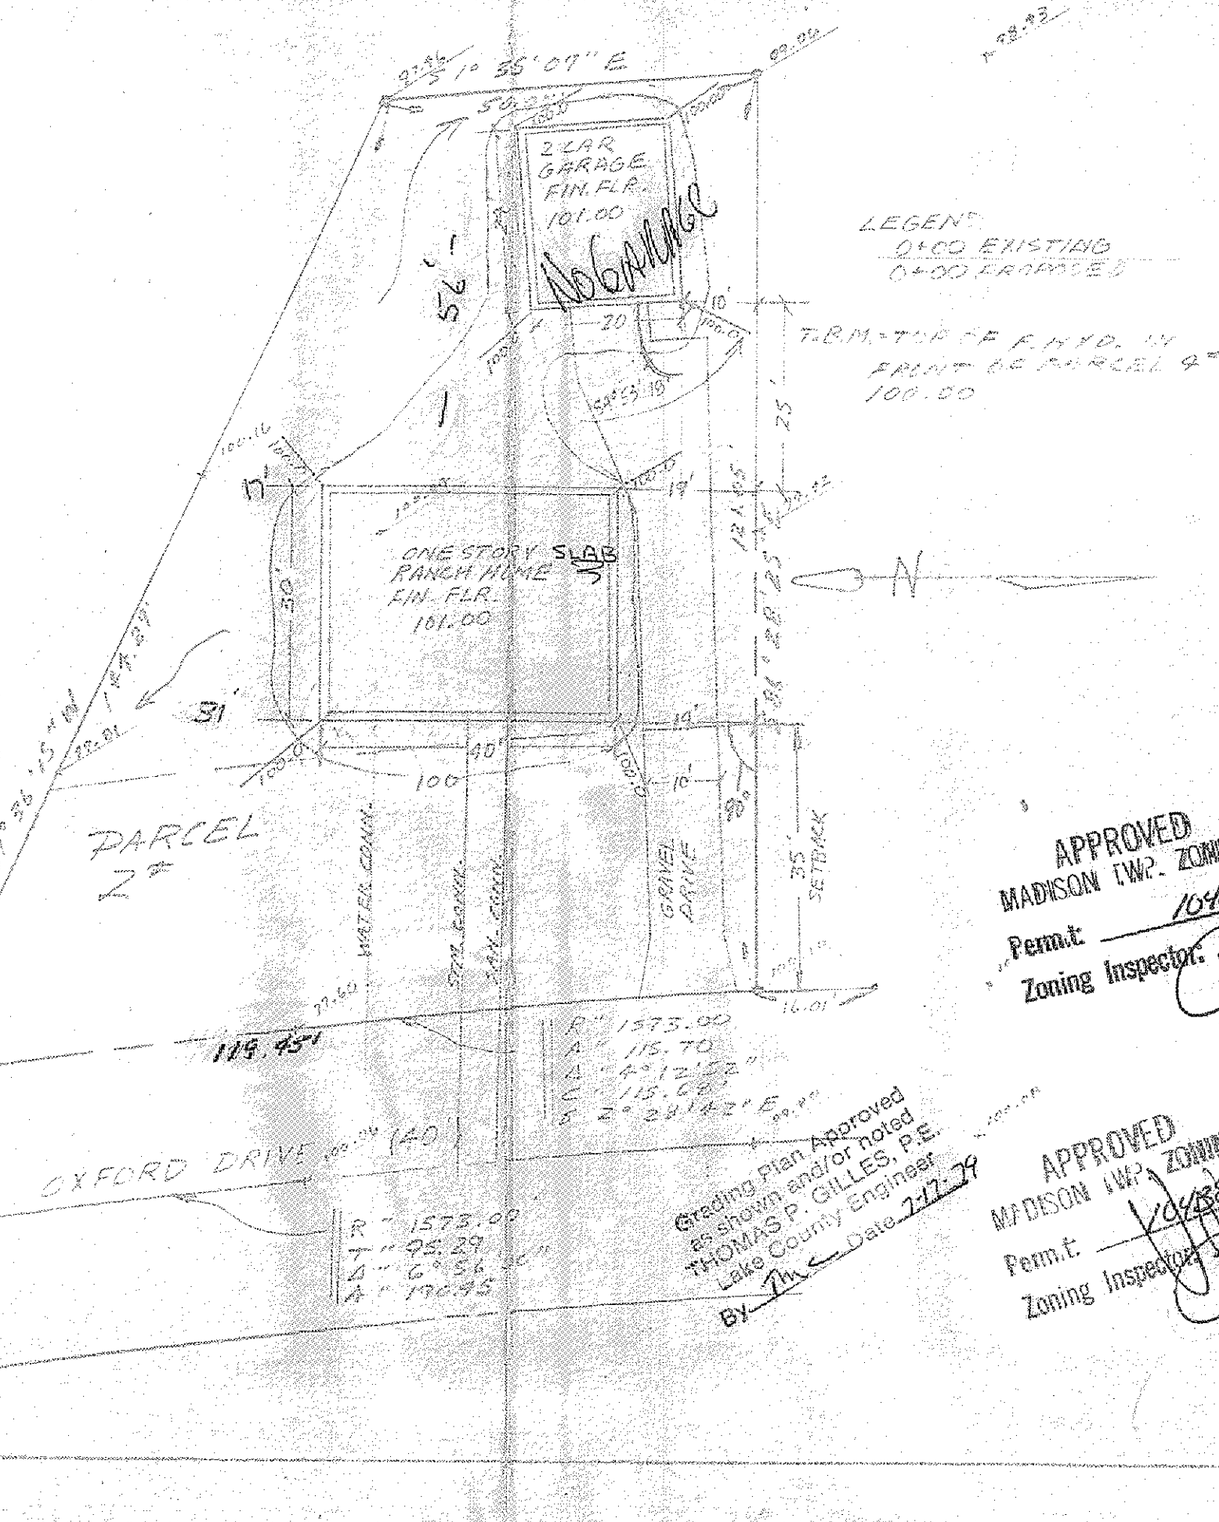

SITE PLAN FOR:

P.A.C. HOMES
P.O. 691
GENEVA, OHIO

BEING PARCEL NO. 2 IN THE MADISON BEACH ESTATES IN MADISON TWP. LAKE COUNTY, OHIO

PREPARED BY:
WM. R. GRAY ASSOC. INC.
7547 MENTOR AVE.
MENTOR, OHIO

SCALE: 1"=20'
DATE: 5-16-79

APPROVED
MADISON TWP. ZONING
Permit 10458
Zoning Inspector

Grading Plan Approved as shown and/or noted
THOMAS P. GILLES, P.E.
Lake County Engineer
By Date 7-17-79

APPROVED
MADISON TWP. ZONING
Permit 10458
Zoning Inspector

CERTIFICATION:
I HEREBY CERTIFY THAT THIS PLAT IS CORRECT TO THE BEST OF MY KNOWLEDGE.

By: William J. Haas
William J. Haas Reg. No.

STATE OF OHIO
WILLIAM J. HAAS
4705
REGISTERED SURVEYOR