


* ALL LOTS IRMA H. & LESLIE R. GNAGY
Vol 377-371 & Vol 383-628

Grading Plan Approved
as shown and/or noted
THOMAS P. GILLES, P.E.
Lake County Engineer

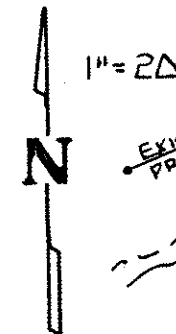

EXIST
PROP

By 6JH Date 9-18-97

SITE PLAN FOR GLENN GNAGY

BEING SUBLOT No. 99 & SUBLOT No. 100, IN THE MADISON
LAKELAND SUBDIVISION, IN THE TOWNSHIP OF MADISON,
COUNTY OF LAKE, STATE OF OHIO.
Total Area - 0.1863 Ac.

*NOTE: BEARINGS PER RECORD DEED
& MONUMENTATION FOUND

I, the undersigned hereby certify that
this topography, indicated by 1' contours,
and elevations shown hereon represent an
actual field survey made by me on MAY 13, 1996
and that the elevations were taken at
appropriate intervals and that as of that
date they existed as indicated hereon.

APPROVED
MADISON TOWNSHIP ZONING

SEP 12 1997

PERMIT # 15549
ZONING INSPECTOR CM

AUG 23, 1996
REV. SEPT. 11, 1997

VILLAGE SURVEYING CO.
P.O. BOX 1096, FAIRPORT HARBOR, OHIO 44077
(216) 357-1359

