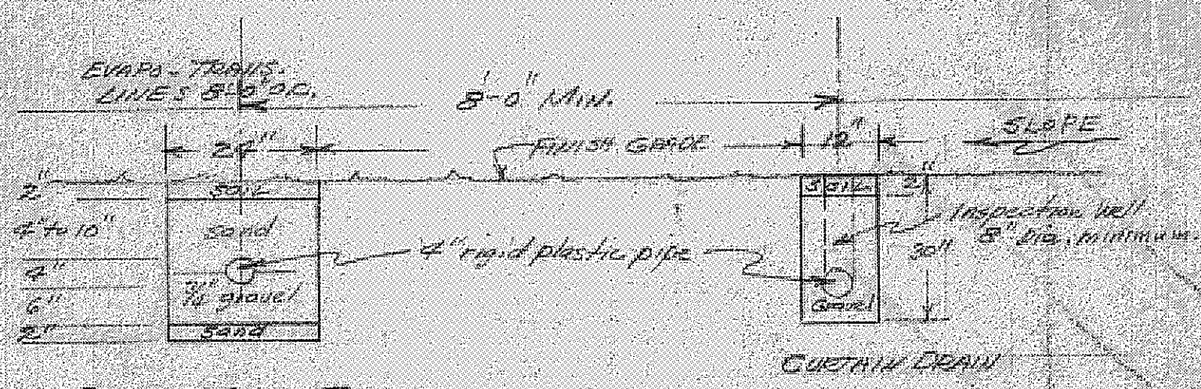

EVAPO-TRANS. TRENCH
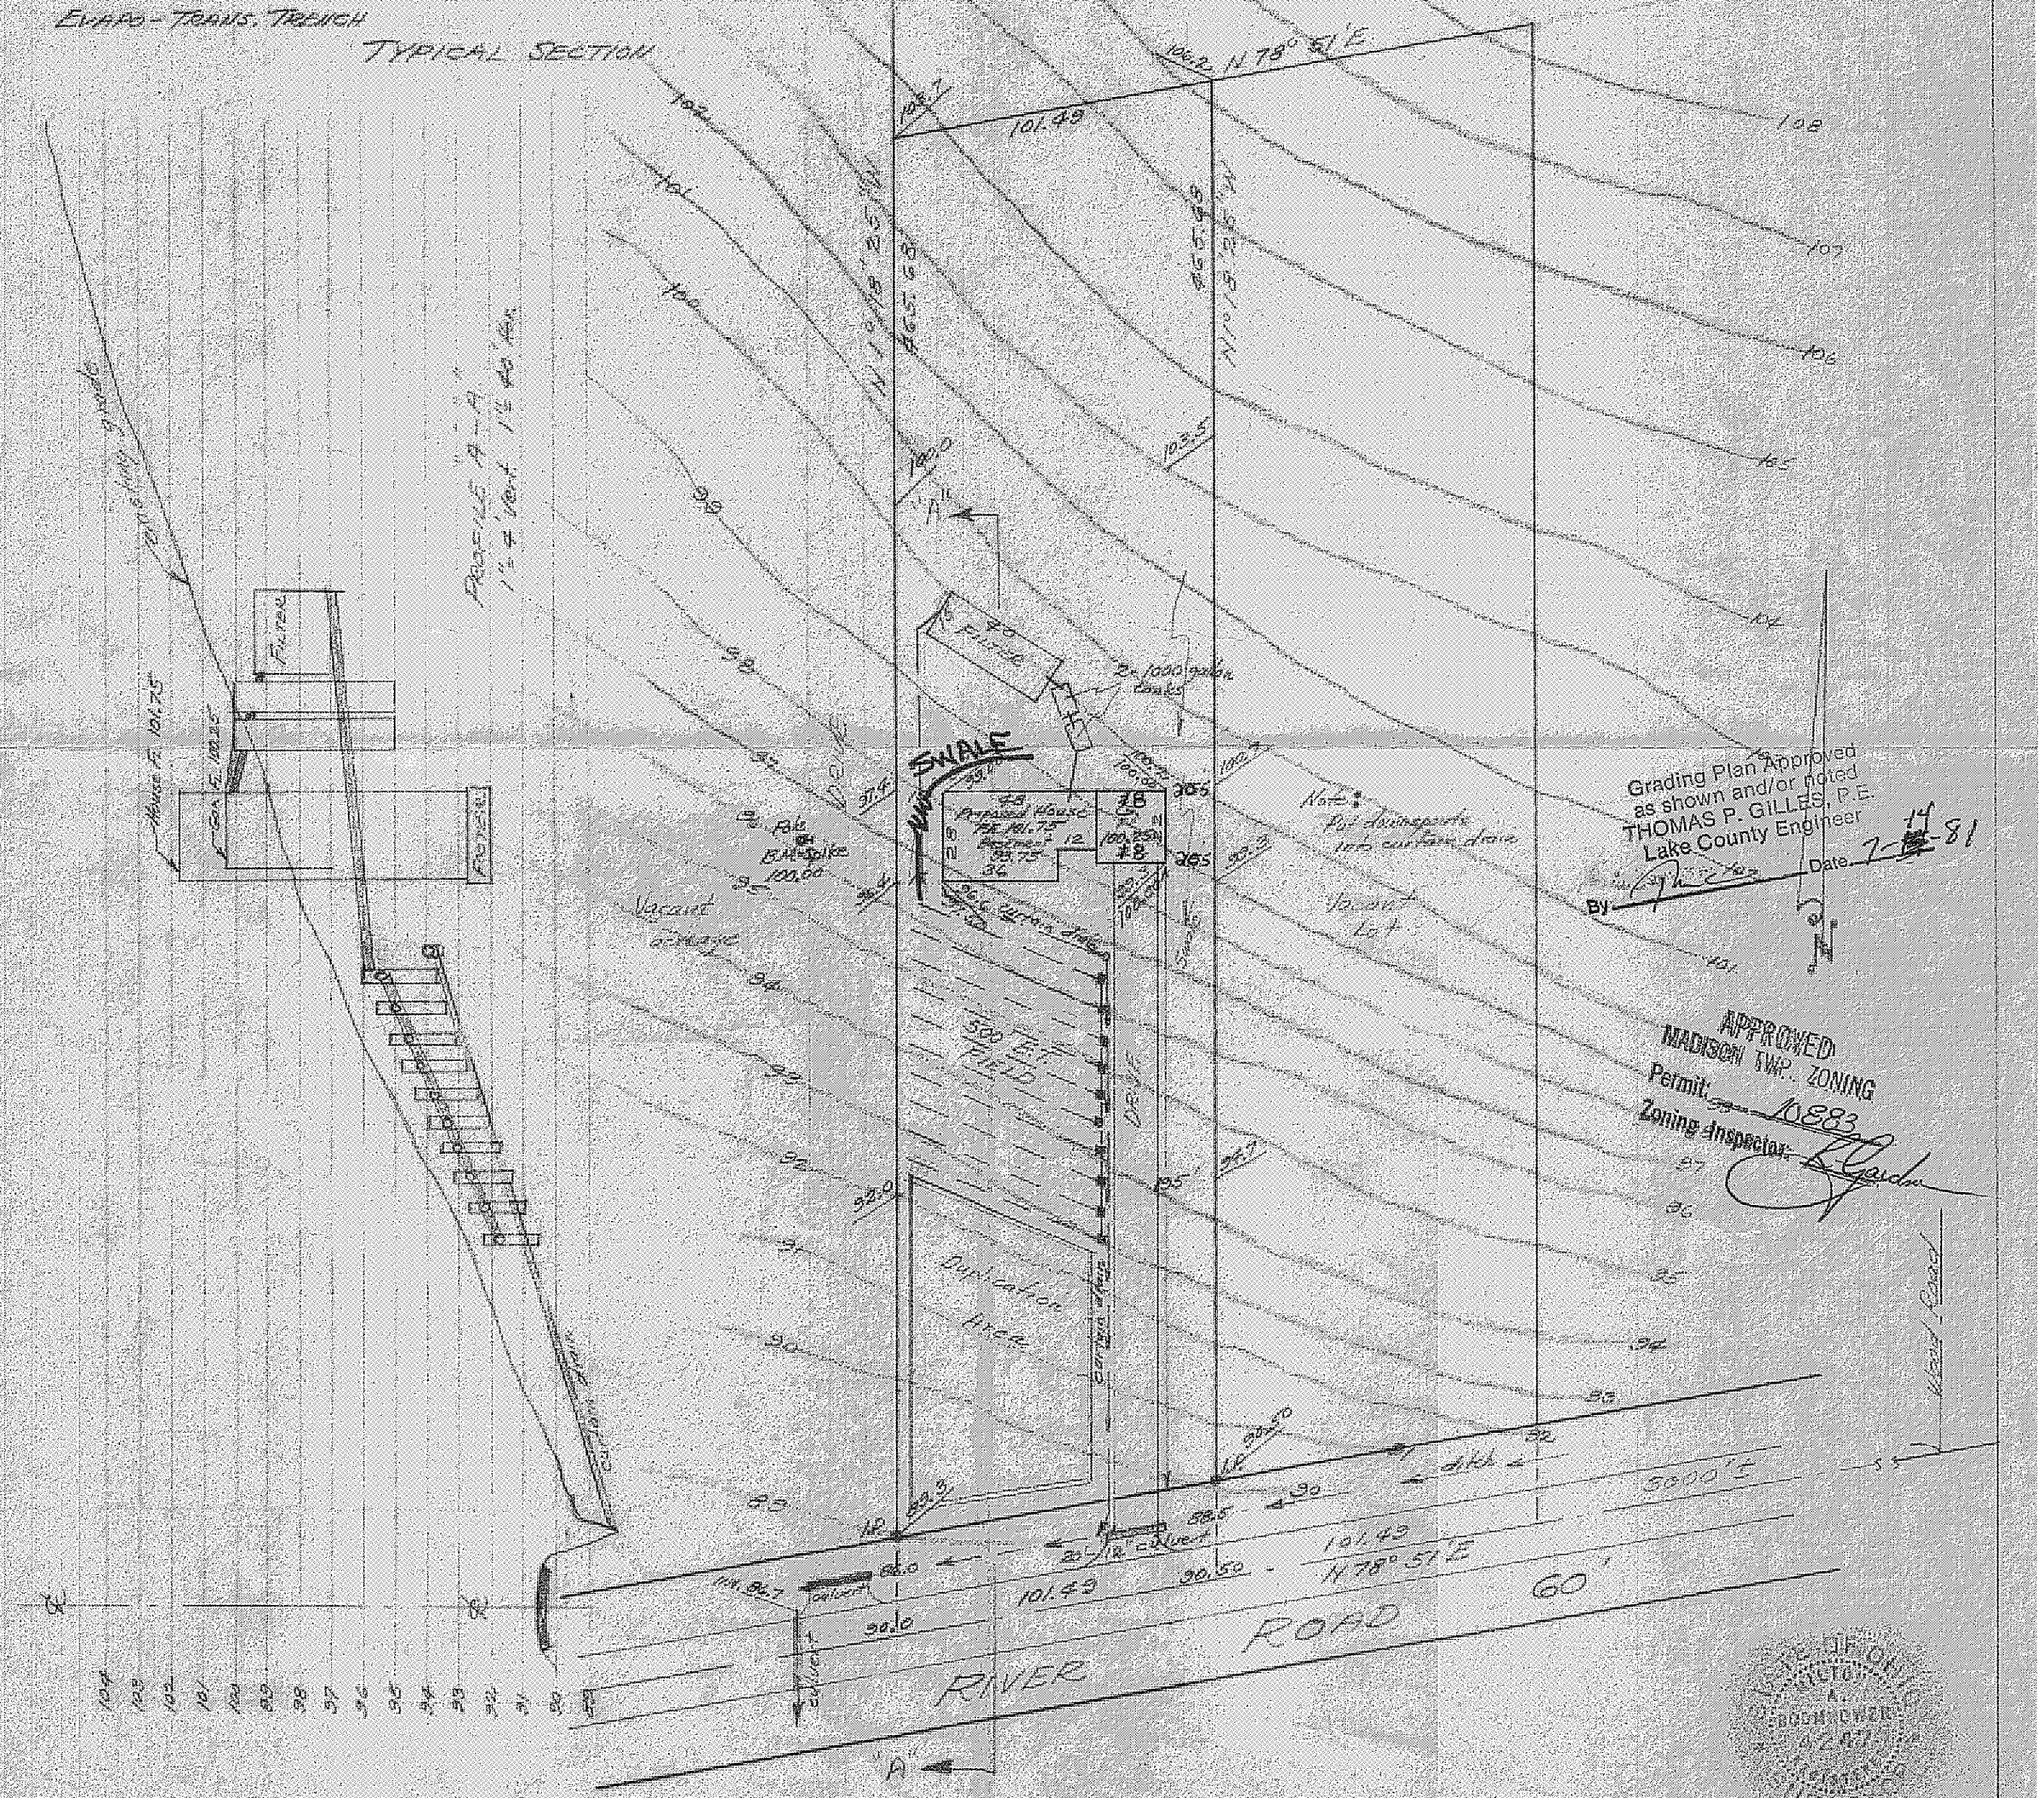
TYPICAL SECTION