APPROVED
MADISON TWP. ZONING
Permit: 8448
Zoning Inspector: KS

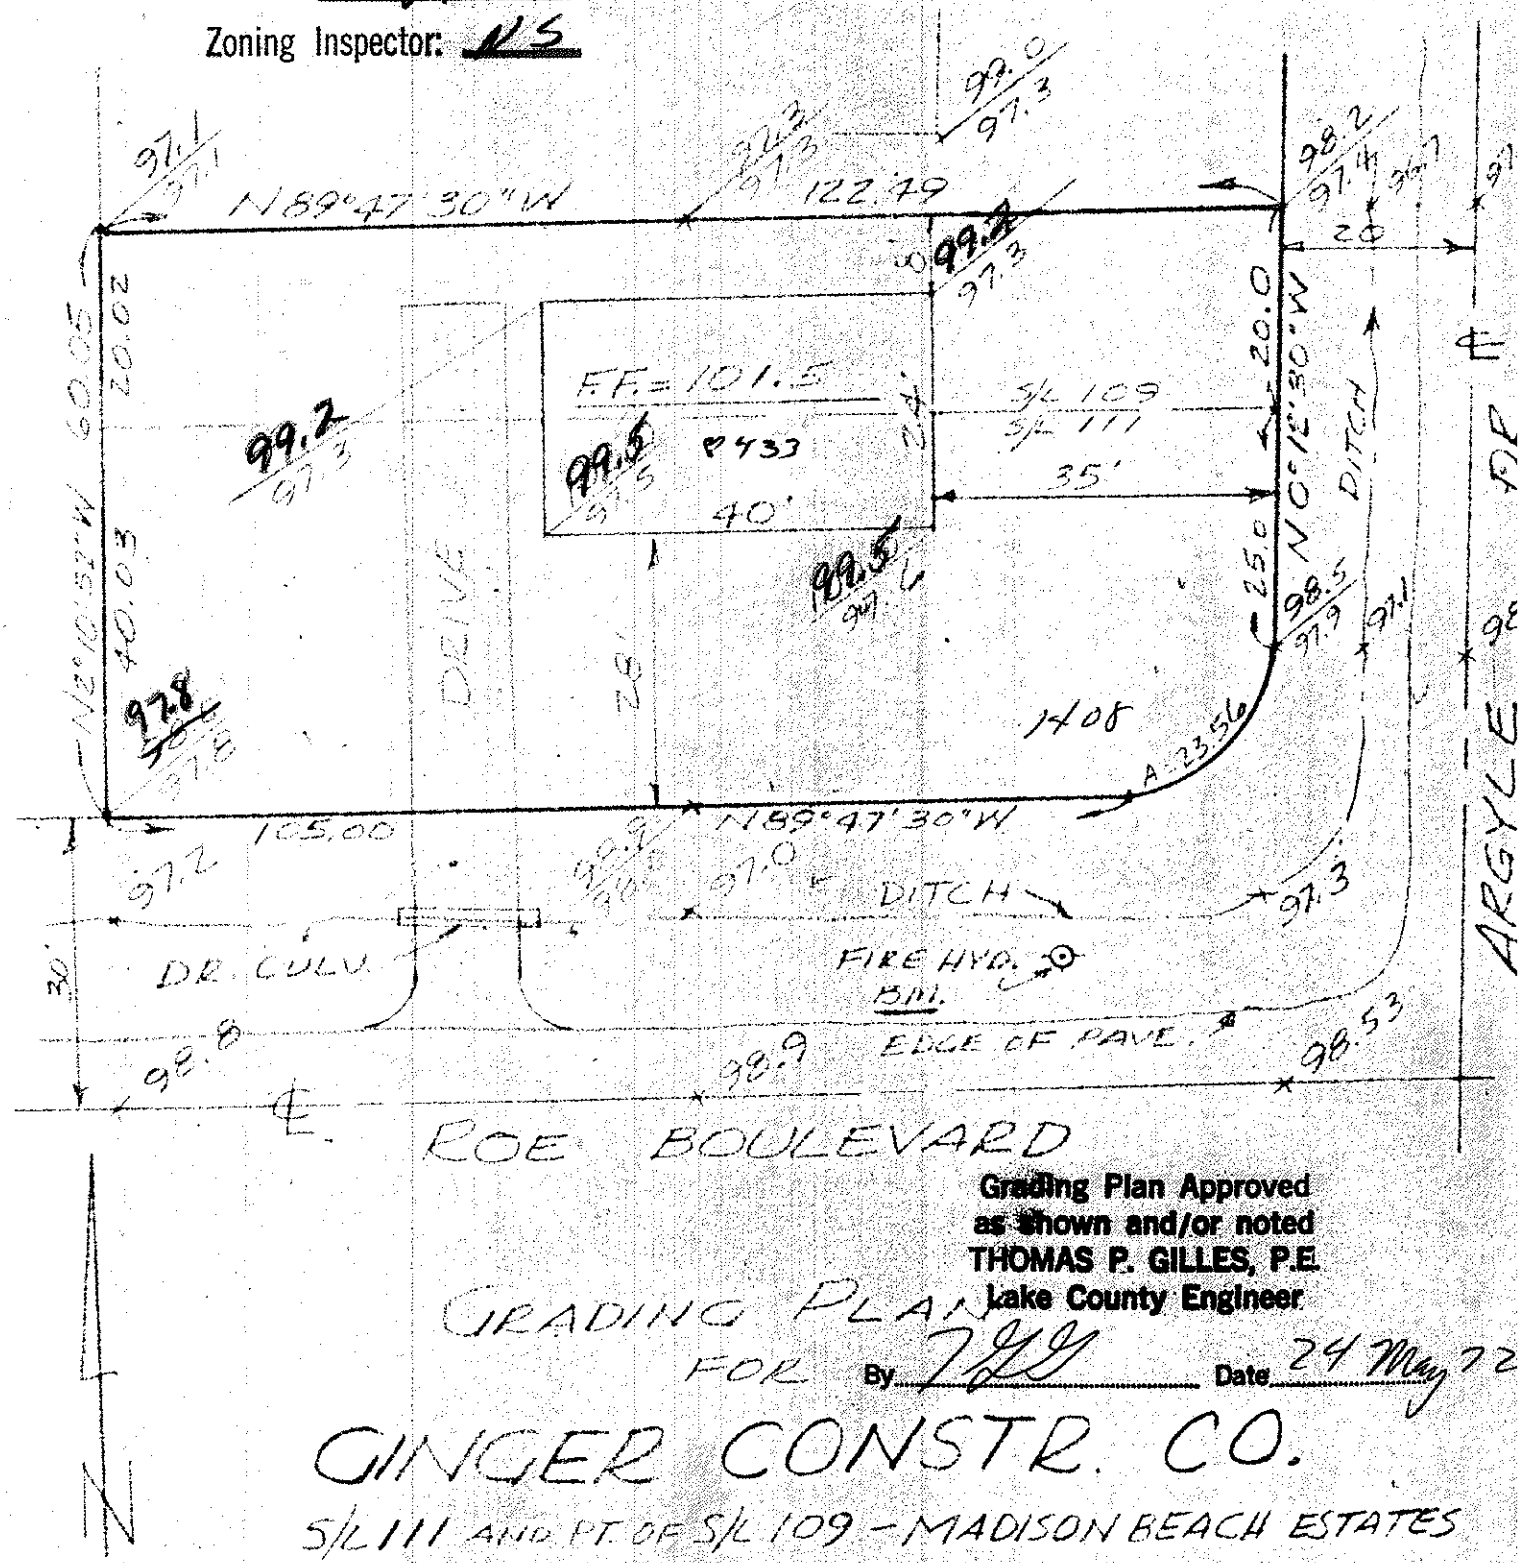

Grading Plan Approved
as shown and/or noted
THOMAS P. GILLES, P.E.
Lake County Engineer
By TPG Date 24 May 72

GRADING PLAN
FOR
GINGER CONSTR. CO.
S/L 111 AND PT. OF S/L 109 - MADISON BEACH ESTATES
MADISON TWP. - LAKE CO. OHIO
SCALE: 1"=20' MAY, 1972

FULLERTON-KERR AND ASSOCIATES
REGISTERED ENGINEERS AND SURVEYORS
PAINESVILLE, OHIO

NOTE: UNDERLINED EL. ARE FINISHED GRADE.
B.M. TOP FIRE HYD. EL. 100.00