

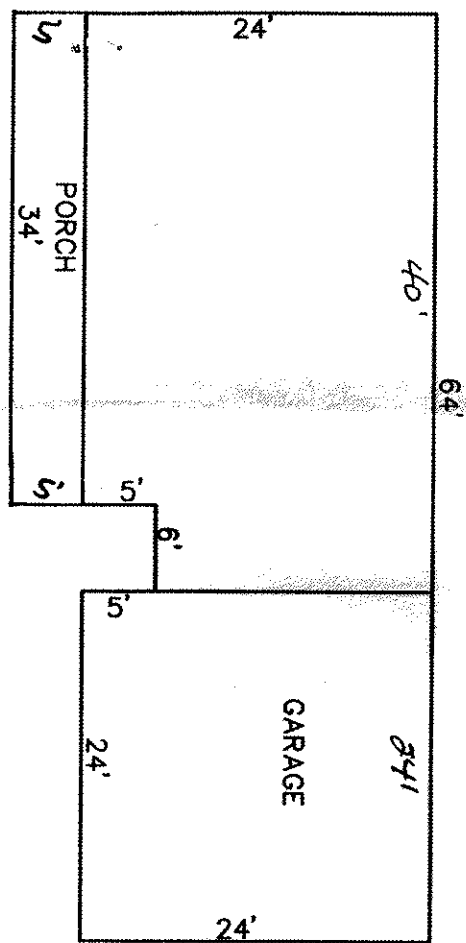
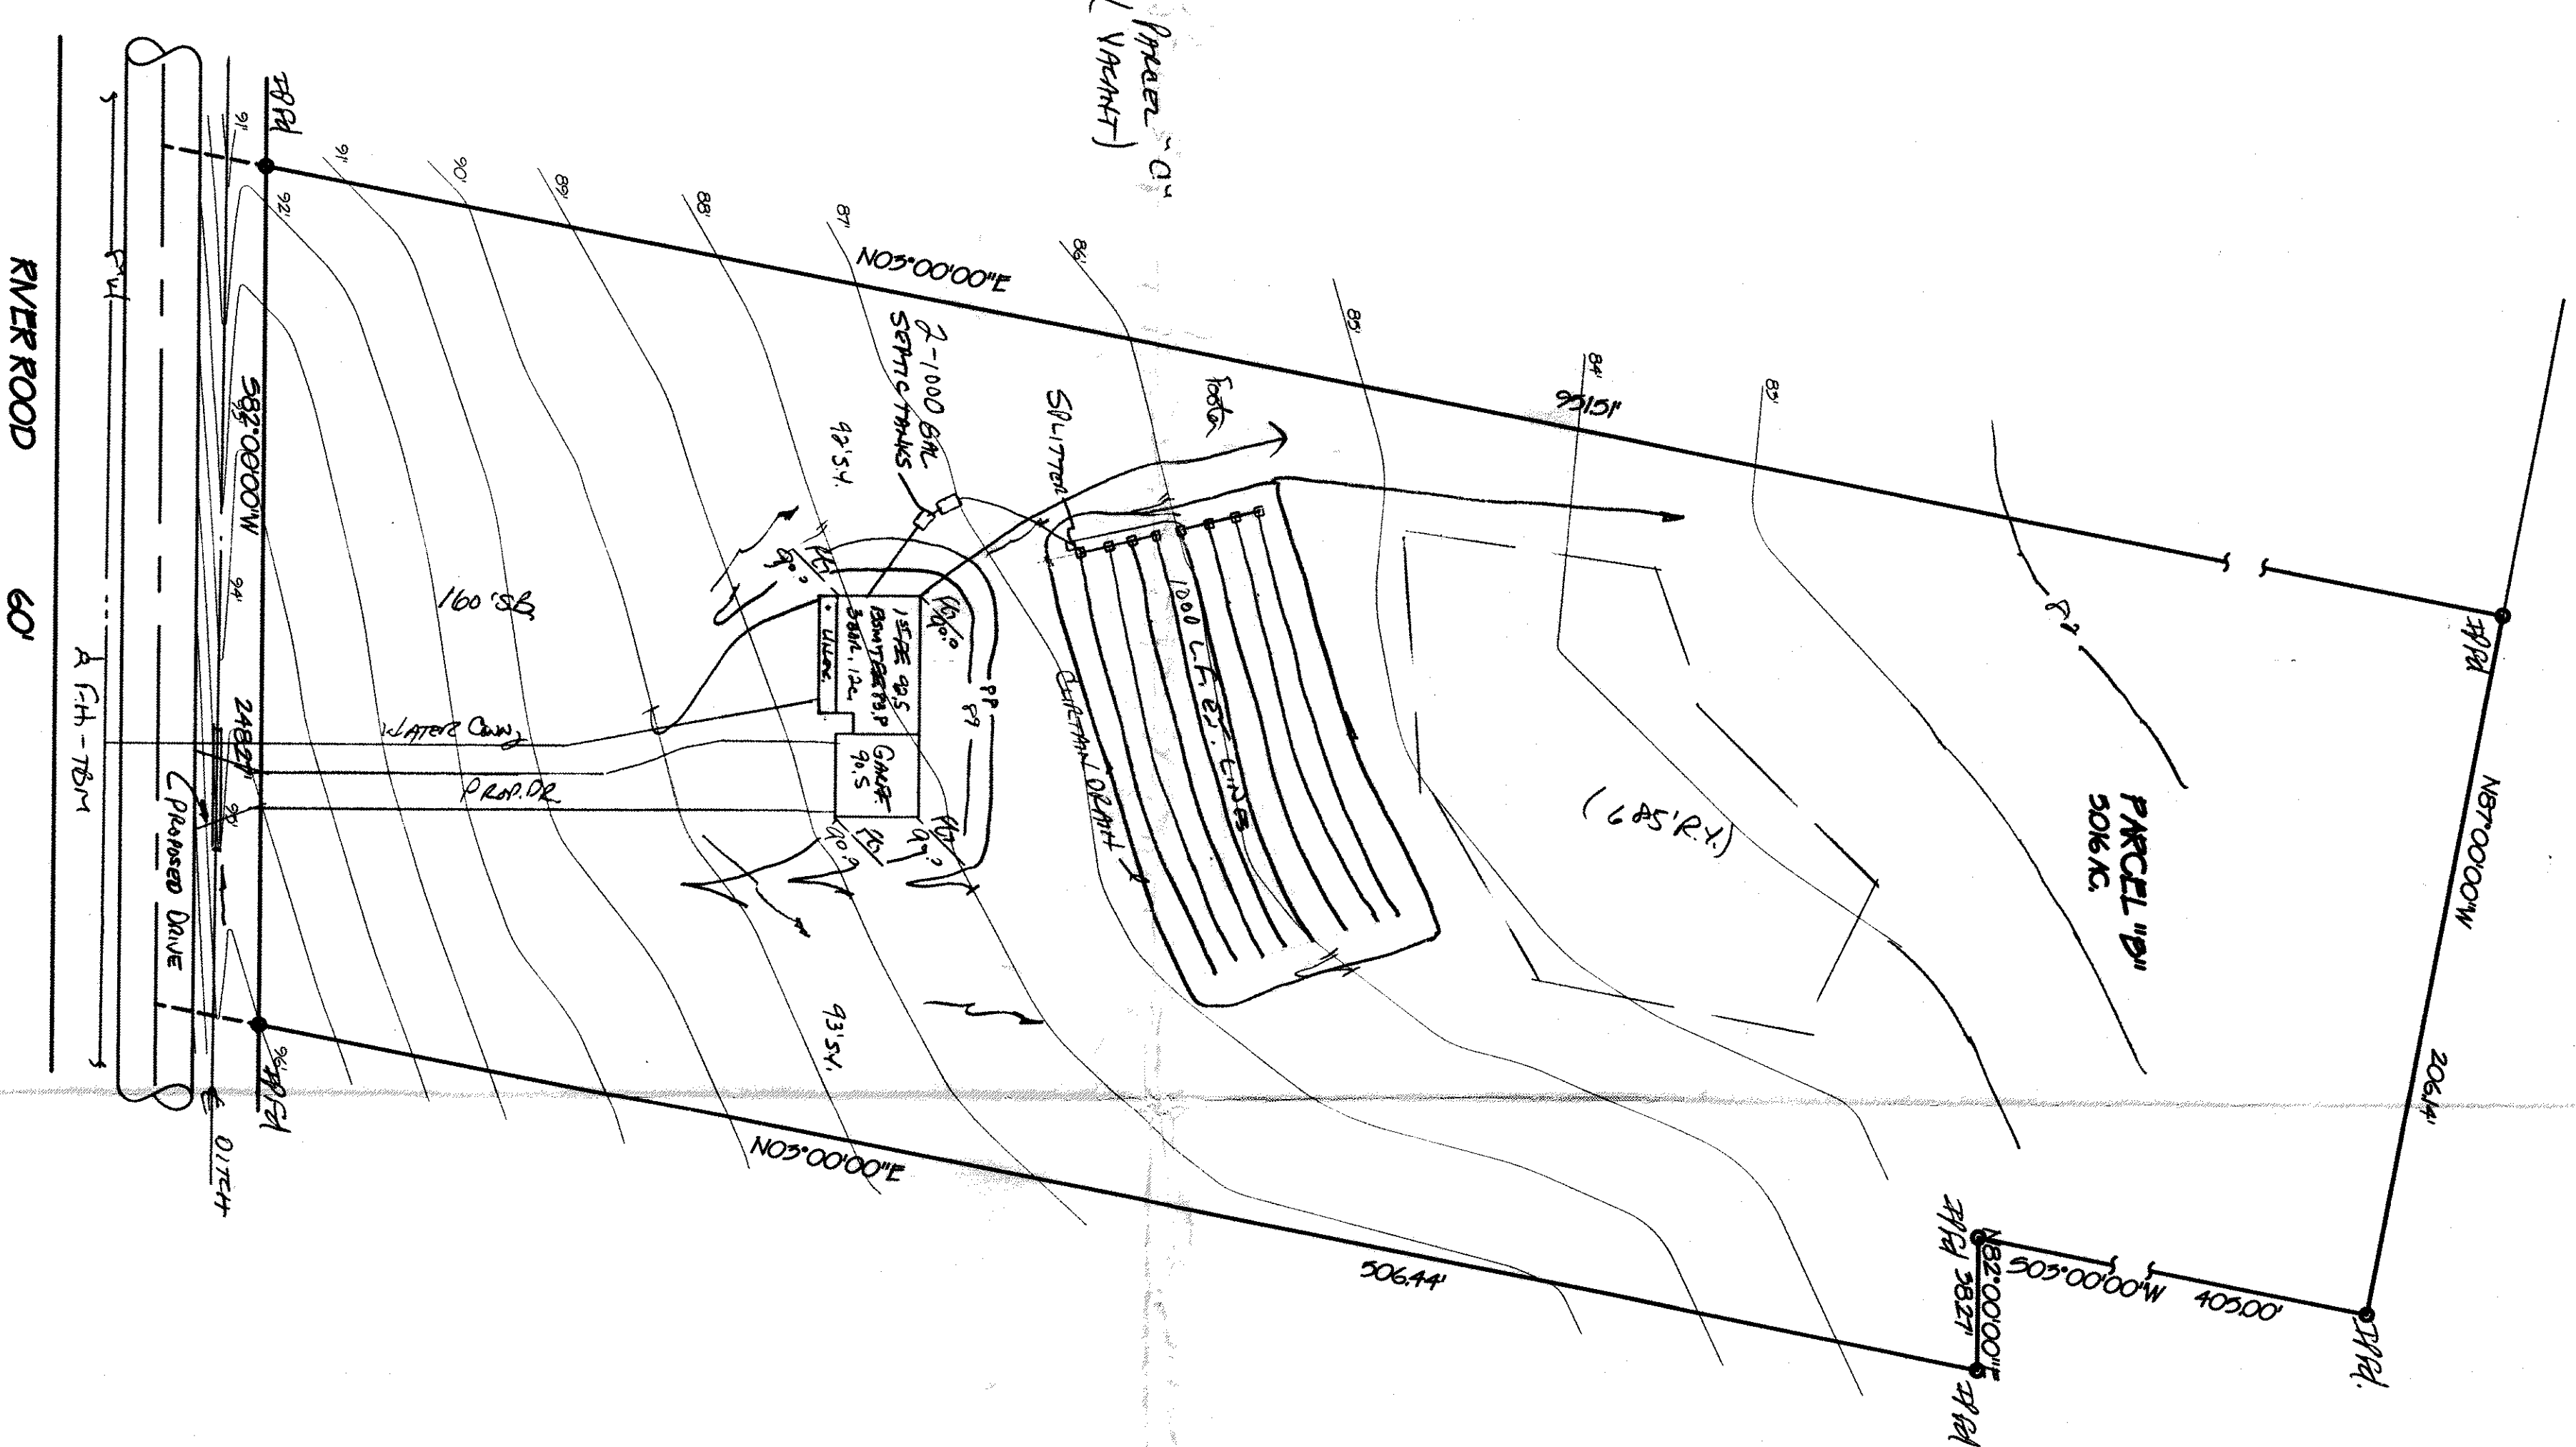


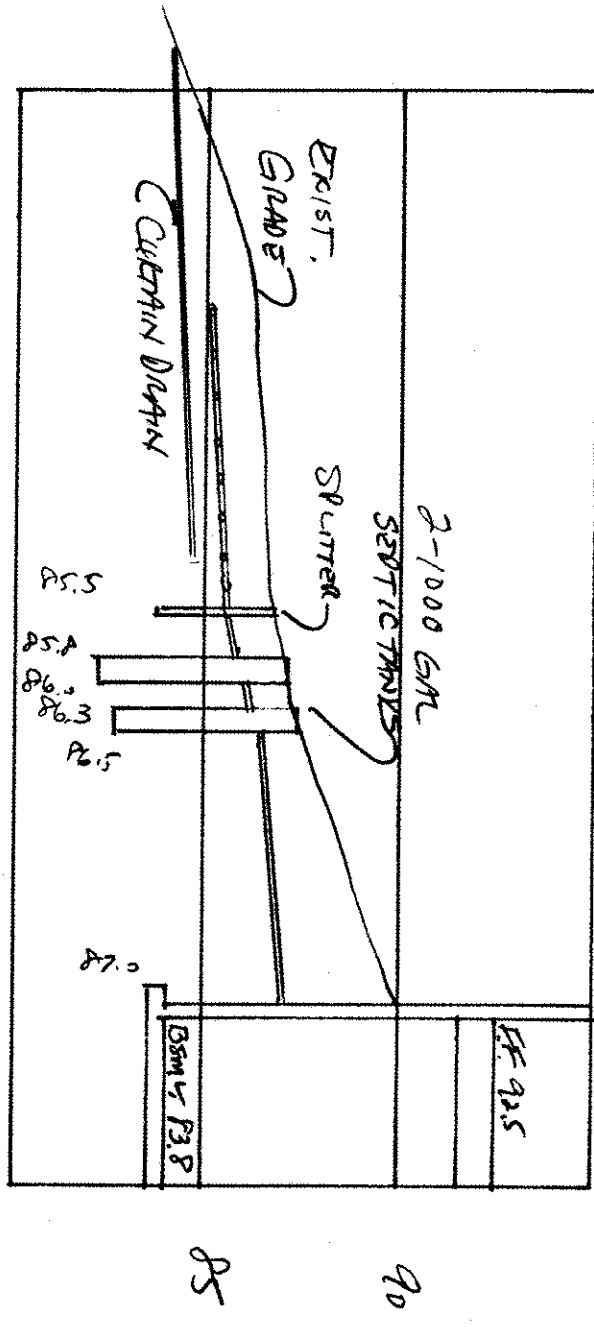


NOV 14 2007
#5105
C.R.

REVIEWED AND ACCEPTED
LAKE COUNTY GENERAL
HEALTH DISTRICT

Date: 11/10/97
By: David Lott
Deputy Solid Waste
Eng. S. J. G. G.
SOLID WASTE DISPOSAL PERMIT MUST BE
OBTAINED BY A LAKE COUNTY
INSTALLER BEFORE INSTALLATION IS
PERMITTED

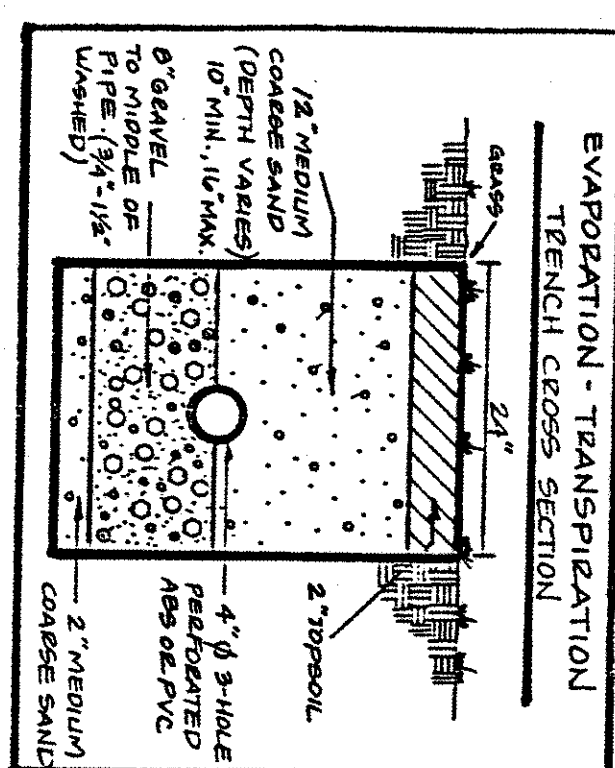

Grading Plan Approved
as shown and/or noted
THOMAS P. GILLES, P.E.
Lake County Engineer
By: M.H. Date: 11.12.97
12" Drive Culvert req'd

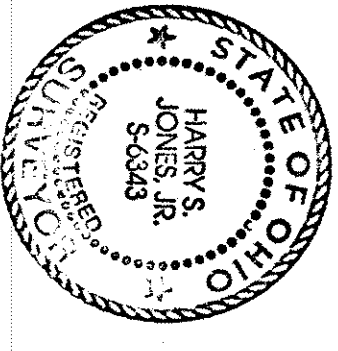

REQ. NO.	DESCRIPTION	DATE	BY	CHK'D

DATE 11/10/97
DESIGN BY HT
DRAWN BY M.S.
APPROVED BY HT

SCALE 1"=40'
JOB NO. 95-319
SHEET 1 OF 1

BABCOCK, JONES AND ASSOCIATES, INC
CIVIL ENGINEERS - SURVEYORS - LAND PLANNERS
PAINESVILLE OHIO 44077

SITE PLAN
for
R.C. Reed
5718 RIVER RD.
PAINESVILLE, OHIO 44077