


SITE PLAN


FOR

MIKE LUCAS


BEING A PART OF TRACT No. 5
IN THE TOWNSHIP OF MADISON,
COUNTY OF LAKE, STATE OF OHIO.

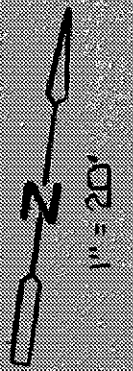


In the undersigned hereby certifies that this township, indicated by 1" contours, and elevations shown herein represent an actual field survey made by me on 7-23-90 and that the elevations were taken at appropriate intervals and that as of that date they existed as indicated herein.

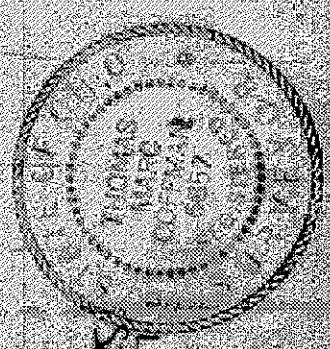


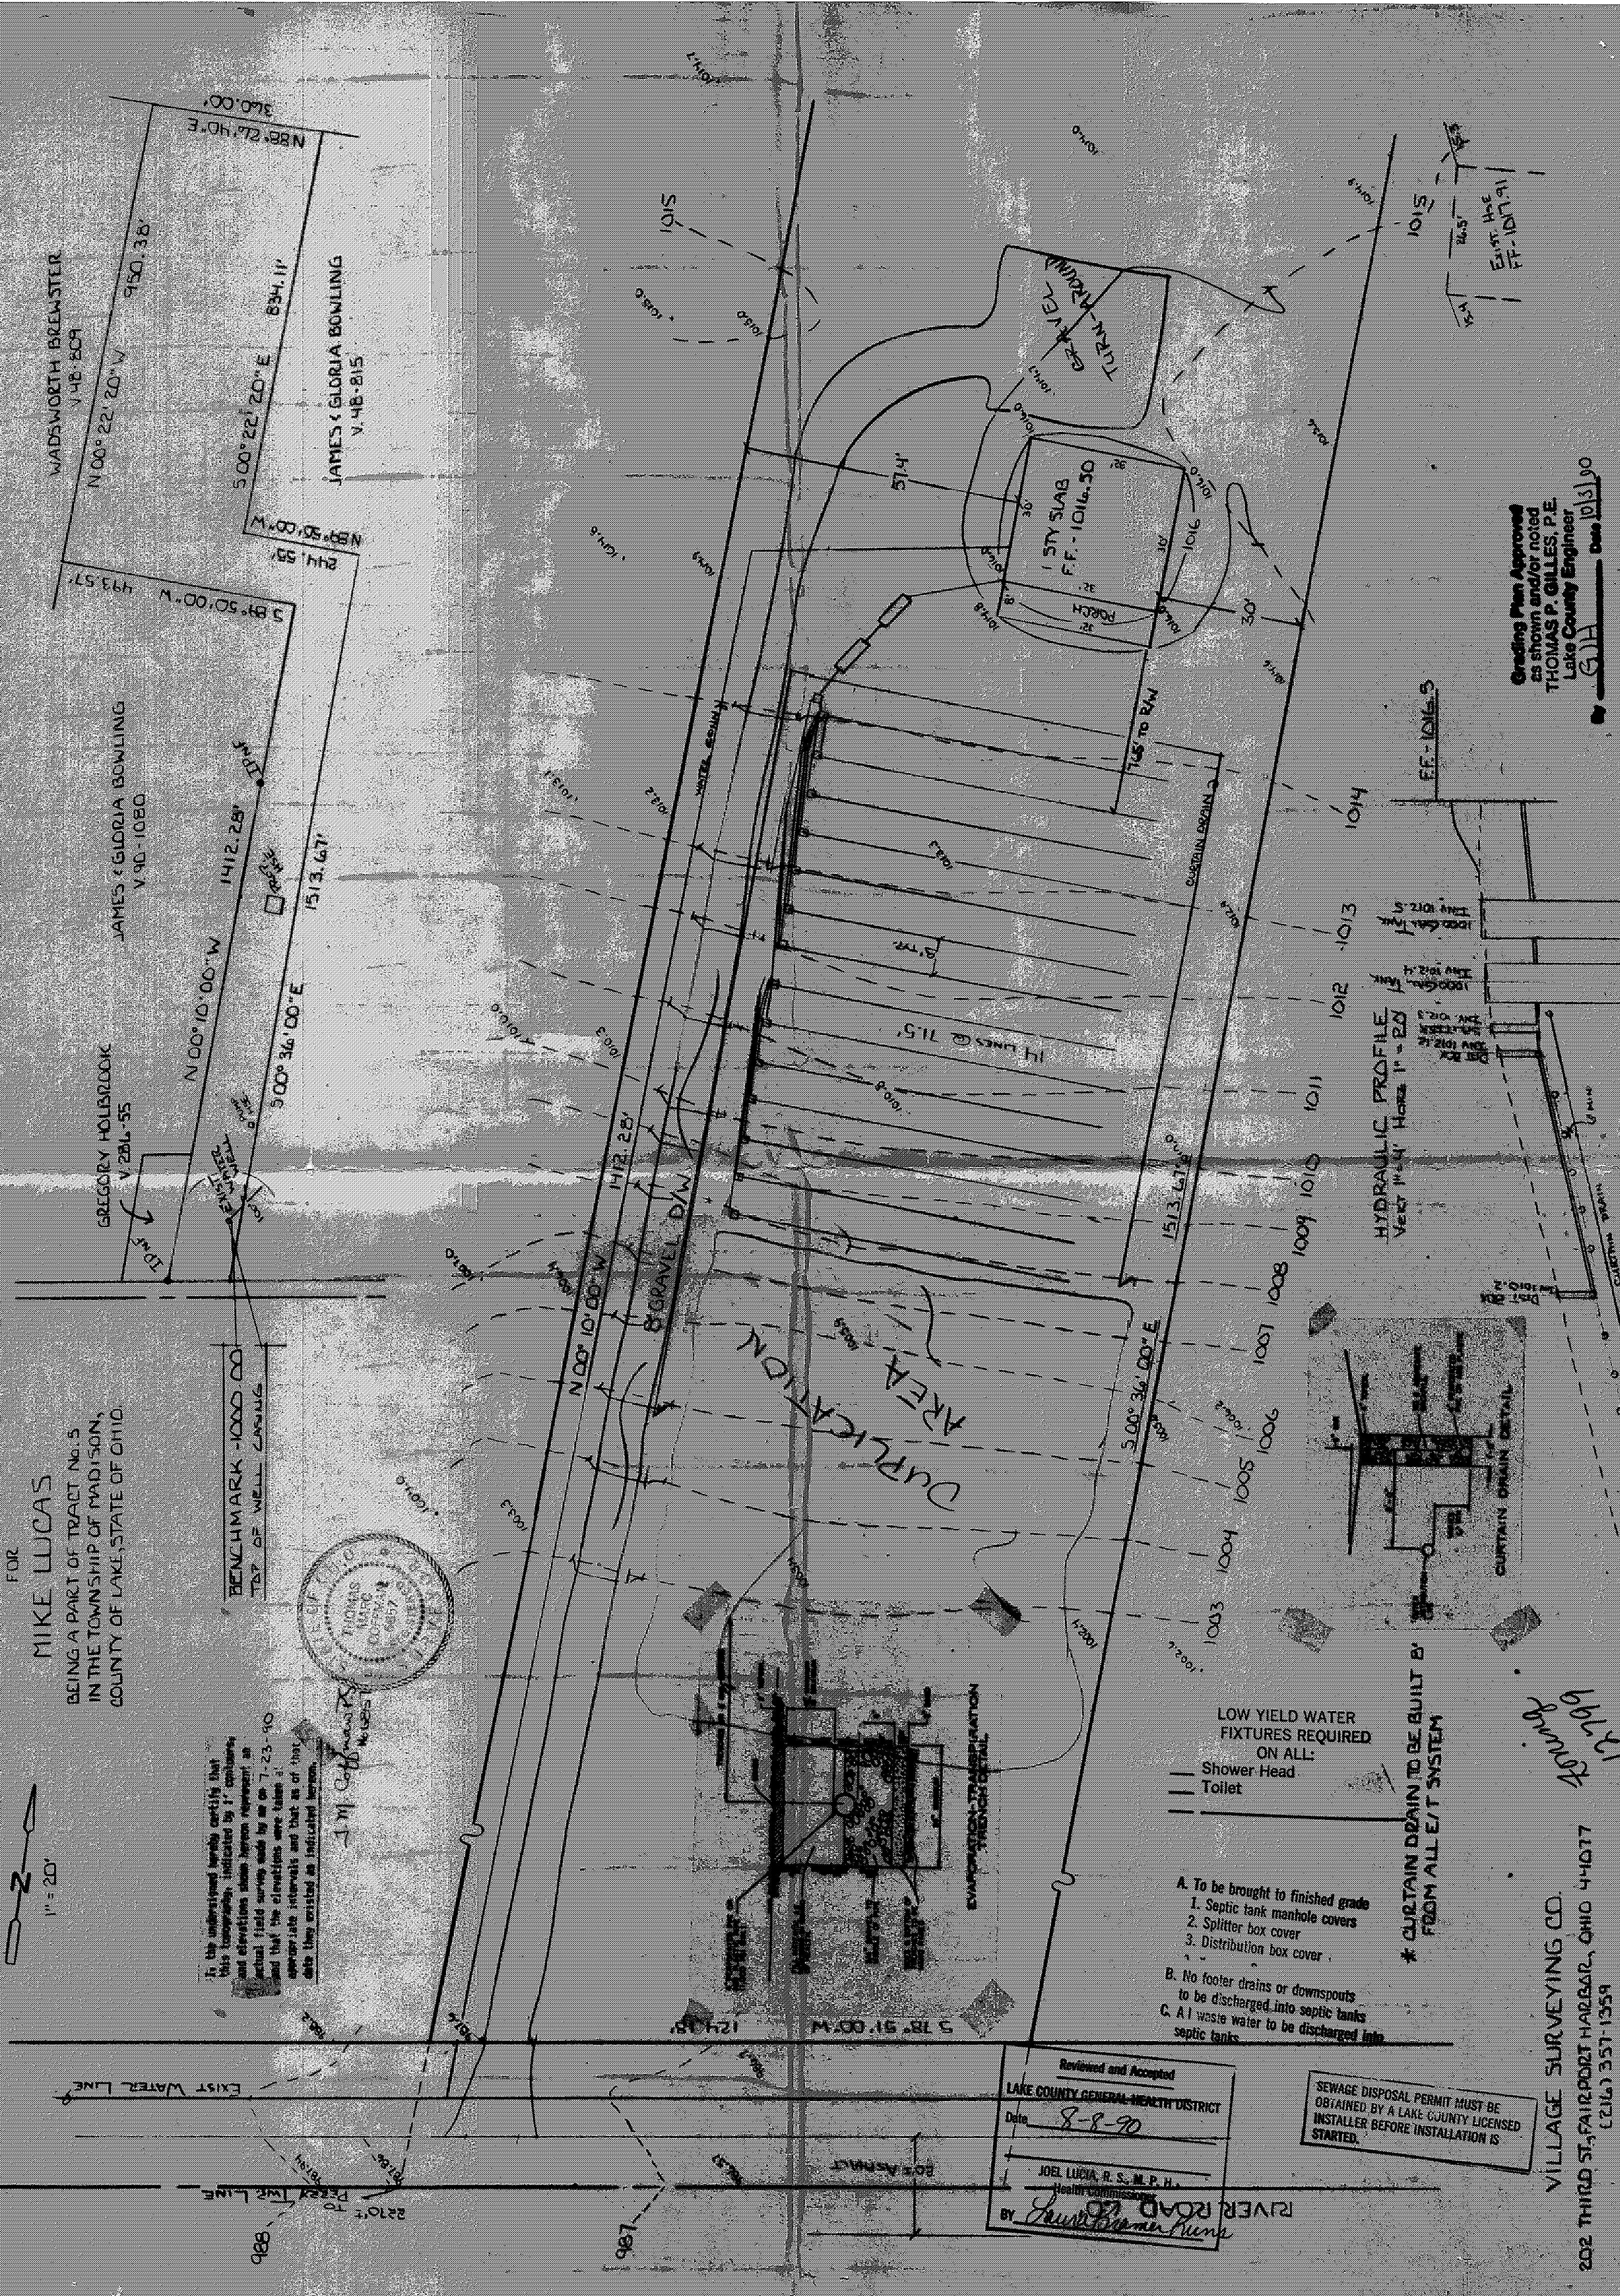

HYDRAULIC PROFILE
VERT. HORIZ. 1" = 20'

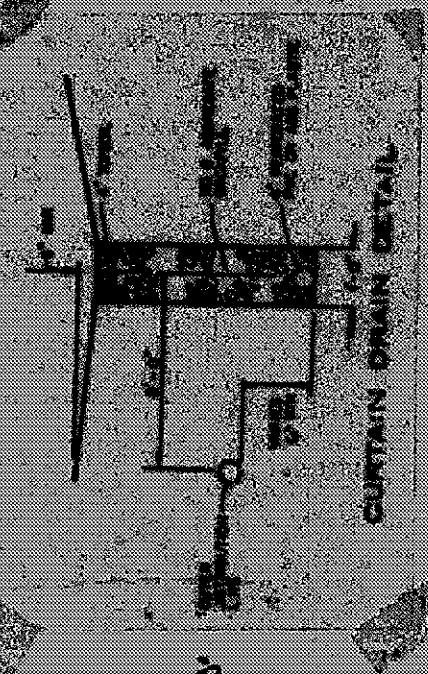

LOW YIELD WATER
FIXTURES REQUIRED
ON ALL:
Shower Head
Toilet

- A. To be brought to finished grade
1. Septic tank manhole covers
2. Splitter box cover
3. Distribution box cover
- B. No footer drains or downspouts
to be discharged into septic tanks
- C. All waste water to be discharged into
septic tanks

* CURTAIN DRAIN TO BE BUILT BY
FROM ALLE/T SYSTEM

Reviewed and Accepted
LAKE COUNTY GENERAL HEALTH DISTRICT
Date 8-8-90
JOEL LUCIA, R.S., M.P.H.
Health Commissioner
BY *Joel Lucia*

SEWAGE DISPOSAL PERMIT MUST BE
OBTAINED BY A LAKE COUNTY LICENSED
INSTALLER BEFORE INSTALLATION IS
STARTED.

Grading Plan Approved
as shown and/or noted
THOMAS P. GILLES, P.E.
Lake County Engineer
Date 10/3/90

VILLAGE SURVEYING CO.
202 THIRD ST., FAIRPORT HARBOR, OHIO 44127
(216) 351-1359