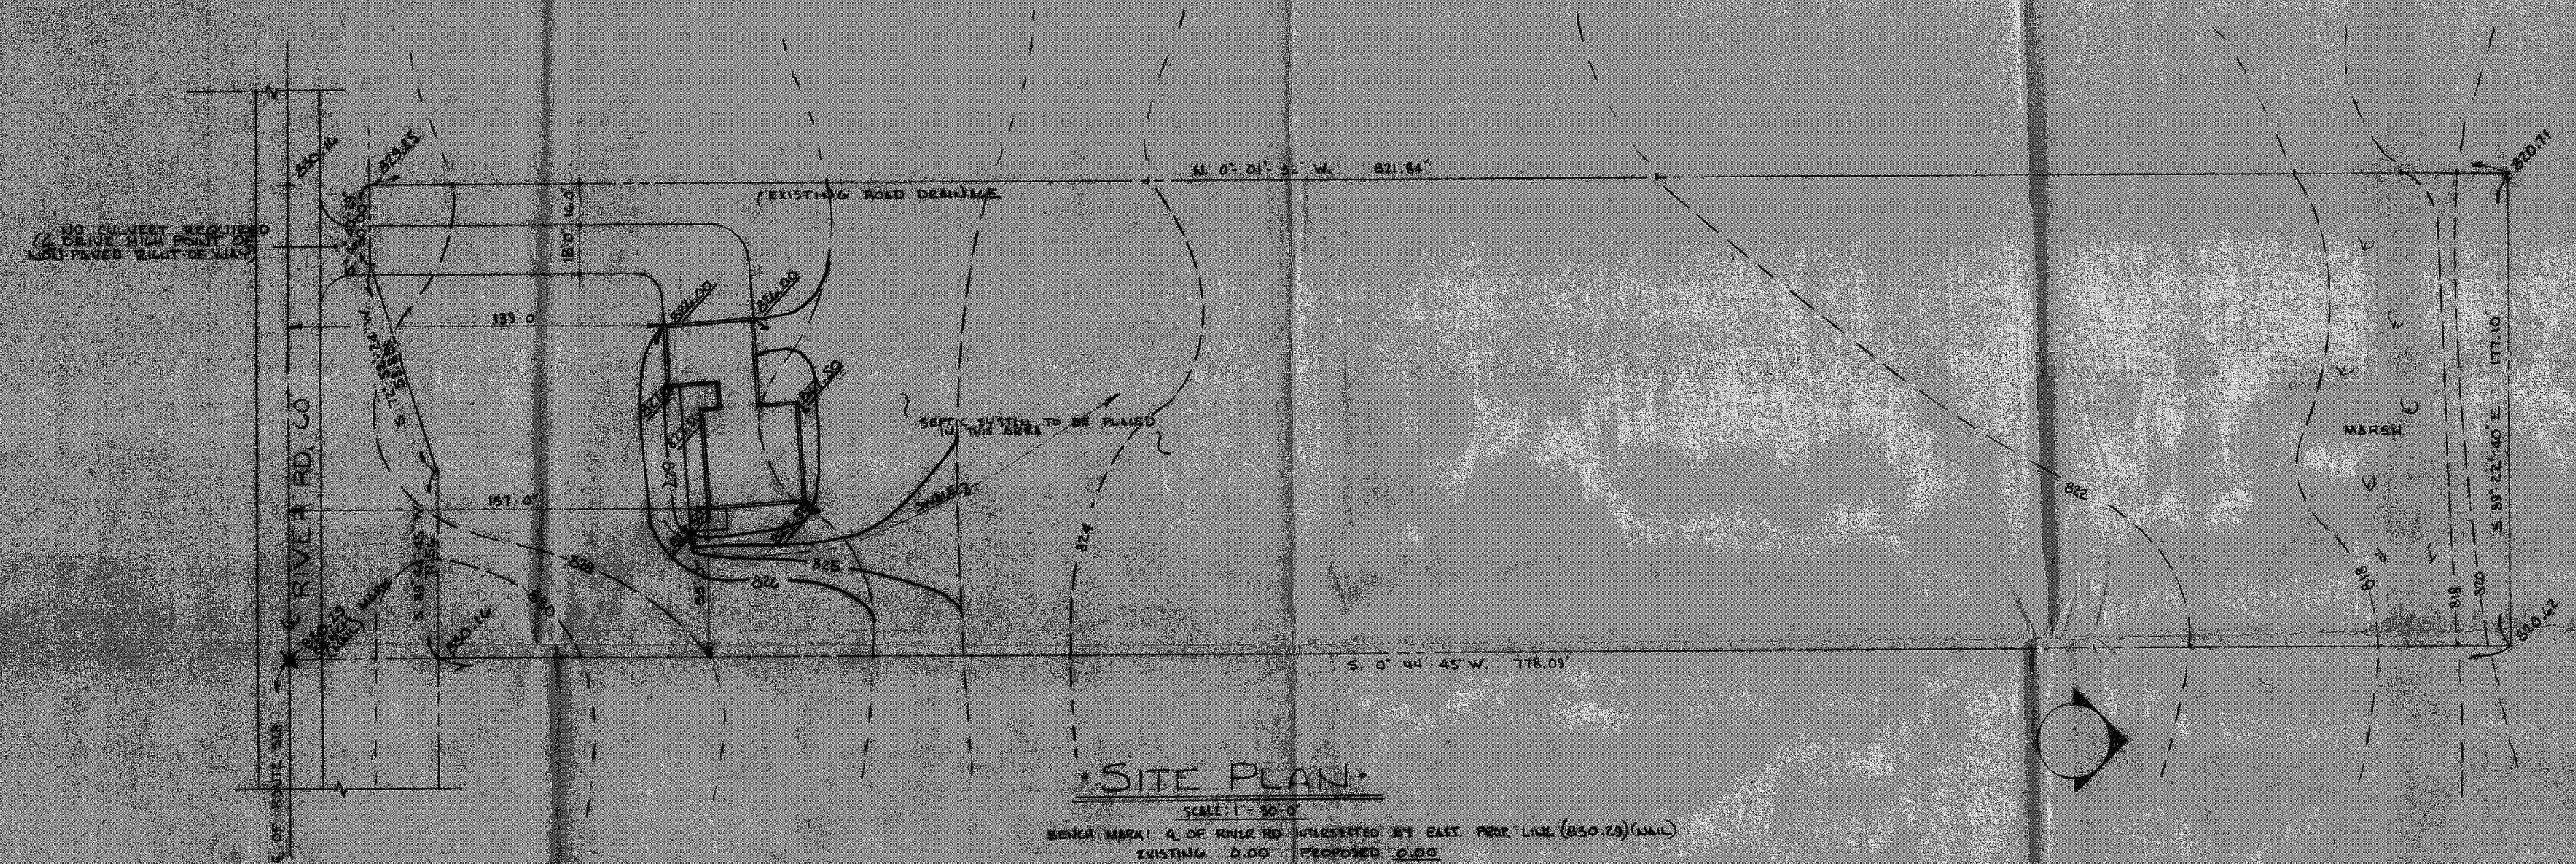

SITE PLAN

SCALE: 1" = 30'-0"

BENCH MARK: ℄ OF RIVER RD INTERSECTED BY EAST PROP. LINE (830.29) (NAIL)

EXISTING 0.00 PROPOSED 0.00

BASEMENT FLOOR	813.00
FIRST FLOOR	821.50
SECOND FLOOR	[illegible]
GABLE FLOOR	872.00

DOWNSPOUT DISCHARGE

PERM. PARCEL NO. 1A-41-19

FIRST FLOOR:	1503.00
SECOND FLOOR:	435.00
TOTAL	1938.00 SQ.FT.

NO EXISTING STRUCTURES WITHIN 50'

Grading Plan Approved as shown and/or noted
THOMAS P. GILLES, P.E.
Lake County Engineer
By [signature] Date 5/6/87

APPROVED
MADISON TWP. ZONING
Permit: 12261
Zoning Inspector: [signature]

SURVEYOR: PATRICK S. JANIS 1825 EUCLID AVE. CLEVELAND, OHIO 44115 (216) 621-1785

NEW RESIDENCE FOR:
TIMOTHY & PAMELA KORYCKI

SCALE 1"=30'-0"	APPROVED BY	DRAWN BY JWA IV
DATE 2-20-87		3-13-88