

DARLENE R. YOCUM  
VOL. 16-1303

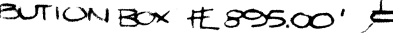
# HYDRAULIC PROFILE

SCALE: 1" = 5' VERT.  
1" = 50' HORIZ.

51.75-14

BENT-90300

002  
001  
000  
999  
998  
997  
996  
995  
994  
993  
992

DISTRIBUTION BOX # 895.00'  DISTRIBUTION BOX  
# 893.00' JCS  
SPLITTING BOX # 896.00  
1000 GAL. TANK. INV. 897.00'  
1000 GAL. TANK.  
INV. 898.00' JCS

EASTERLY 3 LINES

5.00 ΔC.  
CARLT. & KATHLEEN L. MOSLEY  
VOL. 874-661

## DUPLICATION BETWEEN LINES

PARCEL 20

CARL T. & KATHLEEN L. MOSELEY  
VOL. 874-663

VILLAGE SURVEYING CO.  
202 THIRD STREET  
FAIRPORT HARBOR, OH. 44077

Zoning Permit  
#12086

SITE PLAN  
FOR  
CARL MOSELEY

THIS PLAT WAS PREPARED  
BY ME AND IS TRUE AND  
ACCURATE TO THE BEST OF  
MY KNOWLEDGE & BELIEF.

Thomas M. Coffman  
THOMAS M. COFFMAN NO. 6857

