


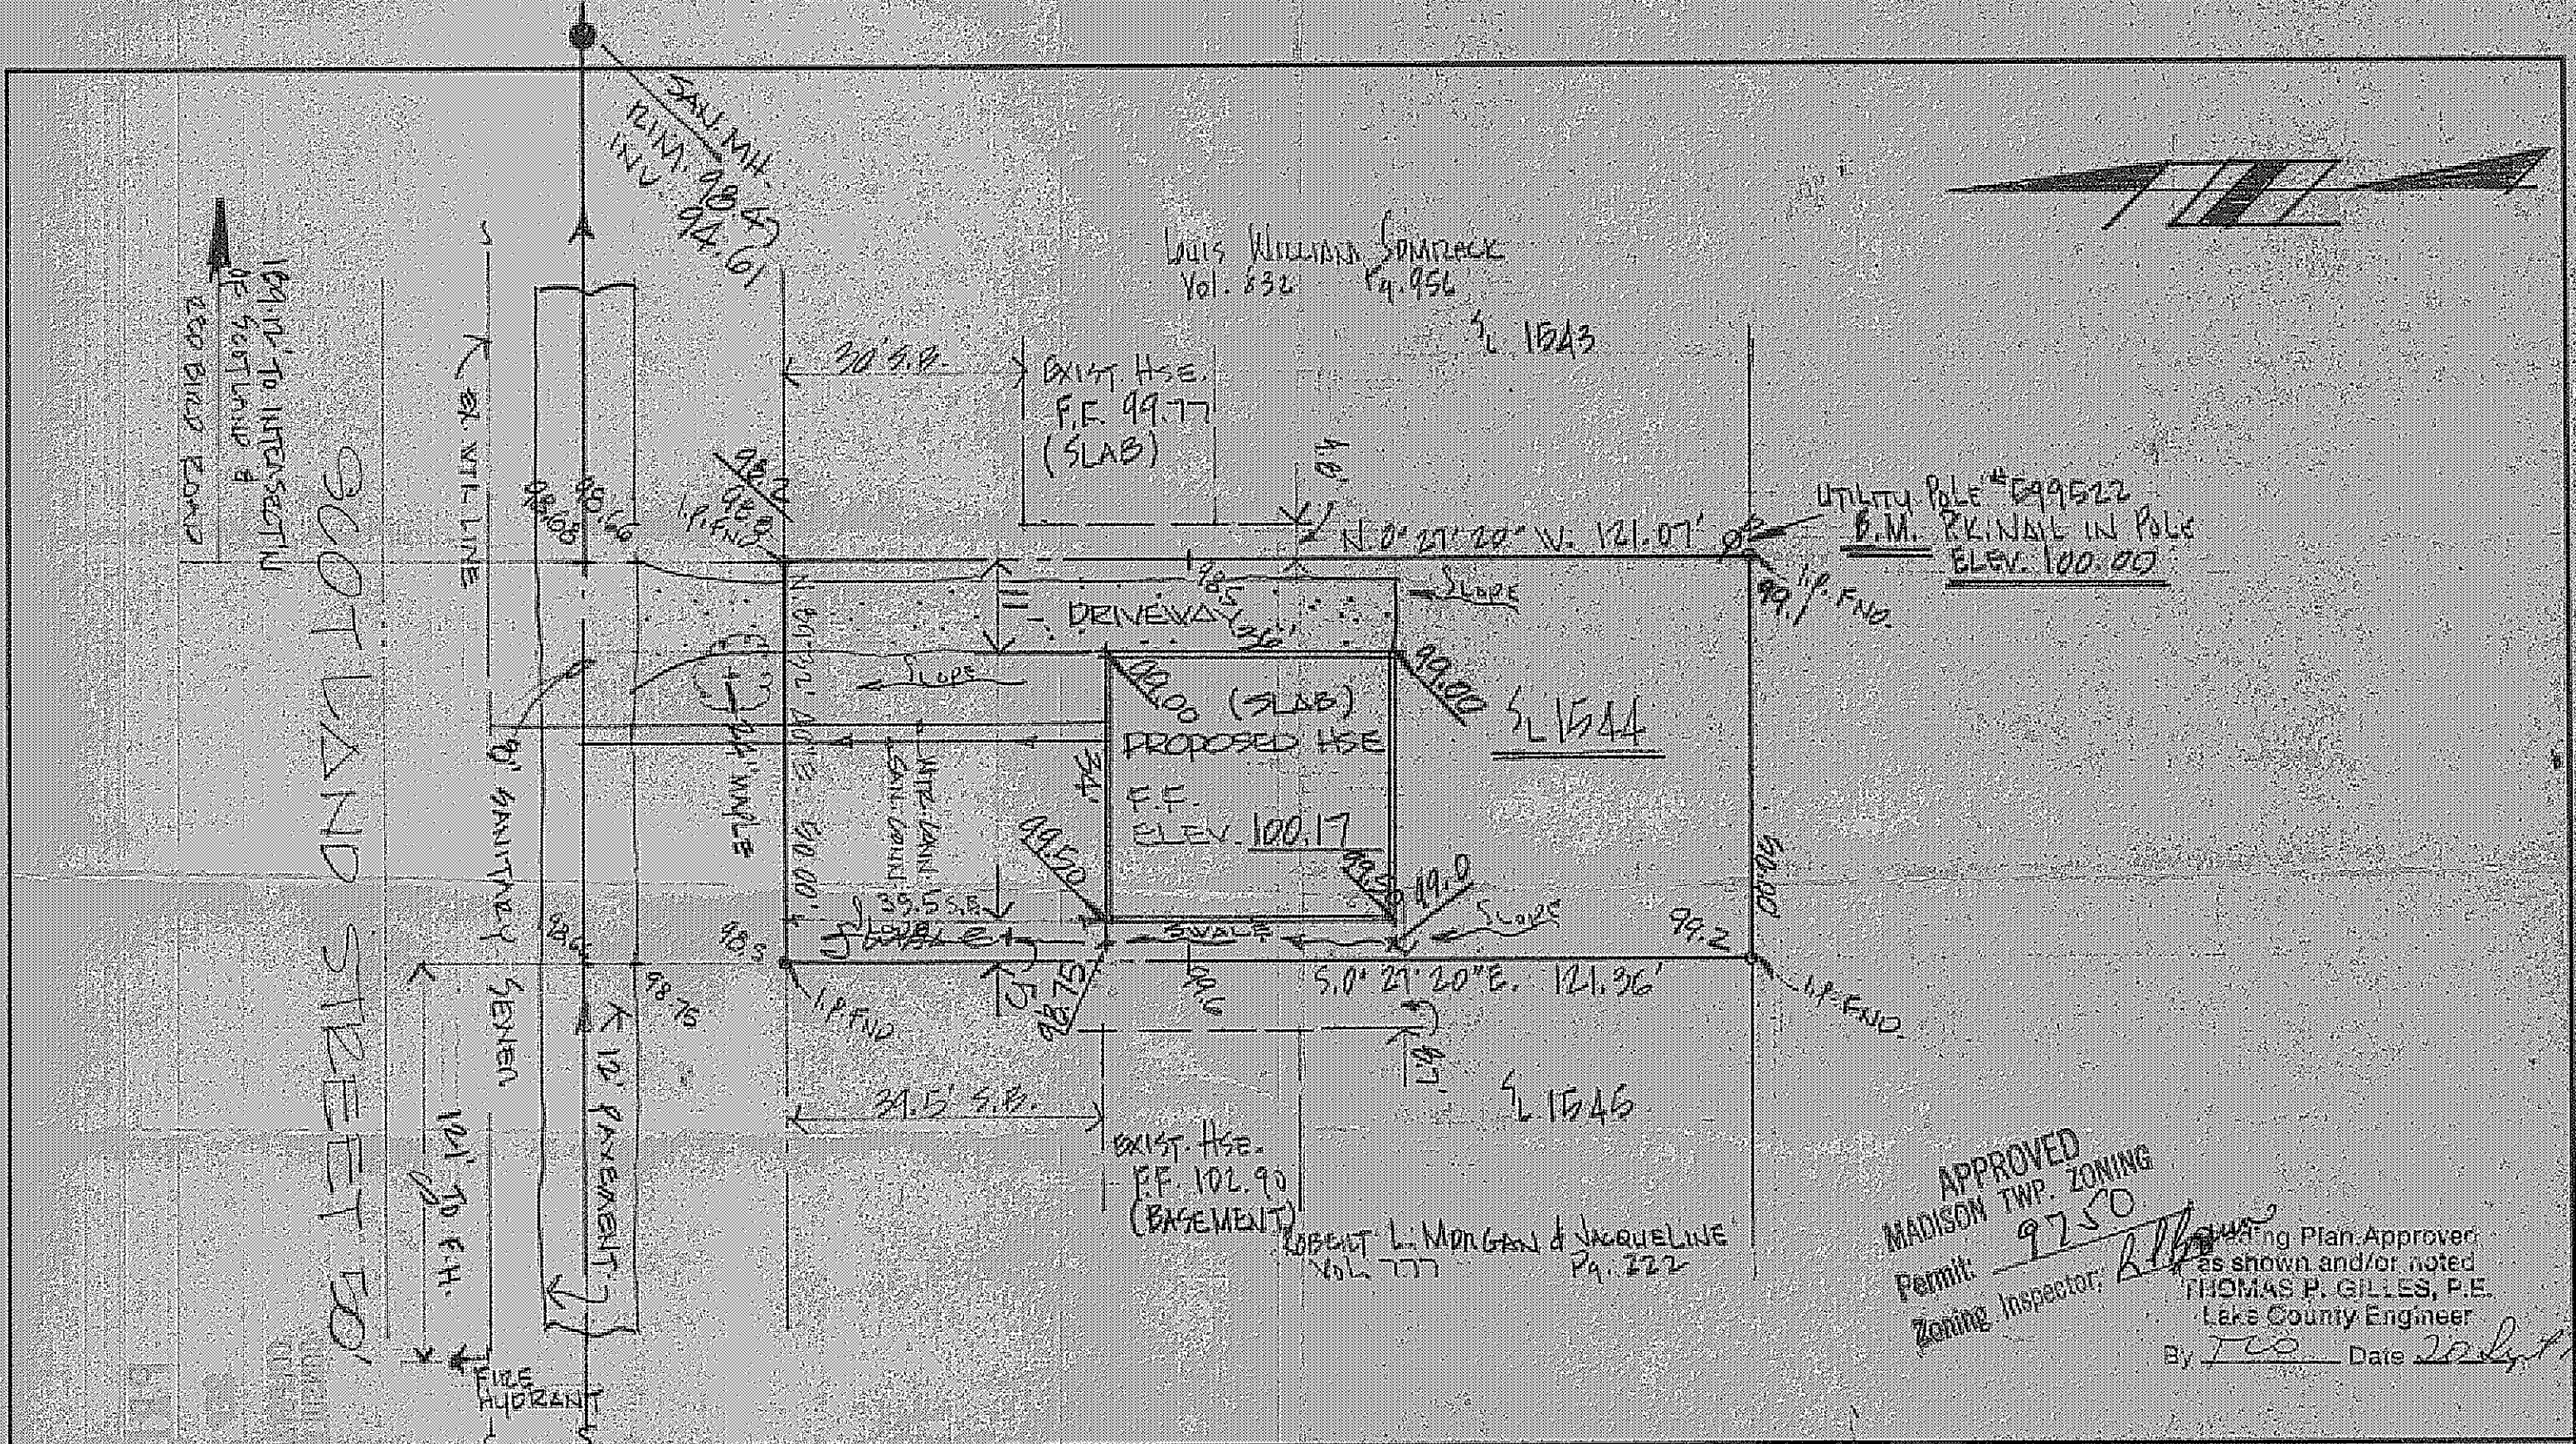

DESIGN CERTIFICATION THIS PLAN WAS PREPARED BY ME, AND IS CORRECT TO THE BEST OF MY KNOWLEDGE AND BELIEF. <i>Robert L. Morgan</i> REG. SURVEYOR NO. 14785	AS BUILT CERTIFICATION I HEREBY CERTIFY THAT THE CIRCLED GRADES ARE EXISTING FINISH GRADES CHECKED IN THE FIELD ON _____ AND THAT SURVEY IS CORRECT TO THE BEST OF MY KNOWLEDGE AND BELIEF. REG. SURVEYOR NO. _____	COLPETZER WOODS CONSULTANTS, INC. 180 SOUTH STATE STREET • PAINESVILLE, OHIO 44077 • (216) 357-7569	DATE: 9/12/77 SCALE: 1"=20' DRAWN BY: <i>CS</i> CHKD. BY: <i>J</i> JOB NO.: 77-230 FB: 312 PG: 1	SITE PLAN FOR WILLIAM SNYDER CHIPPERS ROAD, GREENVILLE, OH. BEING SUBLOT NO. 1544 IN THE MADISON GOLF LAKELANDS SUBD. NO. 2, MADISON TWP., OHIO.
---	--	--	---	---