



Topo Plot Plan
for
GEORGE BERG
Madison Township
Lake Co. Ohio
1" = 30' May 1977

Milton A. Easenhower
Reg. Surveyor 4247

 

Albert H. Cetrini

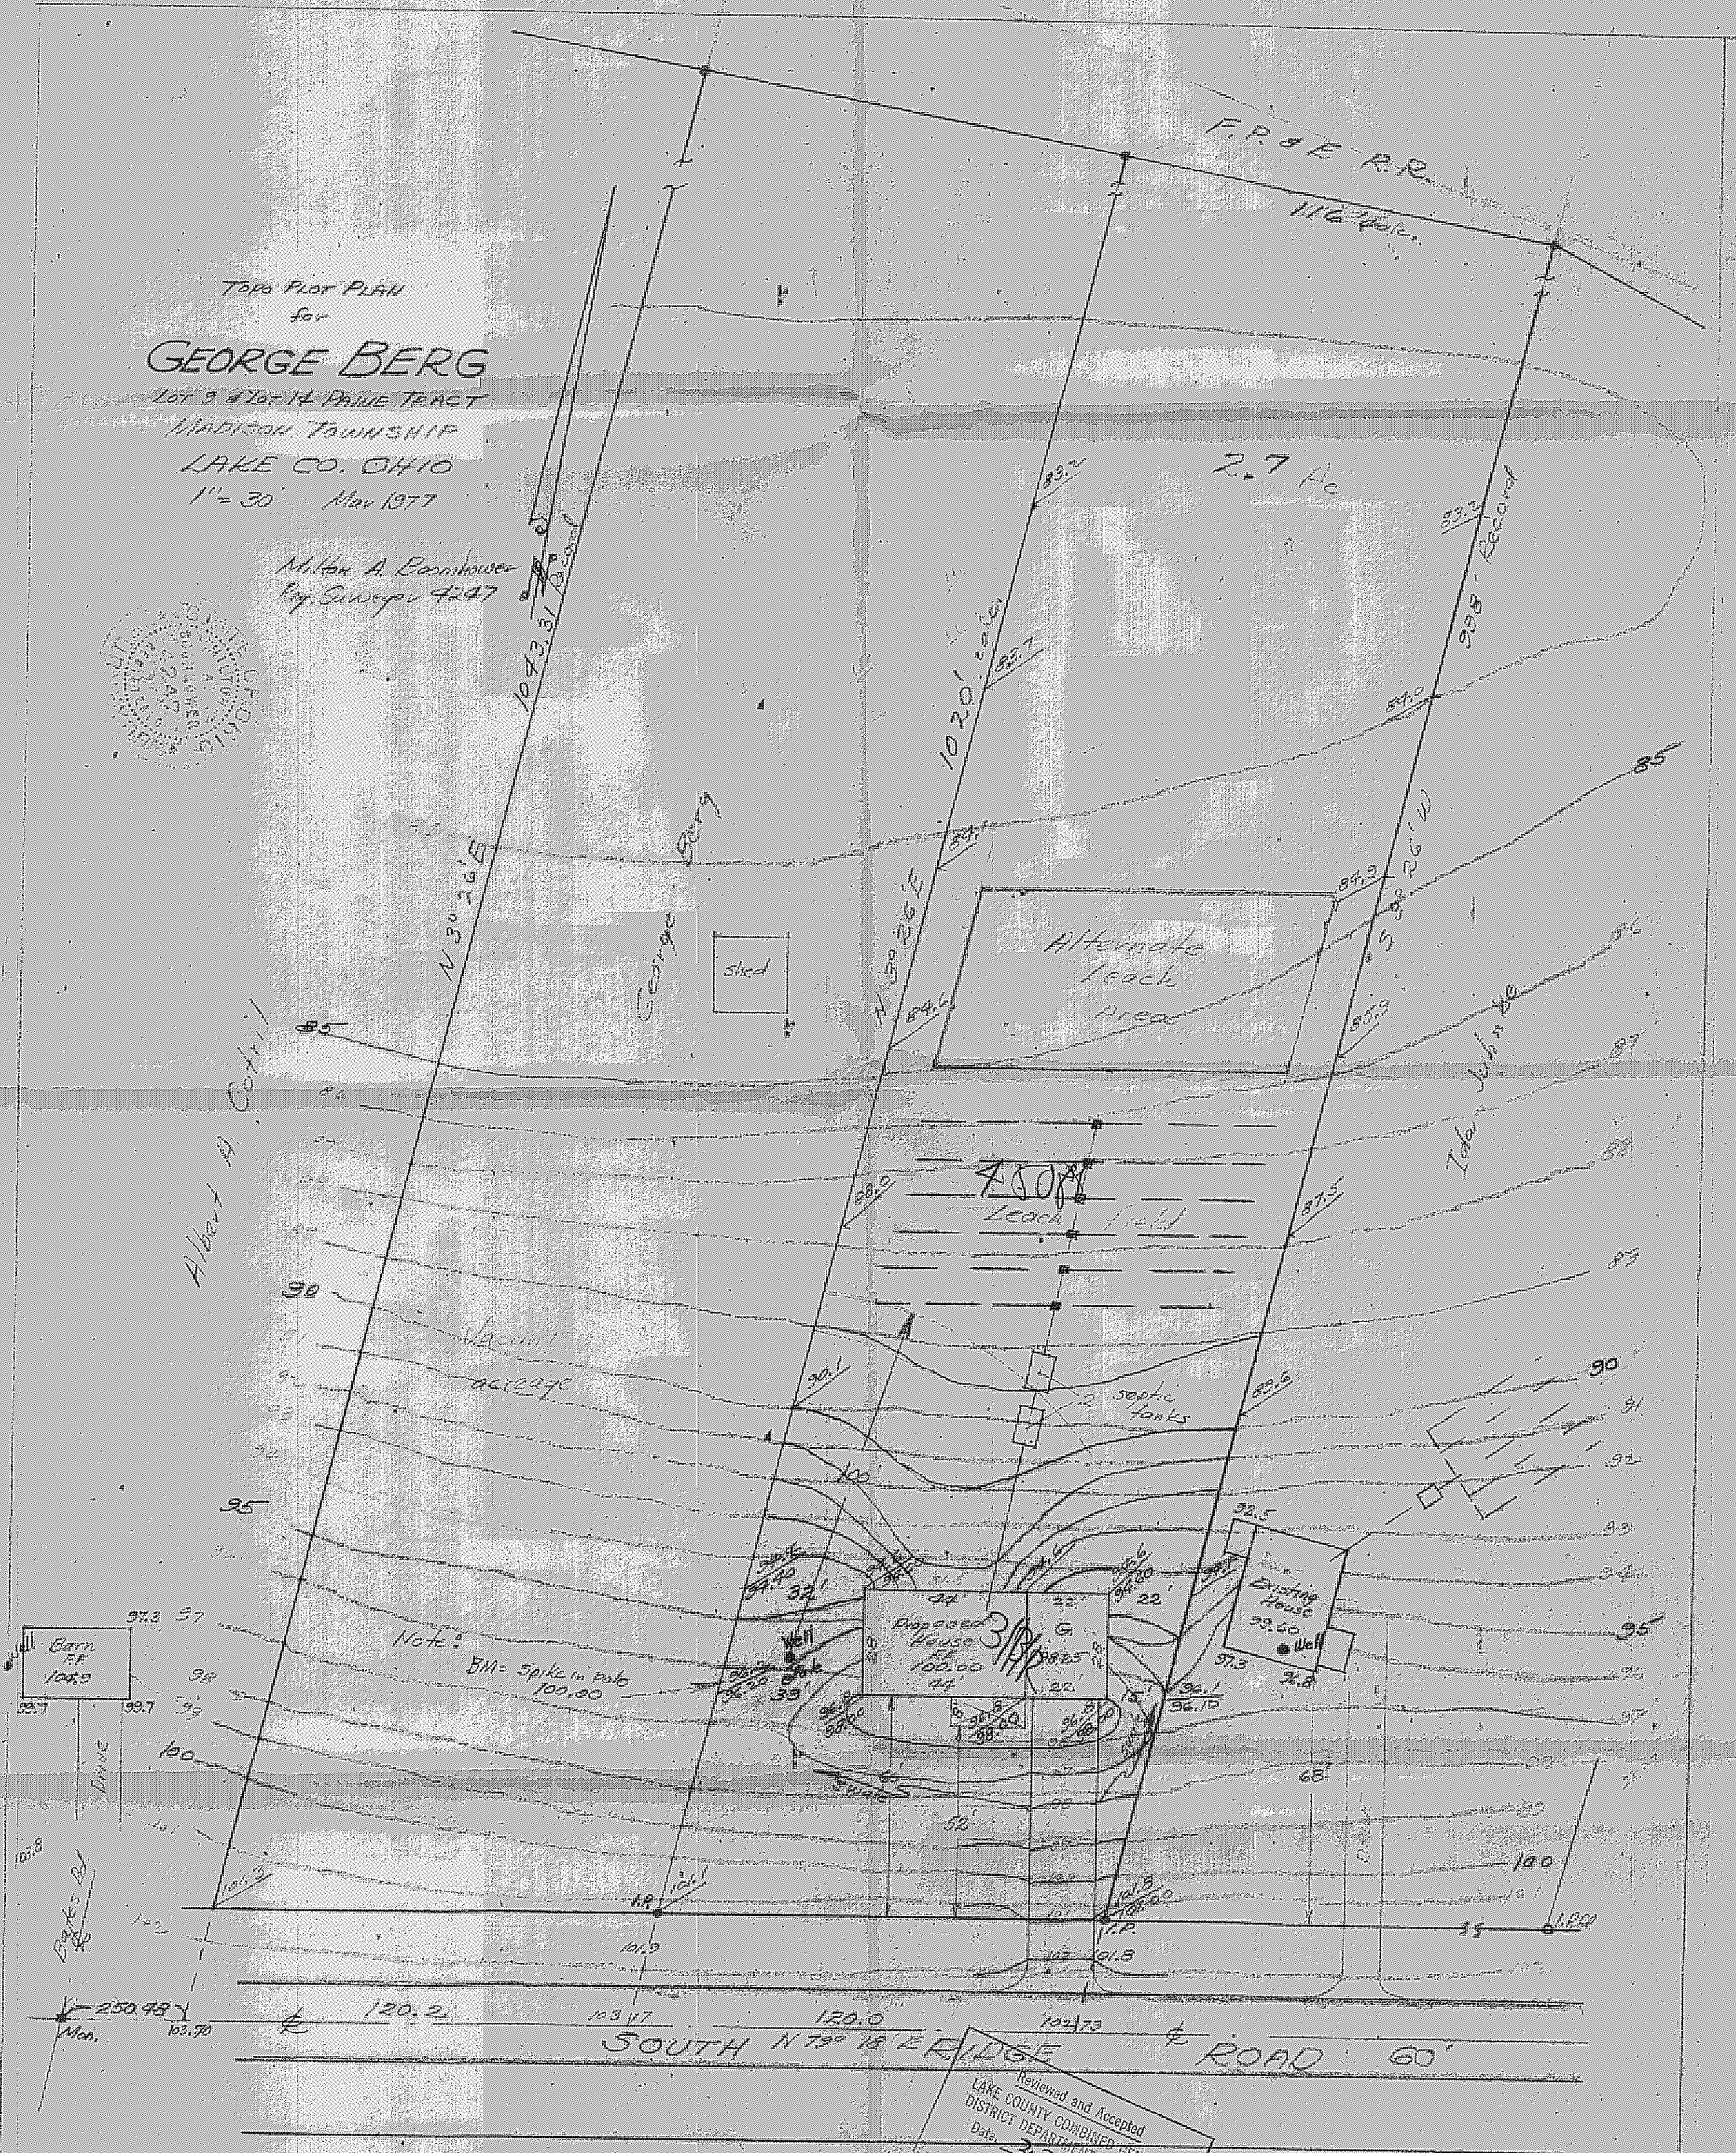

Reviewed and Accepted
LAKE COUNTY COMBINED GENERAL
DISTRICT DEPARTMENT OF HEALTH
Date 3-31-77
By FRED C. KLUTH, M.D.
Health Commissioner

Grading Plan Approved
as shown and/or noted
THOMAS P. GILLES, P.E.
Lake County Engineer
By JWR Date 4-1-77