

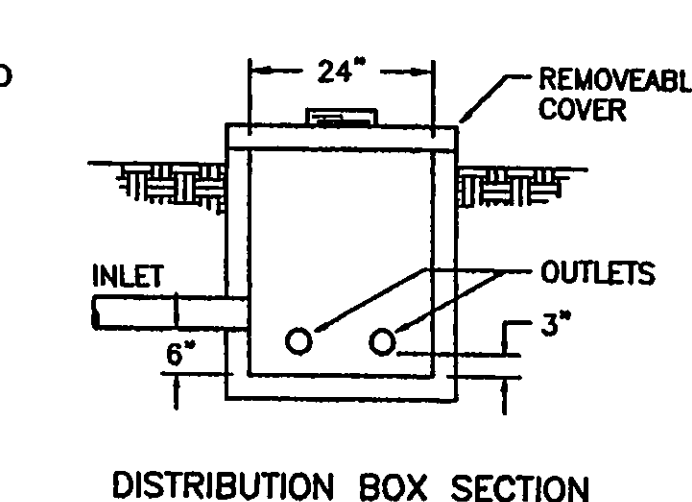
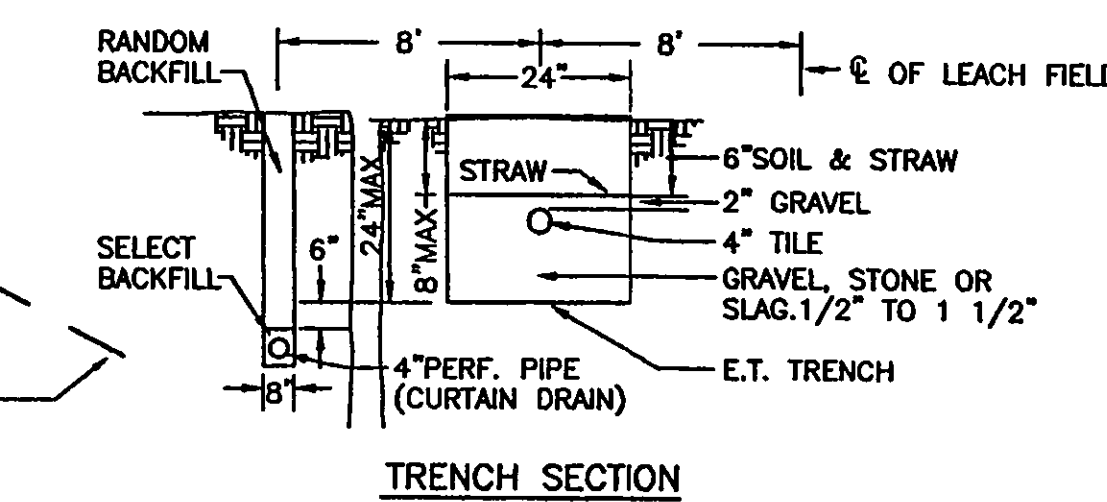


FABRIC FENCE TO BE INSTALLED WITH POSTS, OVERLAPS, AND HARDWARE AS RECOMMENDED BY THE MANUFACTURER. WEIGHT SHALL NOT BE LESS THAN 90 LBS/SY.

### FABRIC FENCE CONTROL DEVICE

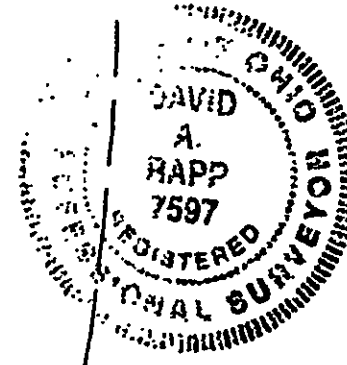

### EVAPO-TRANSPIRATION TILE FIELD

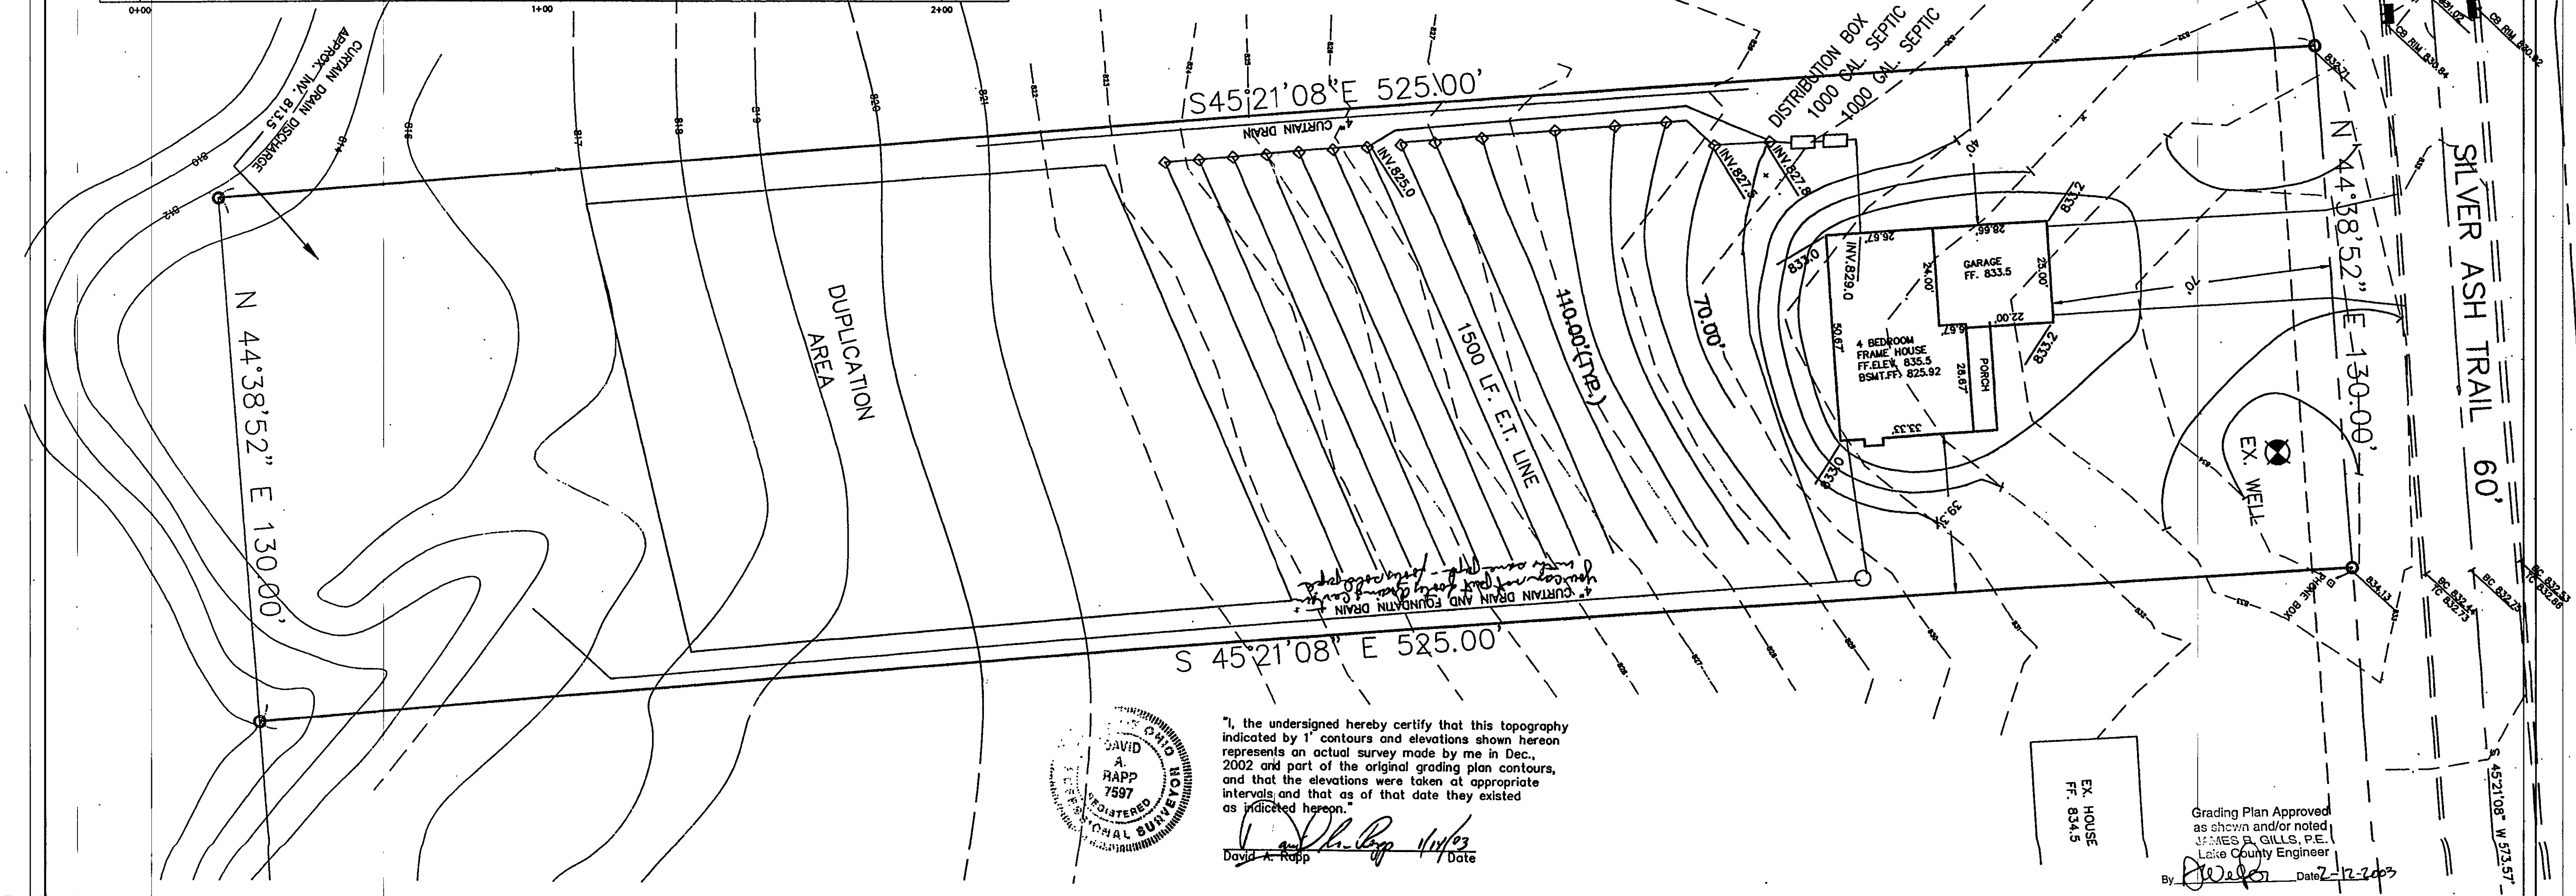

"I, the undersigned hereby certify that this topography indicated by 1' contours and elevations shown hereon represents an actual survey made by me in Dec., 2002 and part of the original grading plan contours, and that the elevations were taken at appropriate intervals and that as of that date they existed as indicated hereon.

David A. Rapp 1/11/03 Date

Grading Plan Approved as shown and/or noted by JAMES A. GILLS, P.E., Lake County Engineer. By: [Signature] Date: 12-2-03

DATE: Dec. 2002 DRAWN BY: CHECKED BY: APPROVED BY: P.S. No. 7597	BRIAN AND JOSETTE BRICKMAN 325 E. 262nd Street Euclid, Ohio 44132	SILVER ASH FARMS SUBLOT 5 MADISON TOWNSHIP	SITE PLAN APPROVED TOWNSHIP ZONING DATE: 1/11/03 BY: [Signature] 2/23/06	23000 SHEET NO. 1 OF 1
--	---	--	---	---------------------------