SITE PLAN
FOR
JOE WELCH

LOT 3 MADISON-TOWNLINE ESTATES

TODD DRIVE MADISON TWP. LAKE CO. O.

20 JULY 1994 SCALE 1"=20 ft.

A. To be brought to finished grade
1. Septic tank manhole covers
2. Splitter box cover
3. Distribution box cover
B. No footer drains or downspouts to be discharged into septic tanks
C. All waste water to be discharged into septic tanks

APPROVED
MADISON TWP. ZONING
Permit: 14278
Zoning Inspector: [illegible]
AUG 12 1994

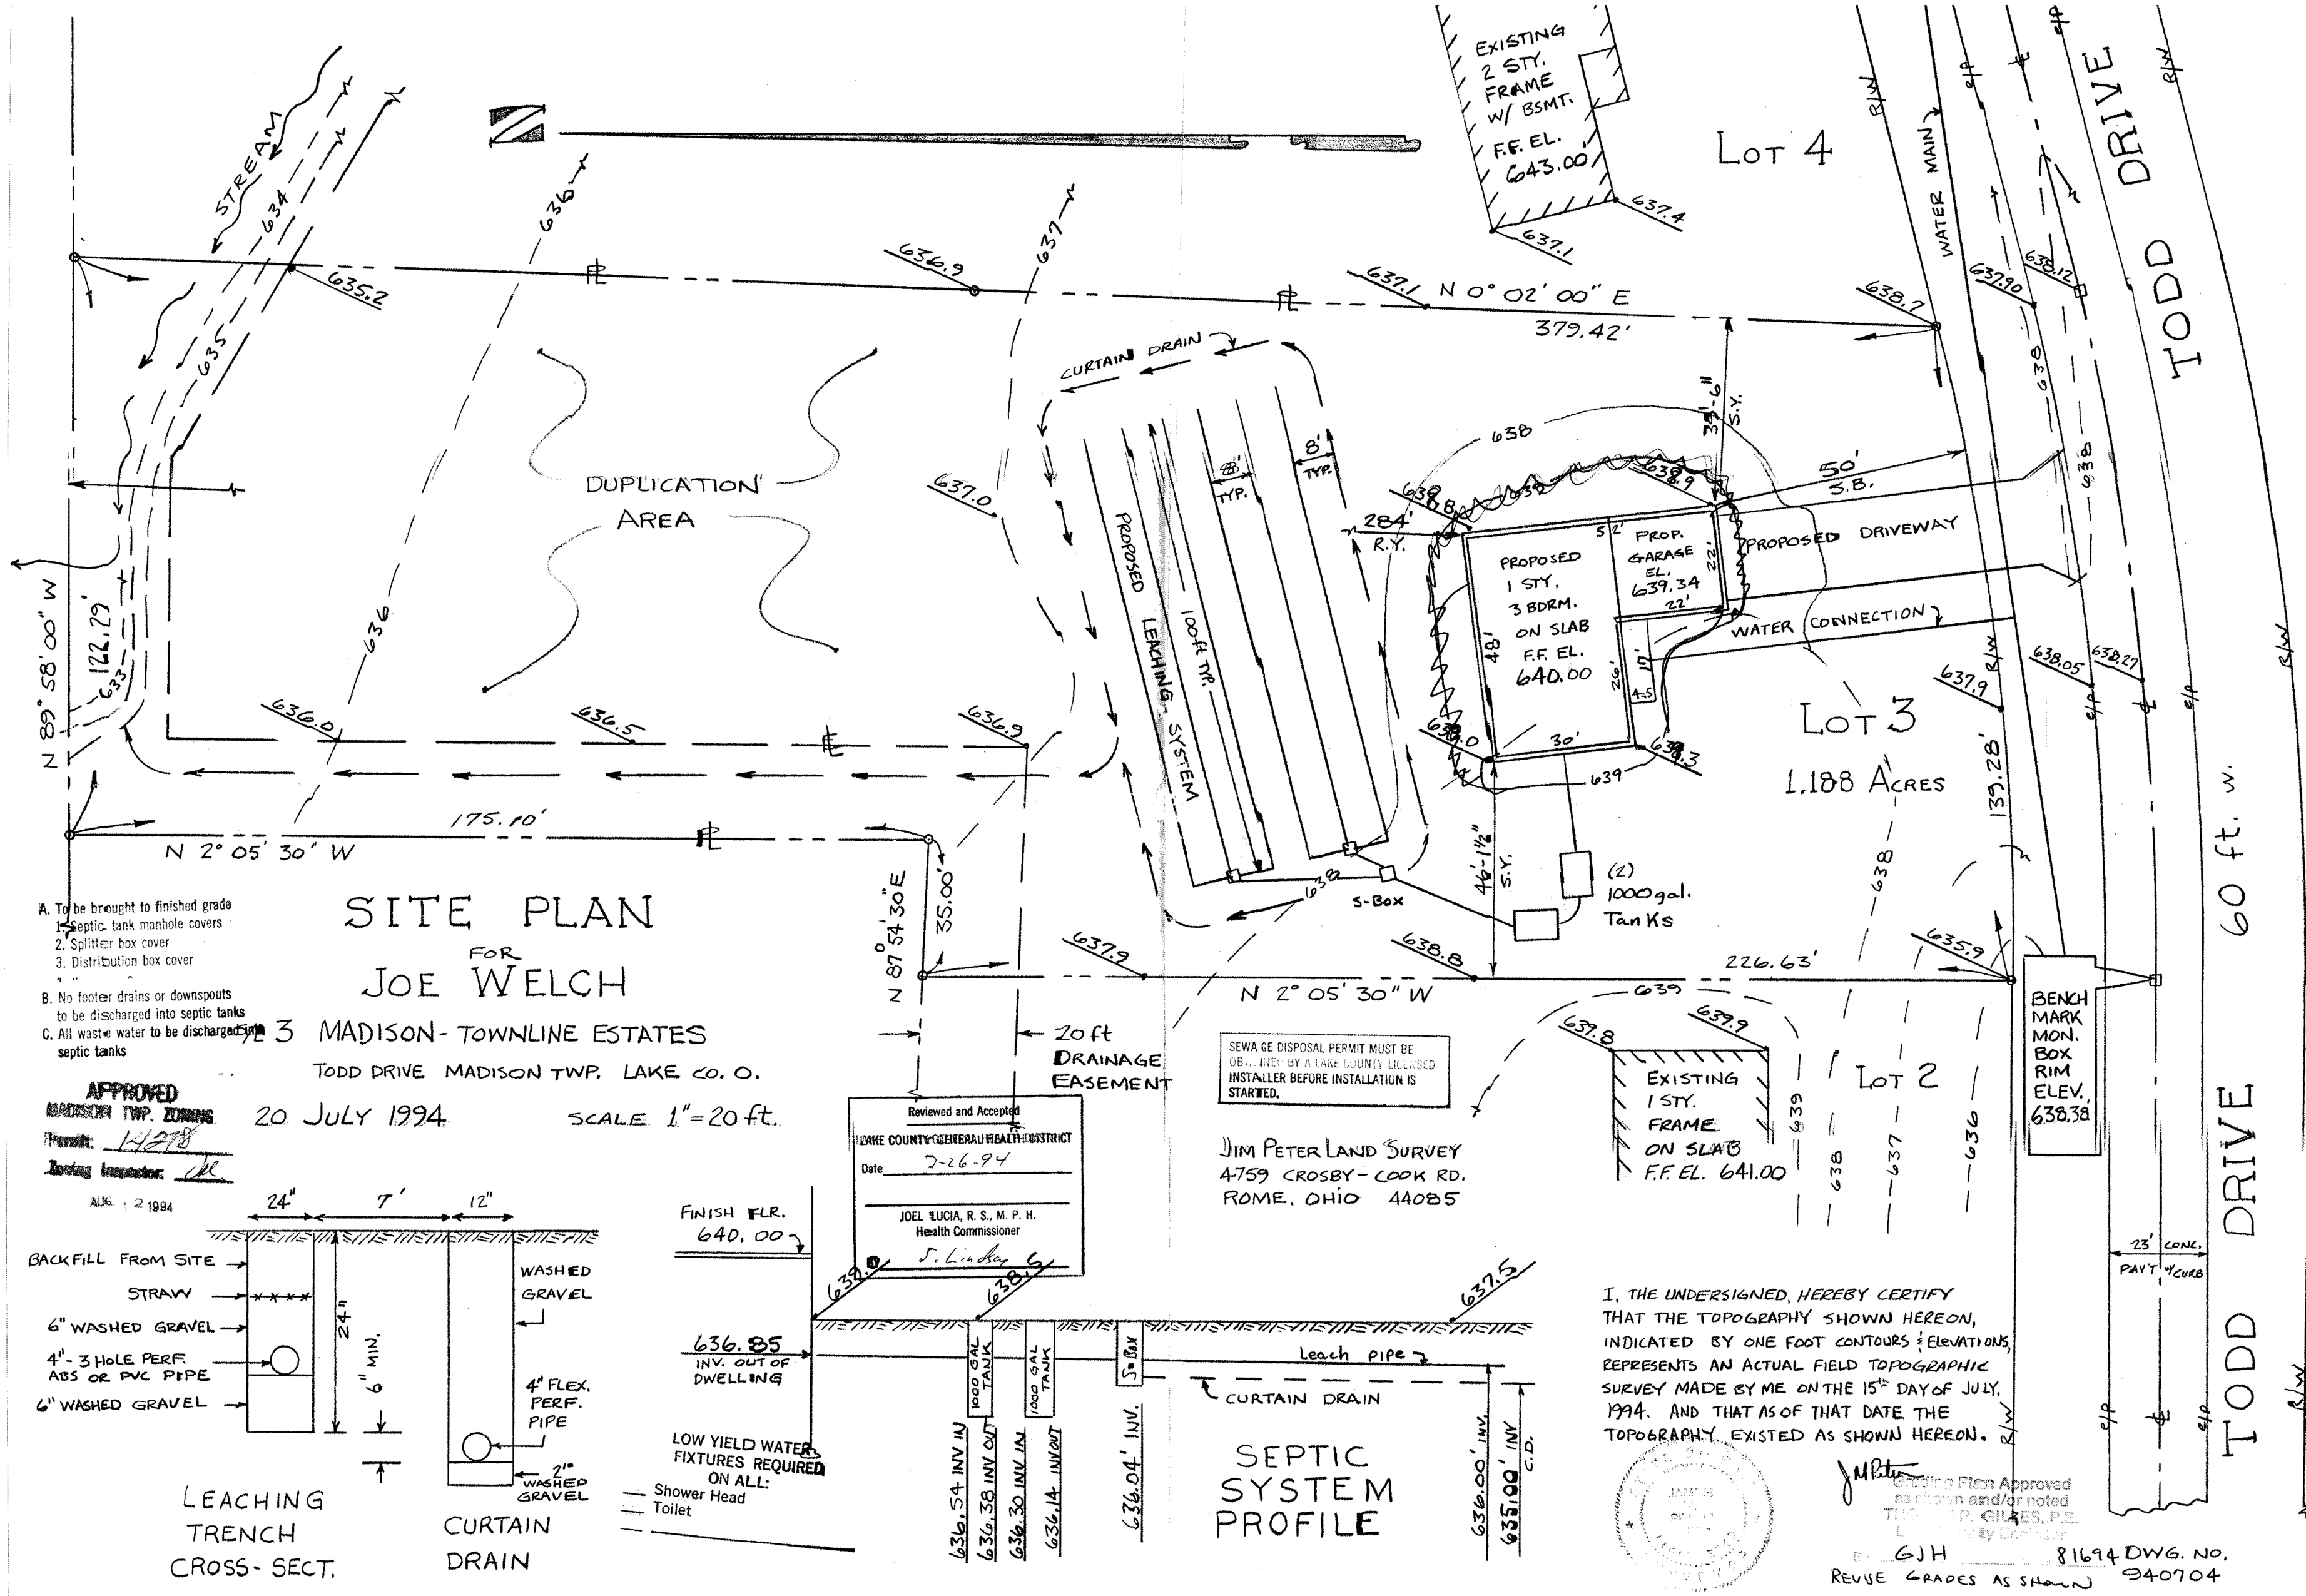

SEWAGE DISPOSAL PERMIT MUST BE OBTAINED BY A LAKE COUNTY LICENSED INSTALLER BEFORE INSTALLATION IS STARTED.

Reviewed and Accepted
LAKE COUNTY GENERAL HEALTH DISTRICT
Date 7-26-94
JOEL LUCIA, R. S., M. P. H.
Health Commissioner
S. Lindsay

JIM PETER LAND SURVEY
4759 CROSBY-COOK RD.
ROME, OHIO 44085

LEACHING TRENCH CROSS-SECT.

CURTAIN DRAIN

LOW YIELD WATER FIXTURES REQUIRED ON ALL:
— Shower Head
— Toilet

SEPTIC SYSTEM PROFILE

I, THE UNDERSIGNED, HEREBY CERTIFY THAT THE TOPOGRAPHY SHOWN HEREON, INDICATED BY ONE FOOT CONTOURS & ELEVATIONS, REPRESENTS AN ACTUAL FIELD TOPOGRAPHIC SURVEY MADE BY ME ON THE 15th DAY OF JULY, 1994. AND THAT AS OF THAT DATE THE TOPOGRAPHY EXISTED AS SHOWN HEREON.

JM Peter

Grading Plan Approved as shown and/or noted
THOMAS P. GILLES, P.E.
Lake County Engineer
By [illegible] Date [illegible]

GJH 81694 DWG. NO. 940704
REVISE GRADES AS SHOWN