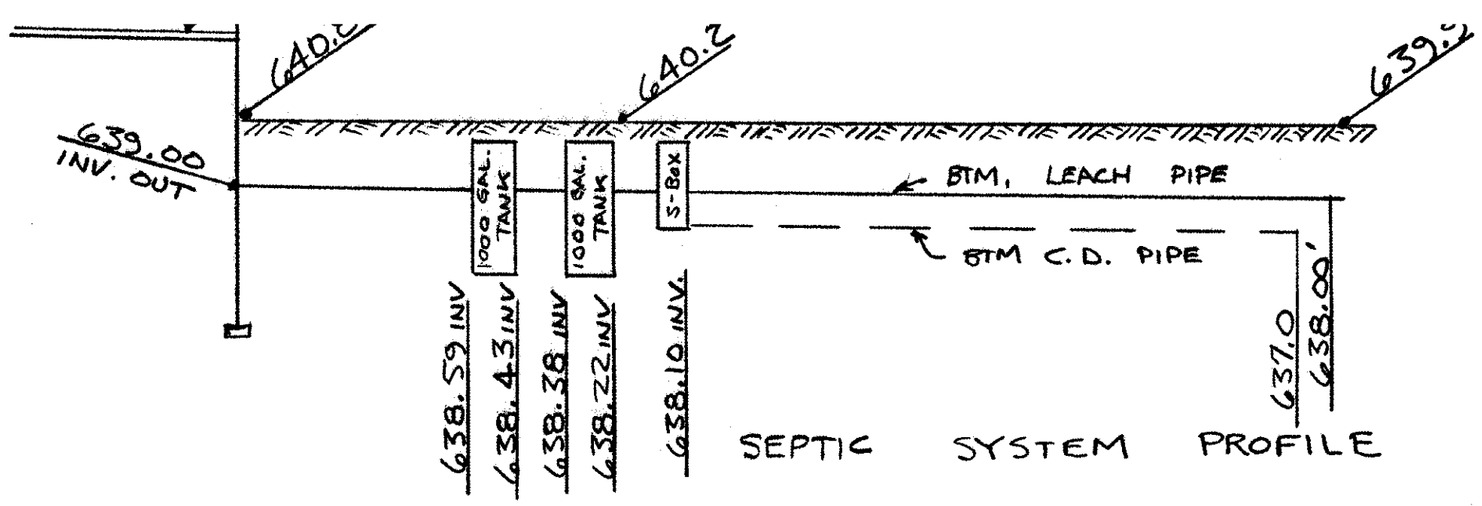

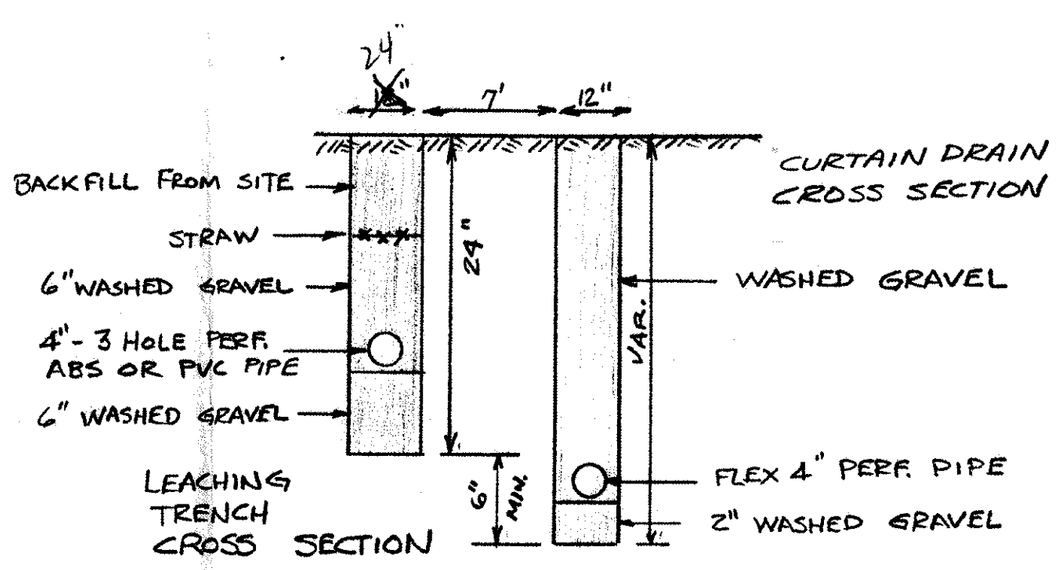

APPROVED
MADISON TOWNSHIP ZONING
JUN 13 1996
PERMIT # 1495
ZONING INSPECTOR

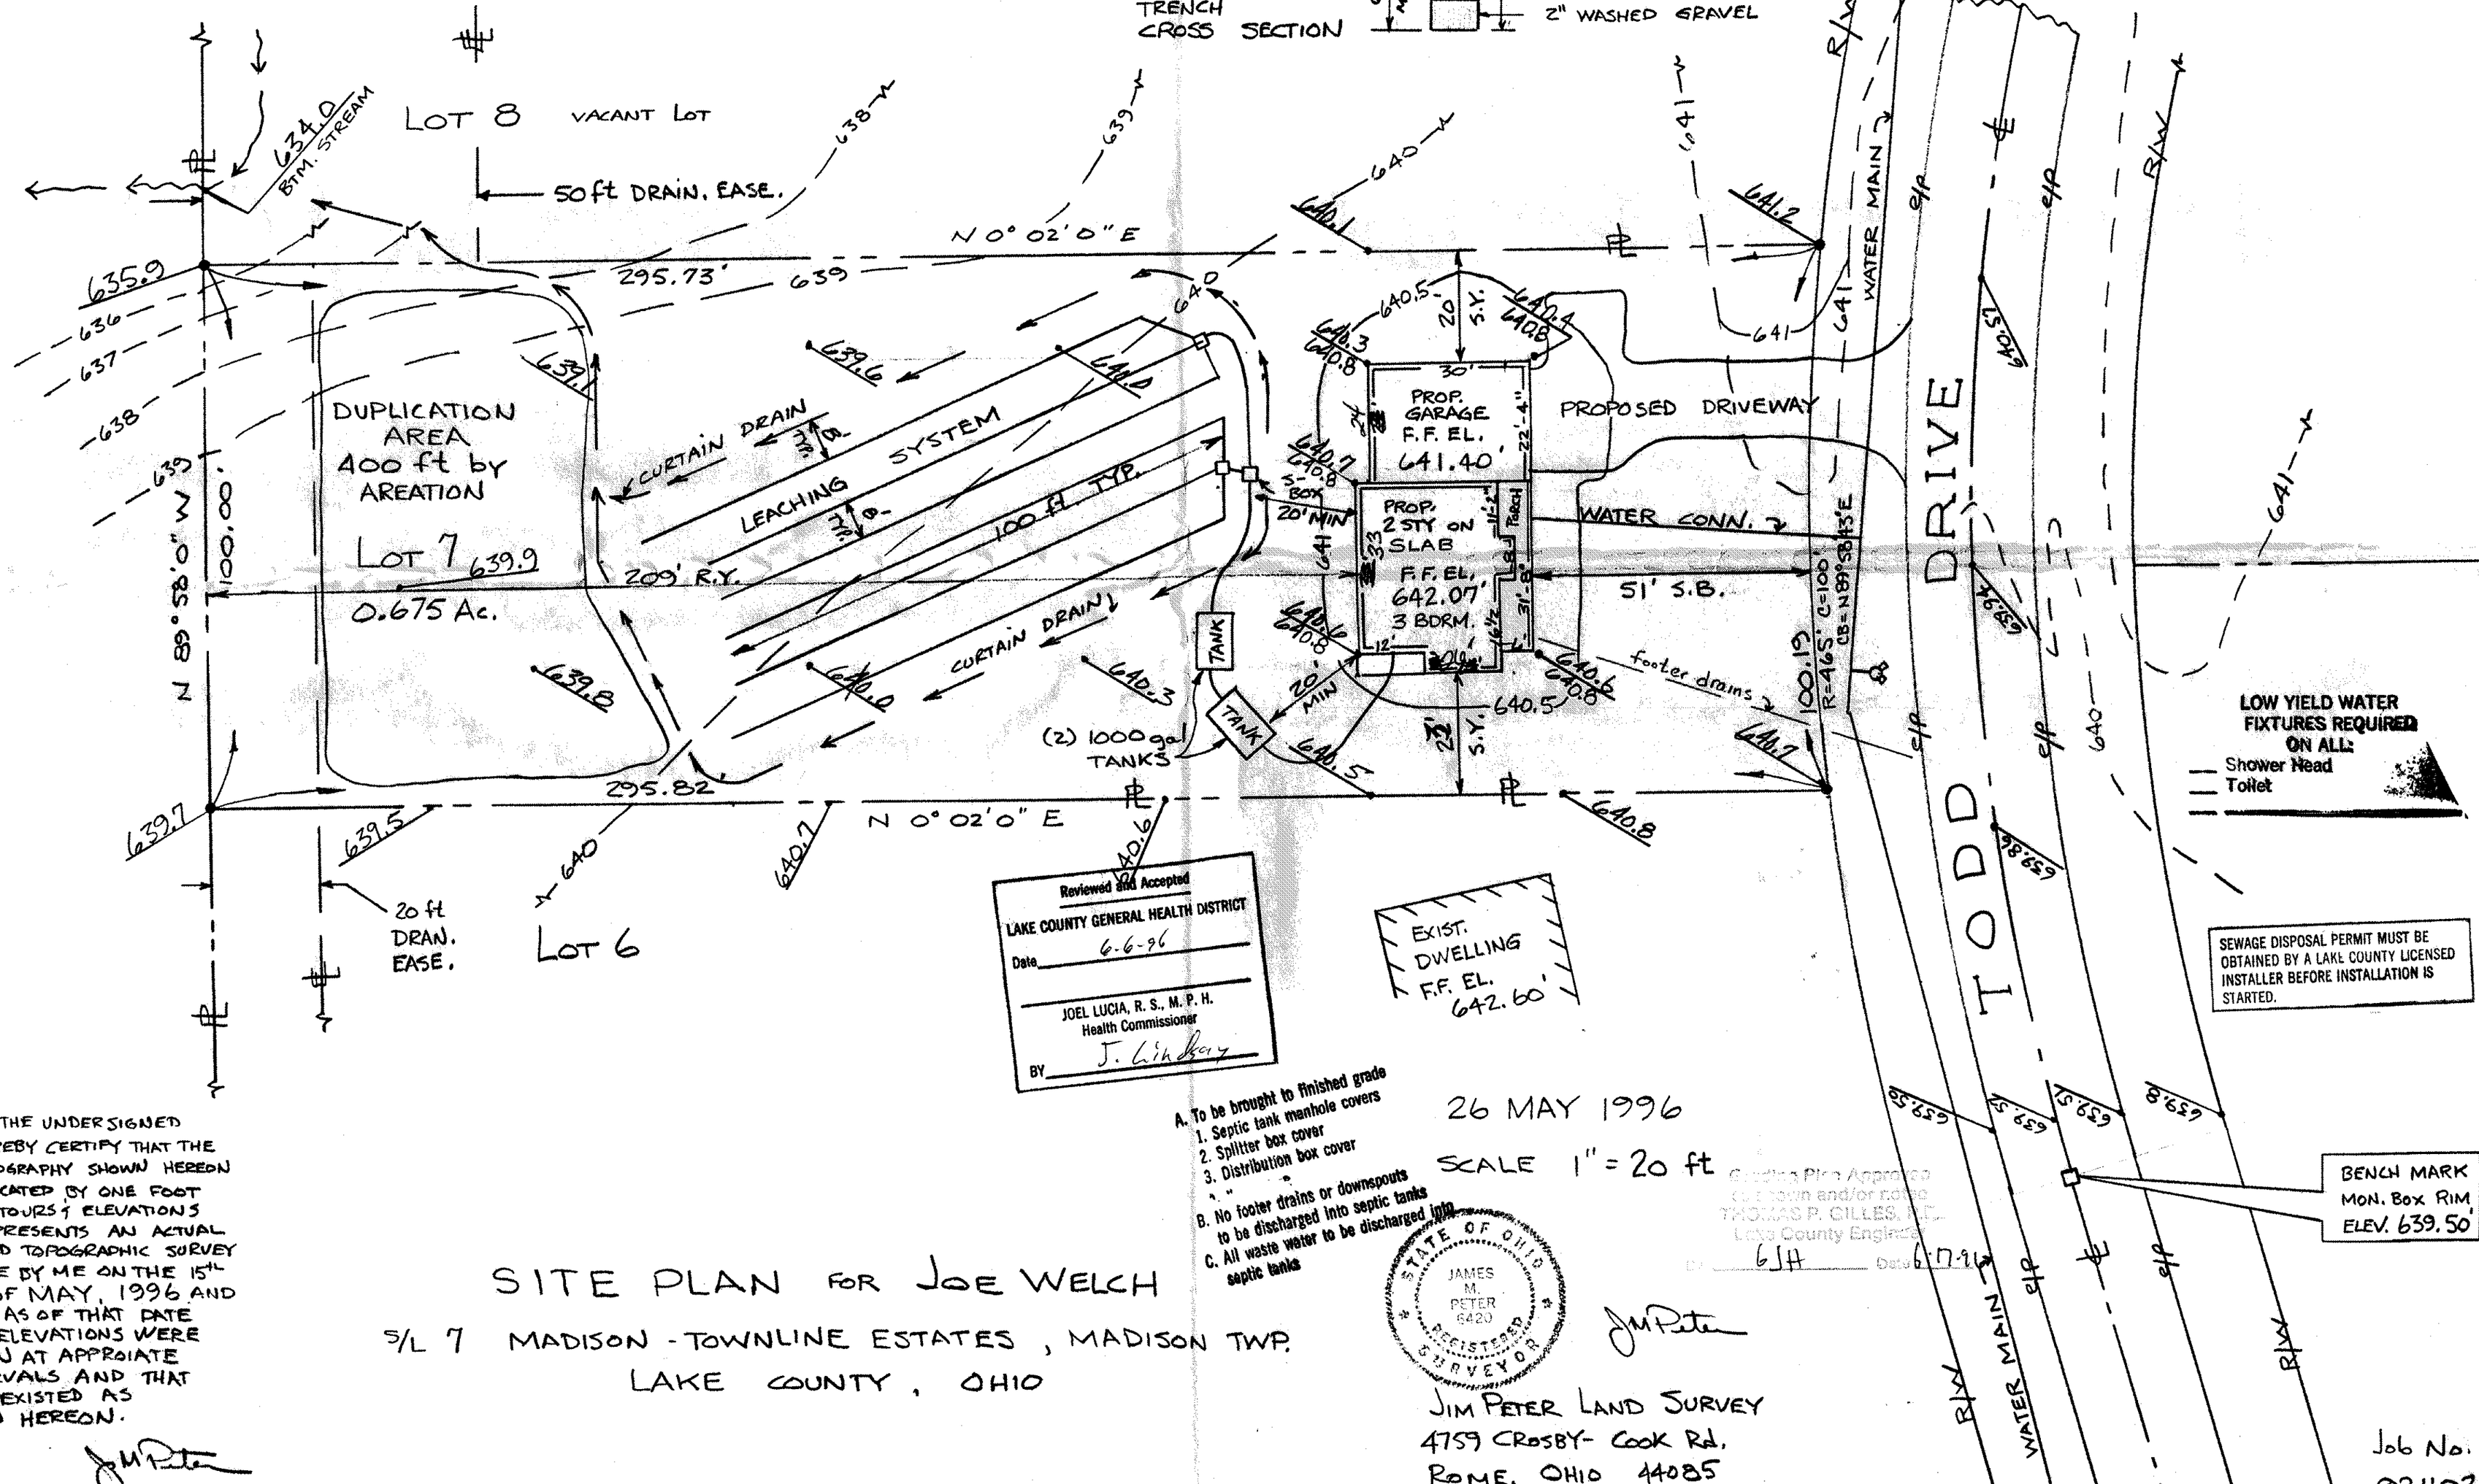

Reviewed and Accepted
LAKE COUNTY GENERAL HEALTH DISTRICT
Date 6-6-96
JOEL LUCIA, R. S., M. P. H.
Health Commissioner
BY J. Lindsay

EXIST. DWELLING F.F. EL. 642.60'

LOW YIELD WATER FIXTURES REQUIRED ON ALL:
— Shower Head
— Toilet

SEWAGE DISPOSAL PERMIT MUST BE OBTAINED BY A LAKE COUNTY LICENSED INSTALLER BEFORE INSTALLATION IS STARTED.

BENCH MARK
MON. Box RIM
ELEV. 639.50'

A. To be brought to finished grade
1. Septic tank manhole covers
2. Splitter box cover
3. Distribution box cover
" "
B. No footer drains or downspouts to be discharged into septic tanks
C. All waste water to be discharged into septic tanks

26 MAY 1996

SCALE 1" = 20 ft

Grading Plan Approved
as shown and/or noted
THOMAS P. GILLES, P.E.
Lake County Engineer
By GJH Date 6-17-96

I, THE UNDERSIGNED HEREBY CERTIFY THAT THE TOPOGRAPHY SHOWN HEREON INDICATED BY ONE FOOT CONTOURS / ELEVATIONS REPRESENTS AN ACTUAL FIELD TOPOGRAPHIC SURVEY MADE BY ME ON THE 15th DAY OF MAY, 1996 AND THAT AS OF THAT DATE THE ELEVATIONS WERE TAKEN AT APPROIATE INTERVALS AND THAT THEY EXISTED AS SHOWN HEREON.

JAMES M. PETER 6420 REGISTERED SURVEYOR STATE OF OHIO

SITE PLAN FOR JOE WELCH

S/L 7 MADISON - TOWNLINE ESTATES, MADISON TWP.
LAKE COUNTY, OHIO

JIM PETER LAND SURVEY
4759 CROSBY-COOK Rd.
ROME, OHIO 44085

Job No.
921102