SUBLOT NO.

73


0.6695 AC.

(VACANT)

I PIN SET . T.O.B

LIMITS OF LAKE ERIE

COASTAL EROSION AREA

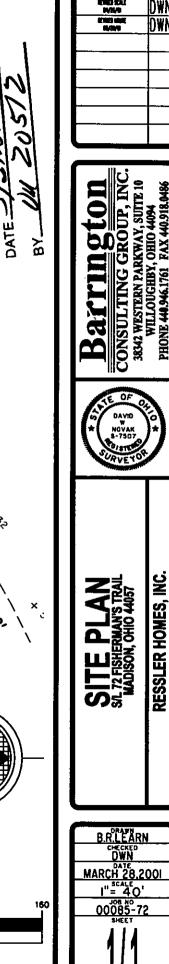

00085-72

REVISIONS

**SONING** 

MADISON

Lake erie

EXIST EDGE OF WATER

\* |8

Barrington

GRAPHIC SCALE

( IN FEET )

1 inch = 40 ft.

FORM C \SCI2\LIBRARY\FORMS\BCGA3-1 DWG

**Grading Plan Approved** 

as shown and/or noted

JAMES R. GILLS, R.E.

Lake County Engineer