SITE PLAN

MADISON TOWNSHIP, LAKE COUNTY, OHIO

for: MR. RAWLINS
CLIENT OWNER

ADDRESS STREET CITY ZIP

SUBDIVISION NAME TRACT STREET
2 WOOD ROAD
SUBLOT NO. STREET VOL.-PG. PERM. PARCEL NO.

CURTAIN DRAIN
CROSS SECTION

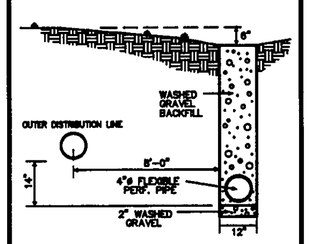

LEACHING TRENCH
CROSS SECTION

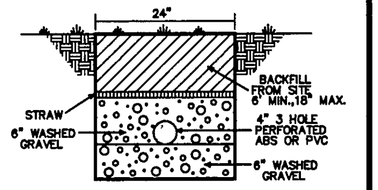

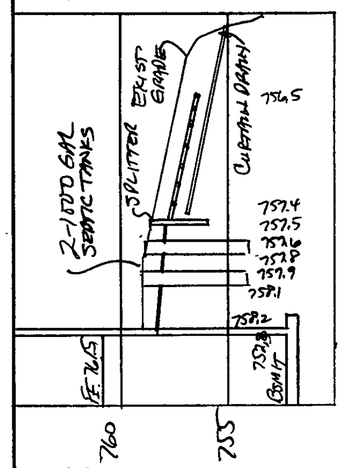
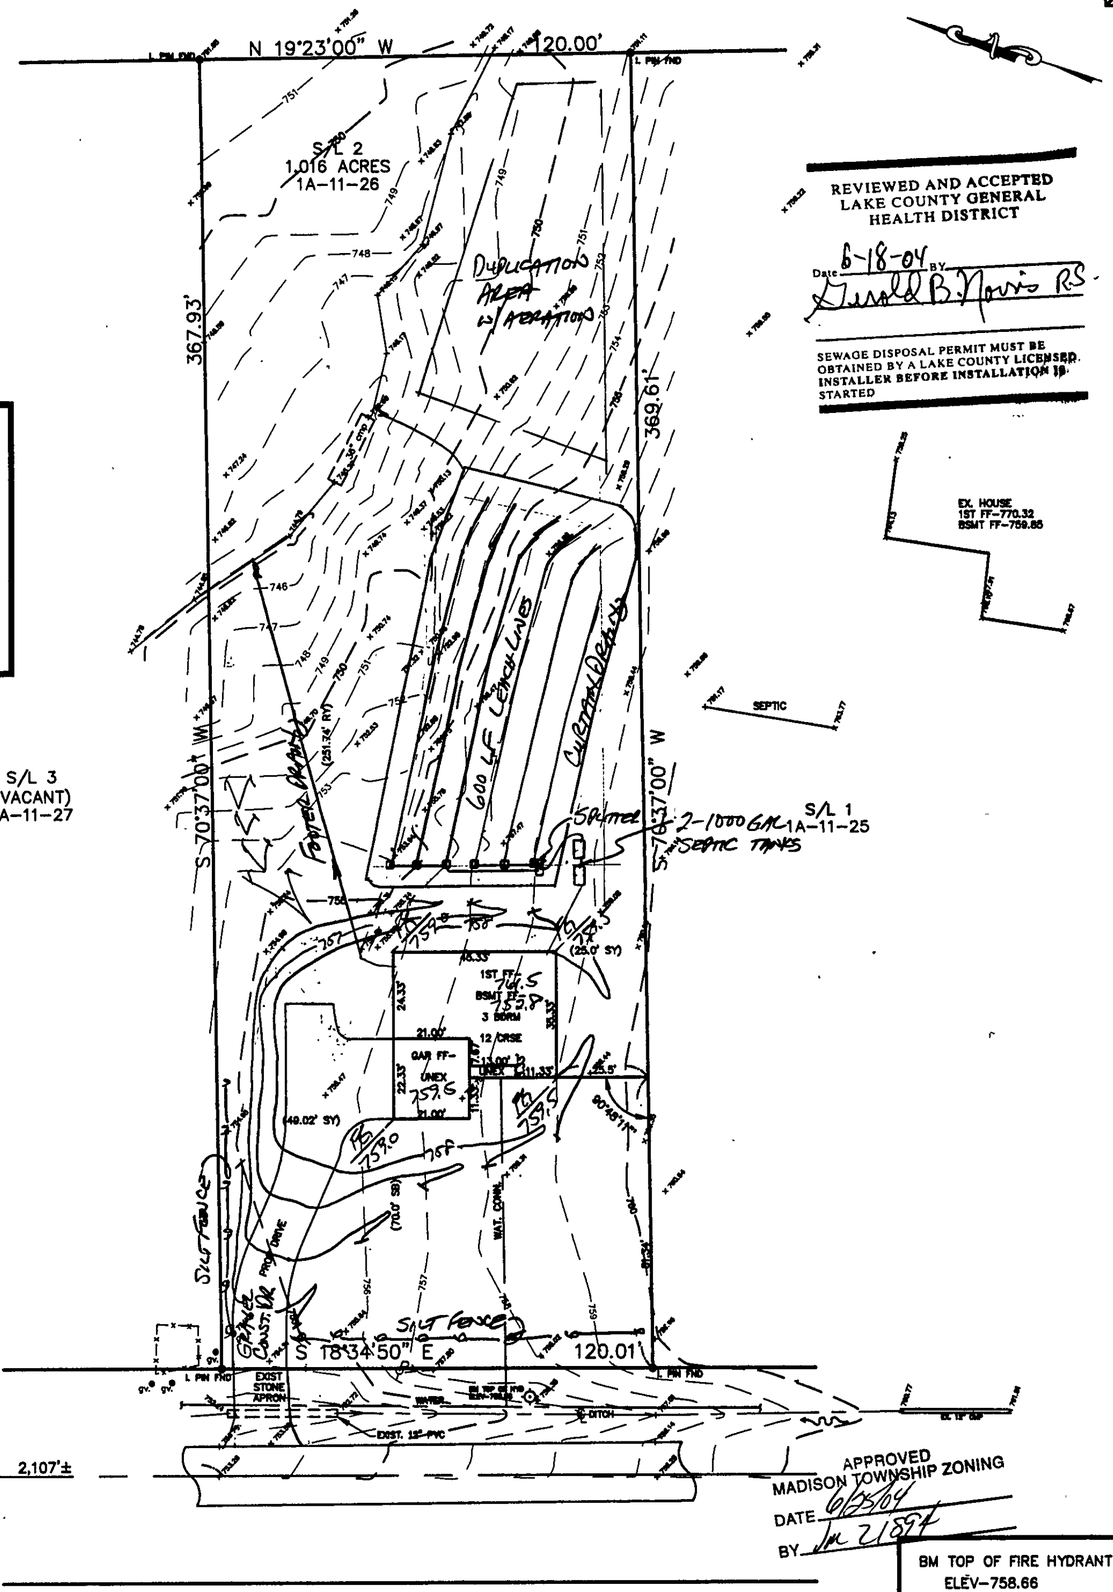
HYDRAULIC PROFILE
HOR. 1"=30' / VERT. 1"=5'