SITE PLAN
FOR ED BUGOS

OF SUBLOT NOS 349 AND 350 IN THE SIXTH SALIDA SUBDIVISION AS SHOWN BY THE PLAT RECORDED IN VOL C PAGE 62 OF L.C.M.R. PARCEL LOCATED IN THE CITY OF MENTOR-ON-THE-LAKE, OHIO OCT, 2003

NOTES

PROPOSED / EXISTING GROUND GRADES

OVERLAND DRAINAGE FLOW

BENCH MARK TOP AND FRONT OF SUBLOT NO 316 ELEV 604.15

601.0 EXISTING CONTOURS

601.0 PROPOSED CONTOURS

IPS = 5/8" IRON PIN SET WITH CAP

ROOF DRAINS SHALL DISCHARGE TO SPLASH BLOCKS

CONTACT OUPS. TWO WORKING DAYS BEFORE DIGGING 1-800-362-2764

CERTIFY THAT THE BOUNDARY SURVEY IS IN ACCORDANCE WITH CURRENT MINIMUM STANDARDS FOR BOUNDARY SURVEYS IN THE STATE OF OHIO

Ralph W Kempke P.S 6257

I CERTIFY THAT ACTUAL FIELD OBSERVATION OF ELEVATIONS HAVE BEEN MADE BY ME ON THE CIRCLE GRADES ACCURATELY DEPICT THE AS-BUILTS CONDITIONS OBSERVED BY ME ON ?

Ralph W Kempke P.S 6257
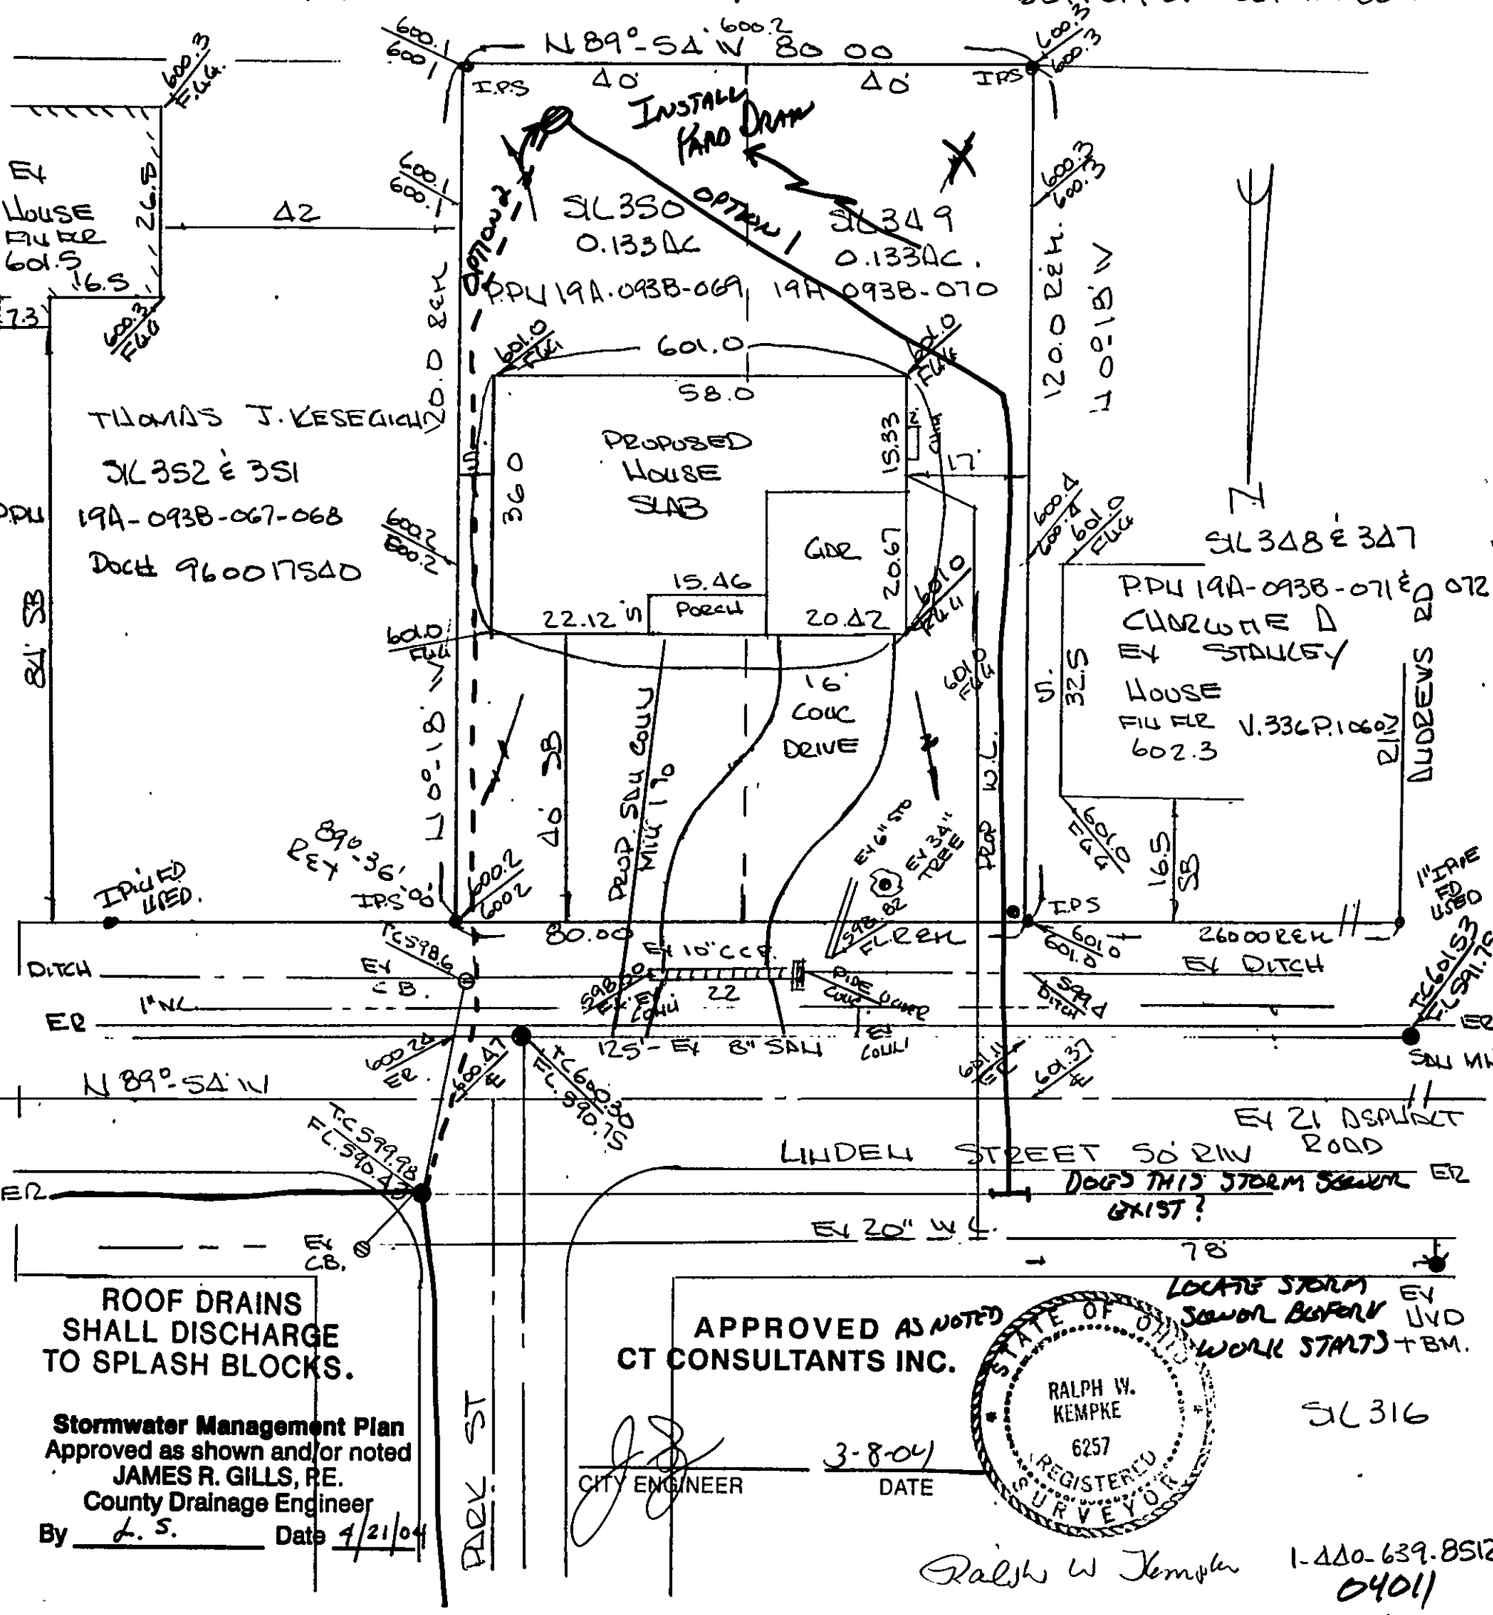
FINISH FLOOR GRADES
GARAGE FLOOR 601.08
1ST FLOOR 602.00
BOTTOM OF FOOTER. 604.30