




ALLEN AVE. 60'

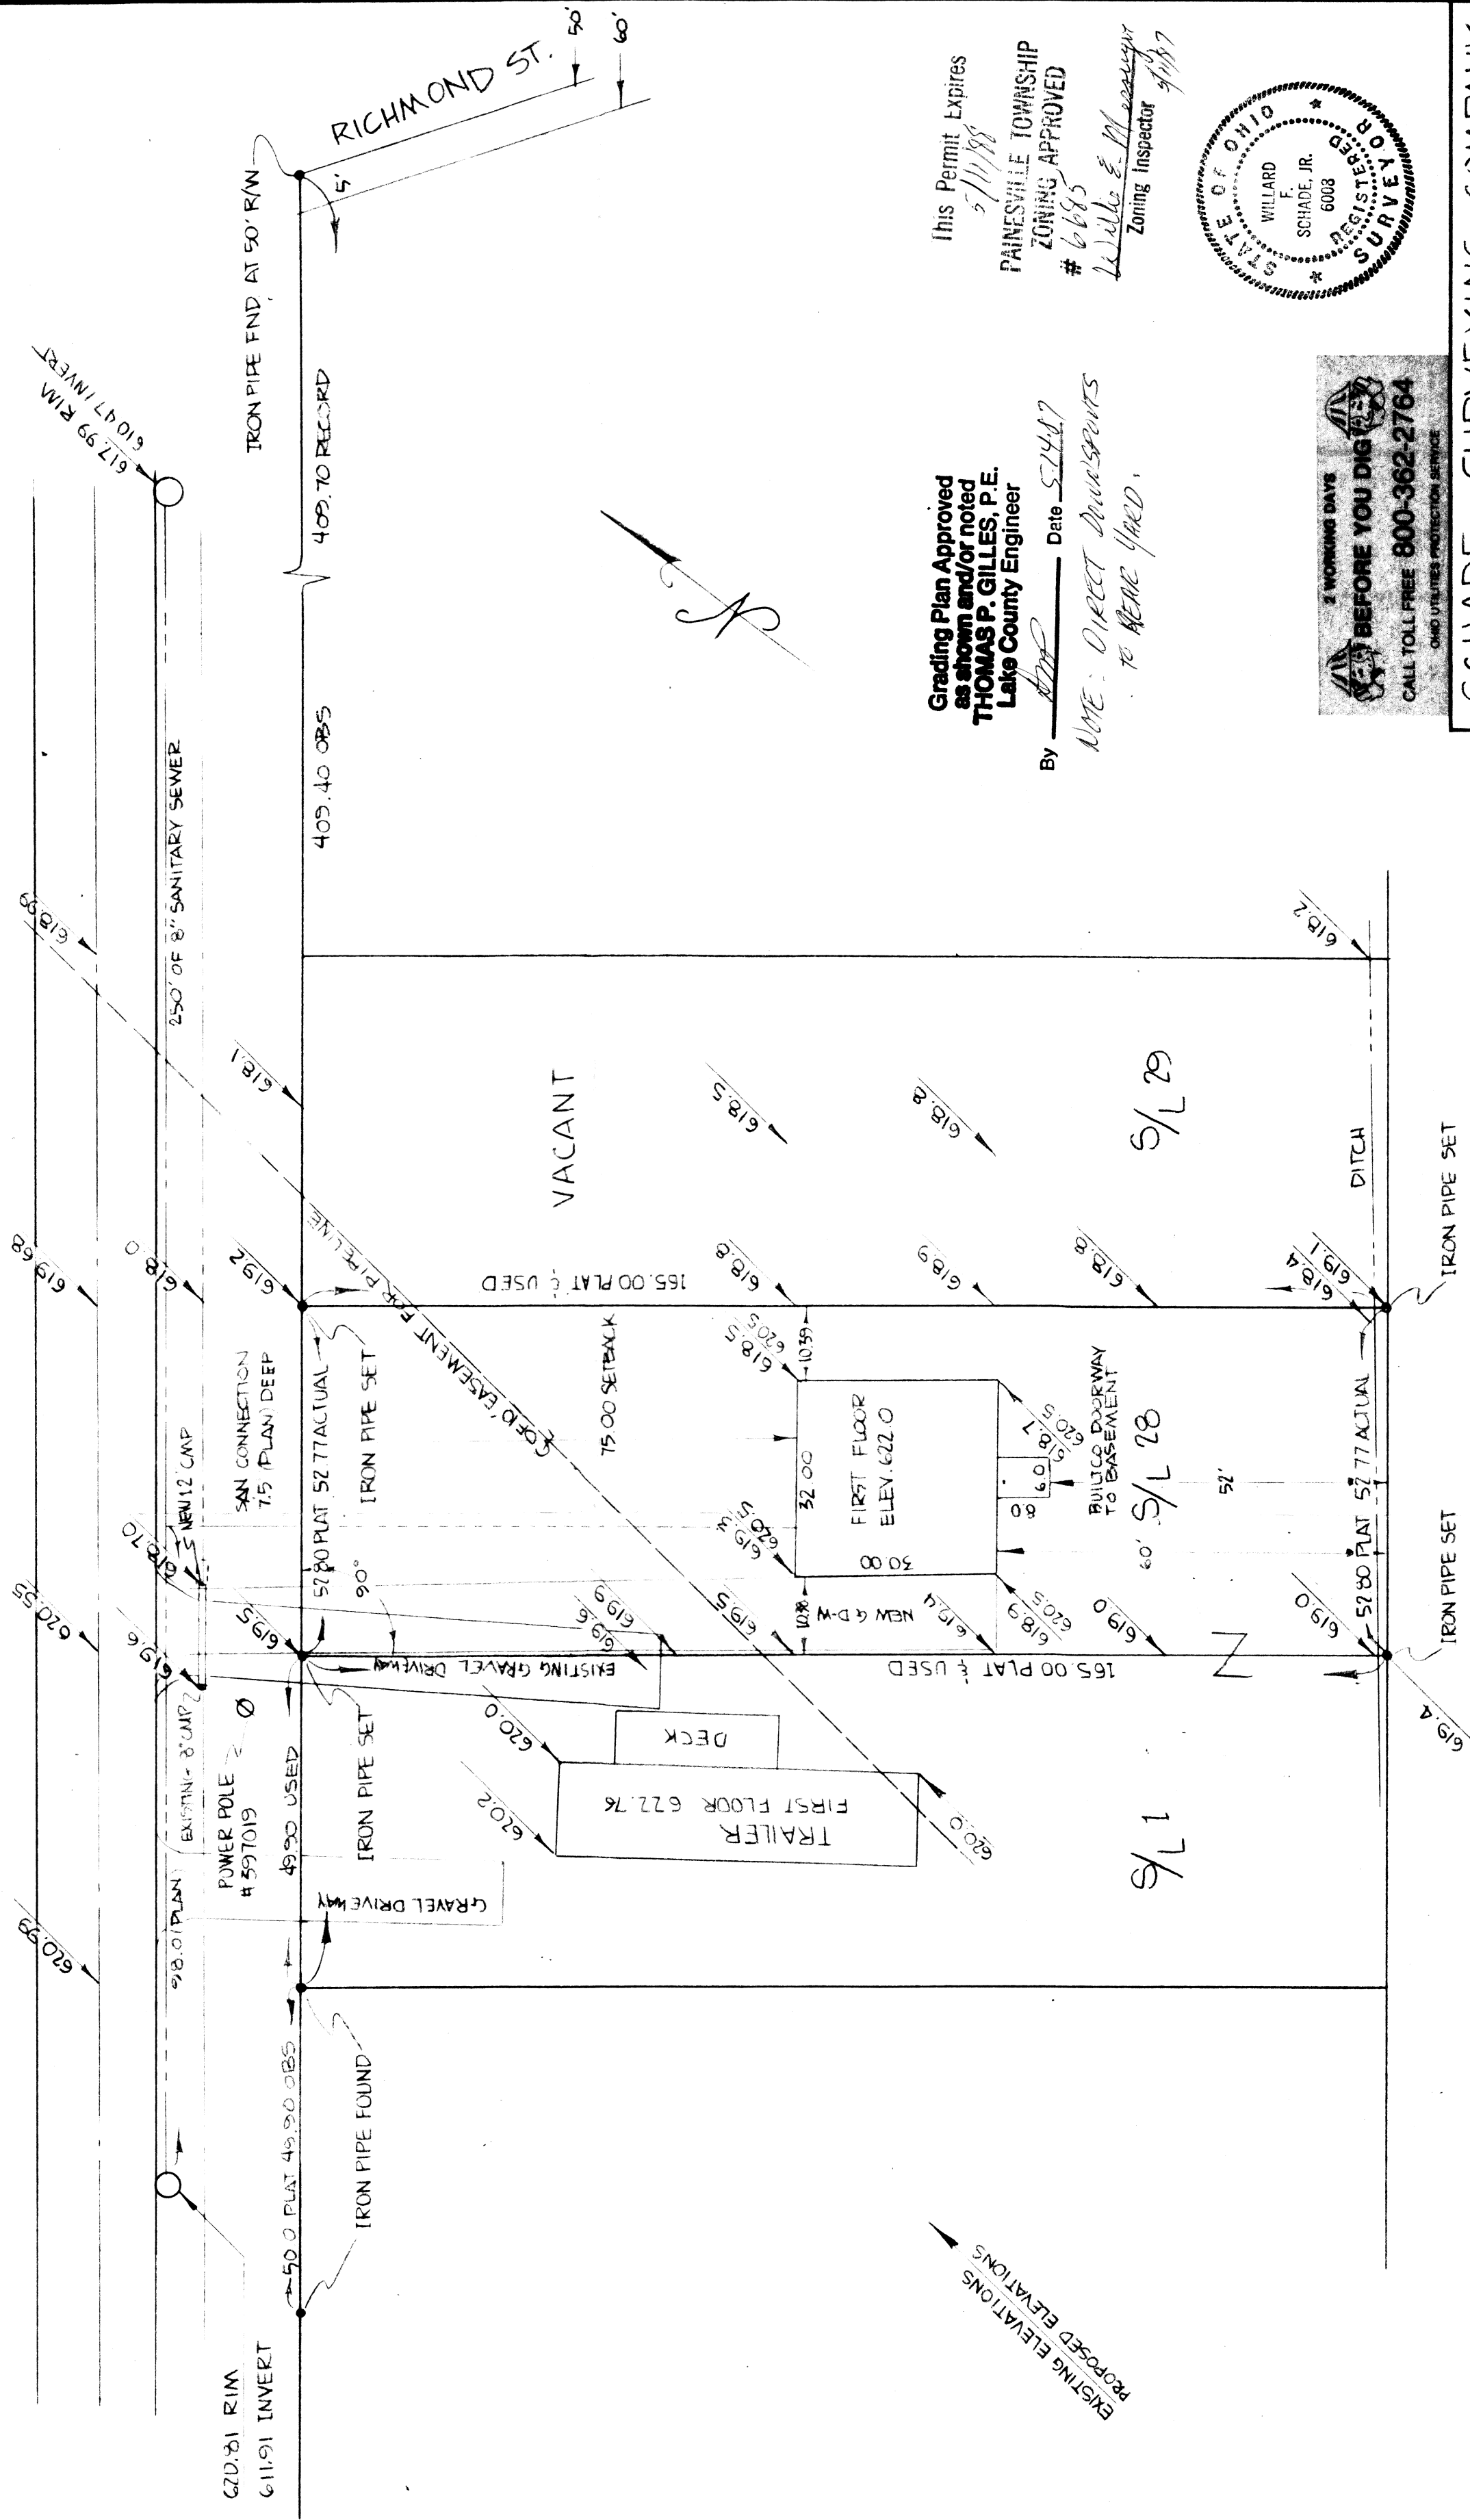

Grading Plan Approved
as shown and/or noted
THOMAS P. GILLES, P.E.
Lake County Engineer

This Permit Expires
5/11/88
PAINESVILLE TOWNSHIP
ZONING APPROVED
6685
W. J. & M. Messinger
Zoning Inspector 4/13/87

By *[Signature]* Date 5/14/87

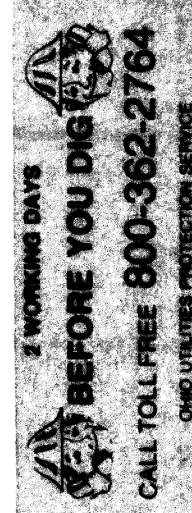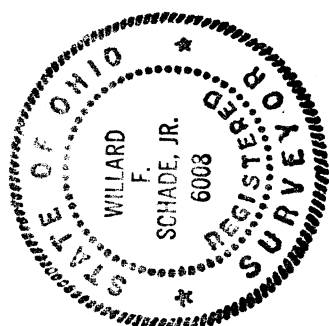

SCHADE SURVEYING COMPANY	
951-6454	
SCALE: 1" = 20'	APPROVED BY
DATE: 4-16-87	DRAWN BY JAT
SITE PLAN	
FOR D. NICHOLSON PAINESVILLE TWP	
ALLEN AVE	DRAWING NUMBER 87-538

ADDED BUILT-UP DRIVEWAY 5-5-87