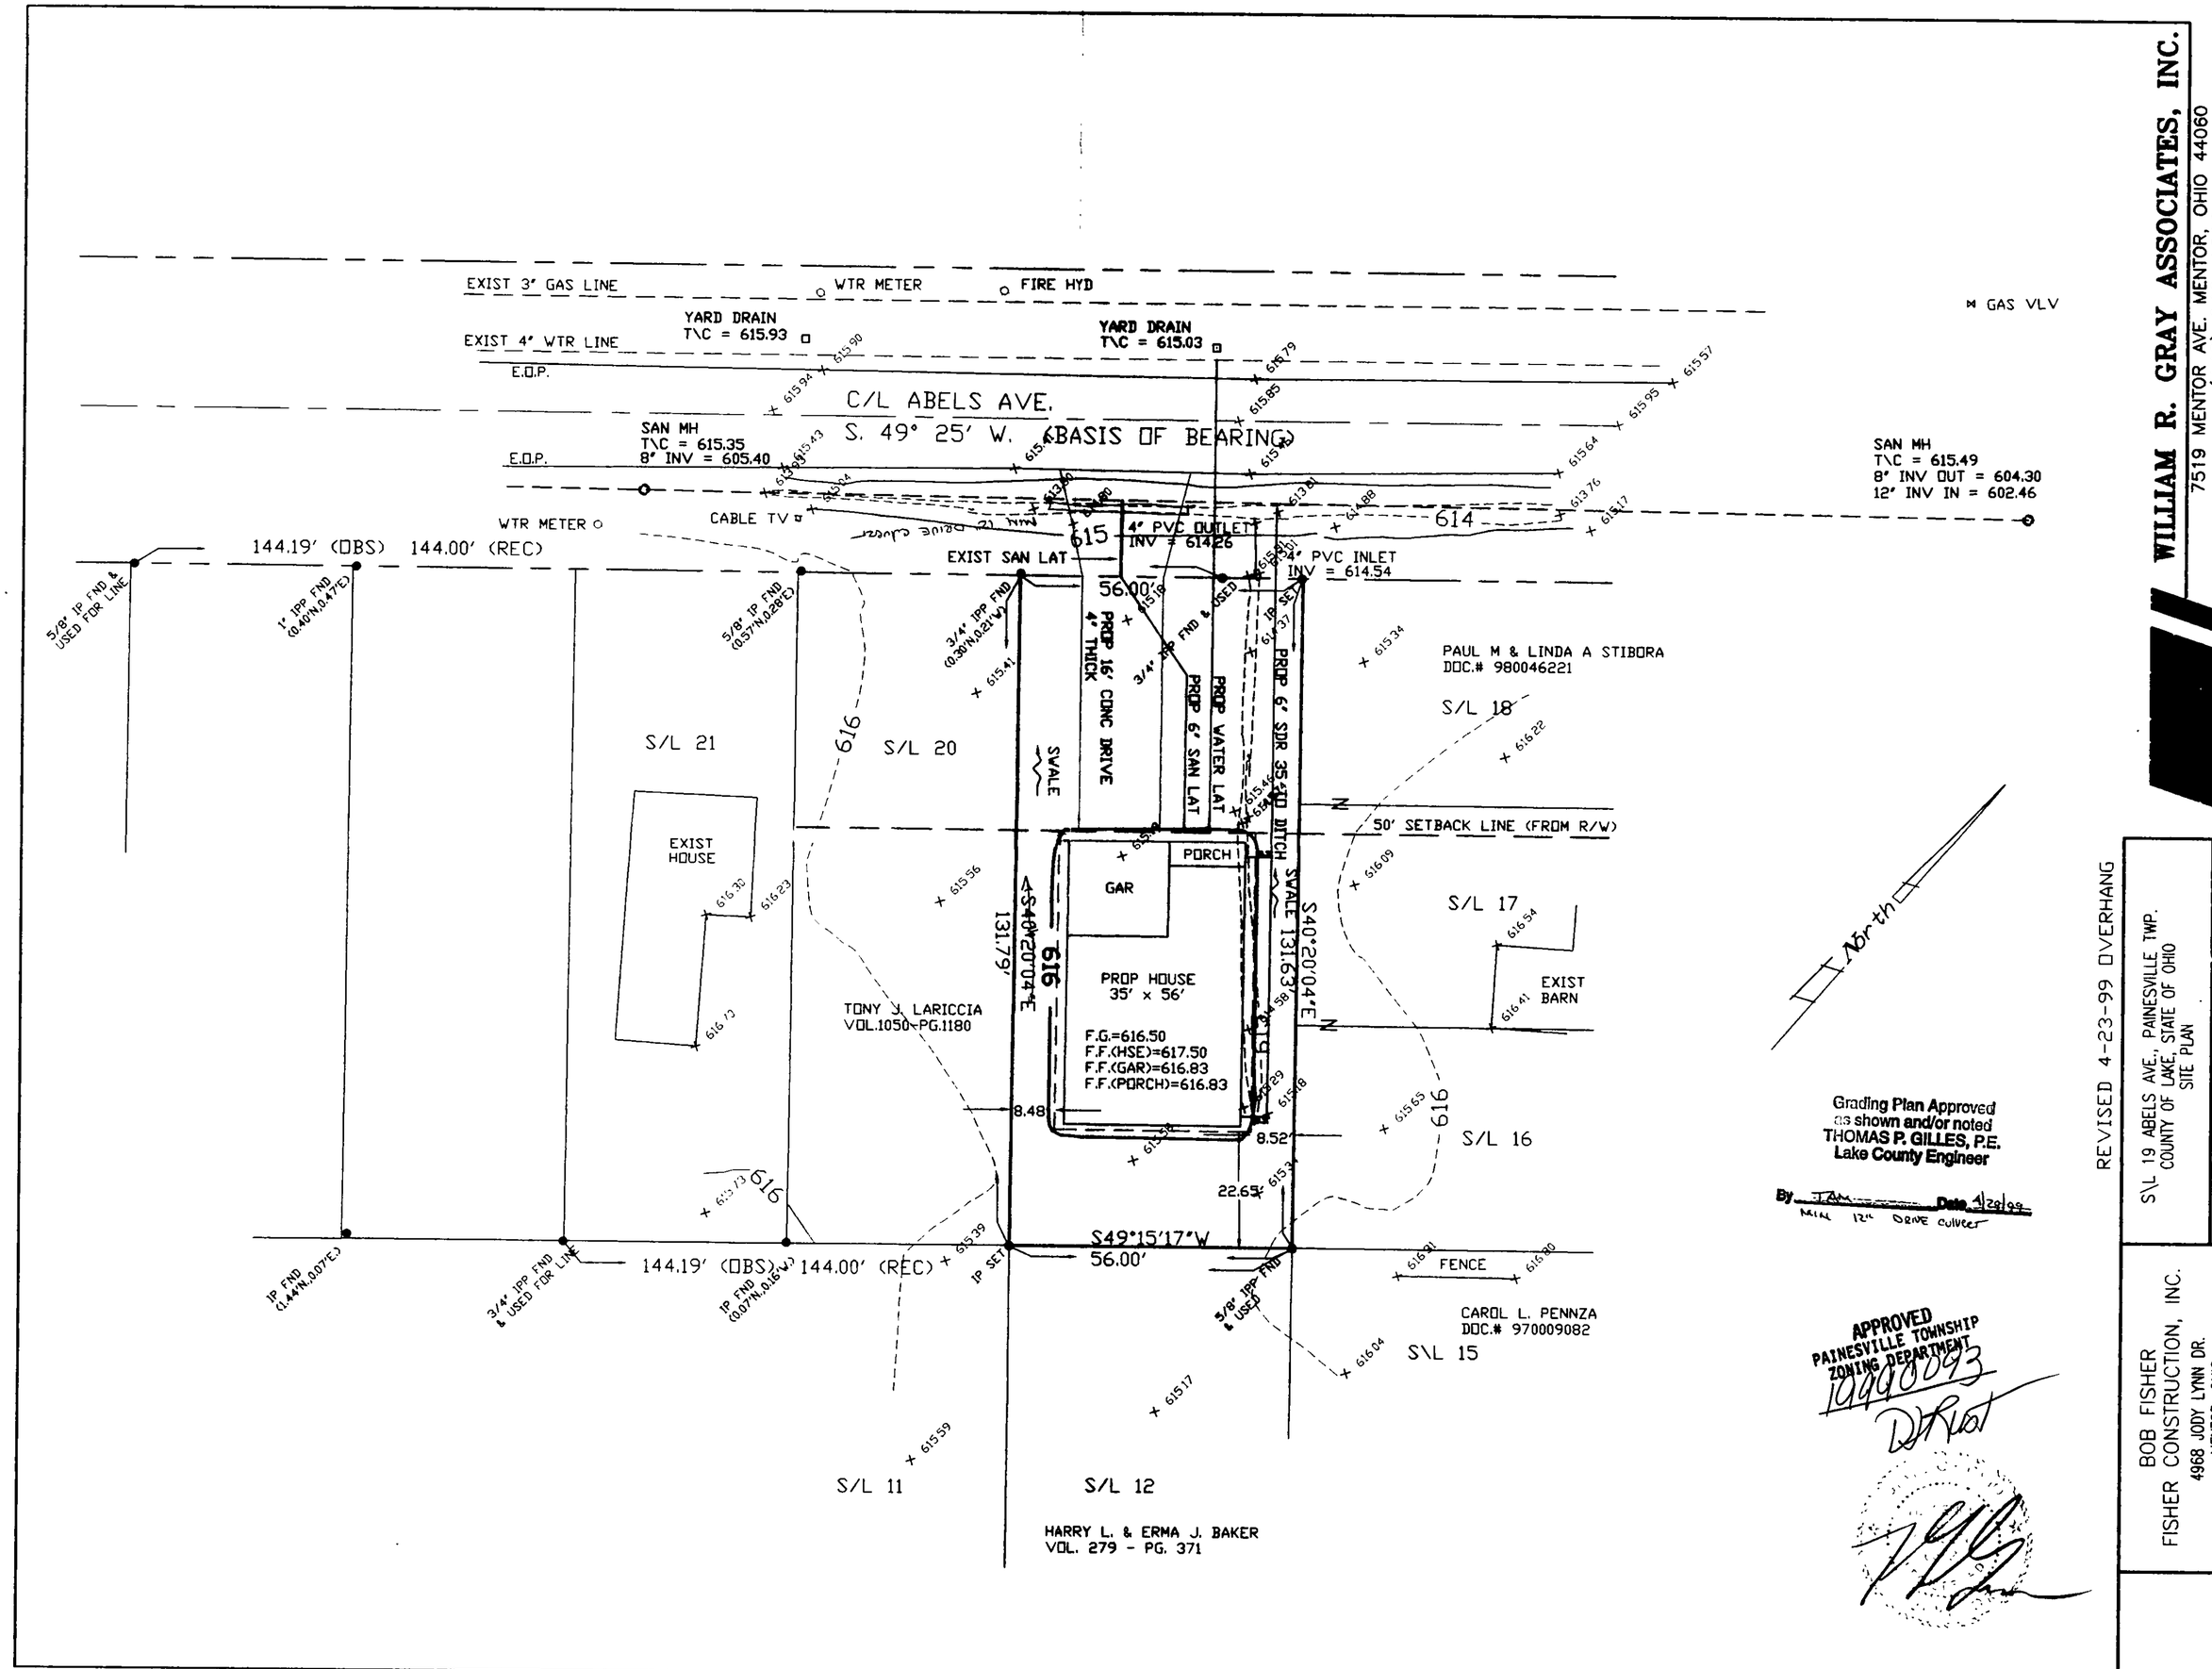

REVISED 4-23-99 OVERHANG

WILLIAM R. GRAY ASSOCIATES, INC.
7519 MENTOR AVE. MENTOR, OHIO 44060
(440) 946-1616

S\L 19 ABELS AVE., PAINESVILLE TWP.
COUNTY OF LAKE, STATE OF OHIO
SITE PLAN

4-16-99	PAF	TGG	1" = 20'

BOB FISHER
FISHER CONSTRUCTION, INC.
4968 JODY LYNN DR.
MENTOR, OHIO