


SITE PLAN FOR R.C. REED CONST. BEING S/L 123, HEATHERSTONE VILLAGE SUBD. #1, IN THE TOWNSHIP OF PAINESVILLE, LAKE COUNTY, OHIO.

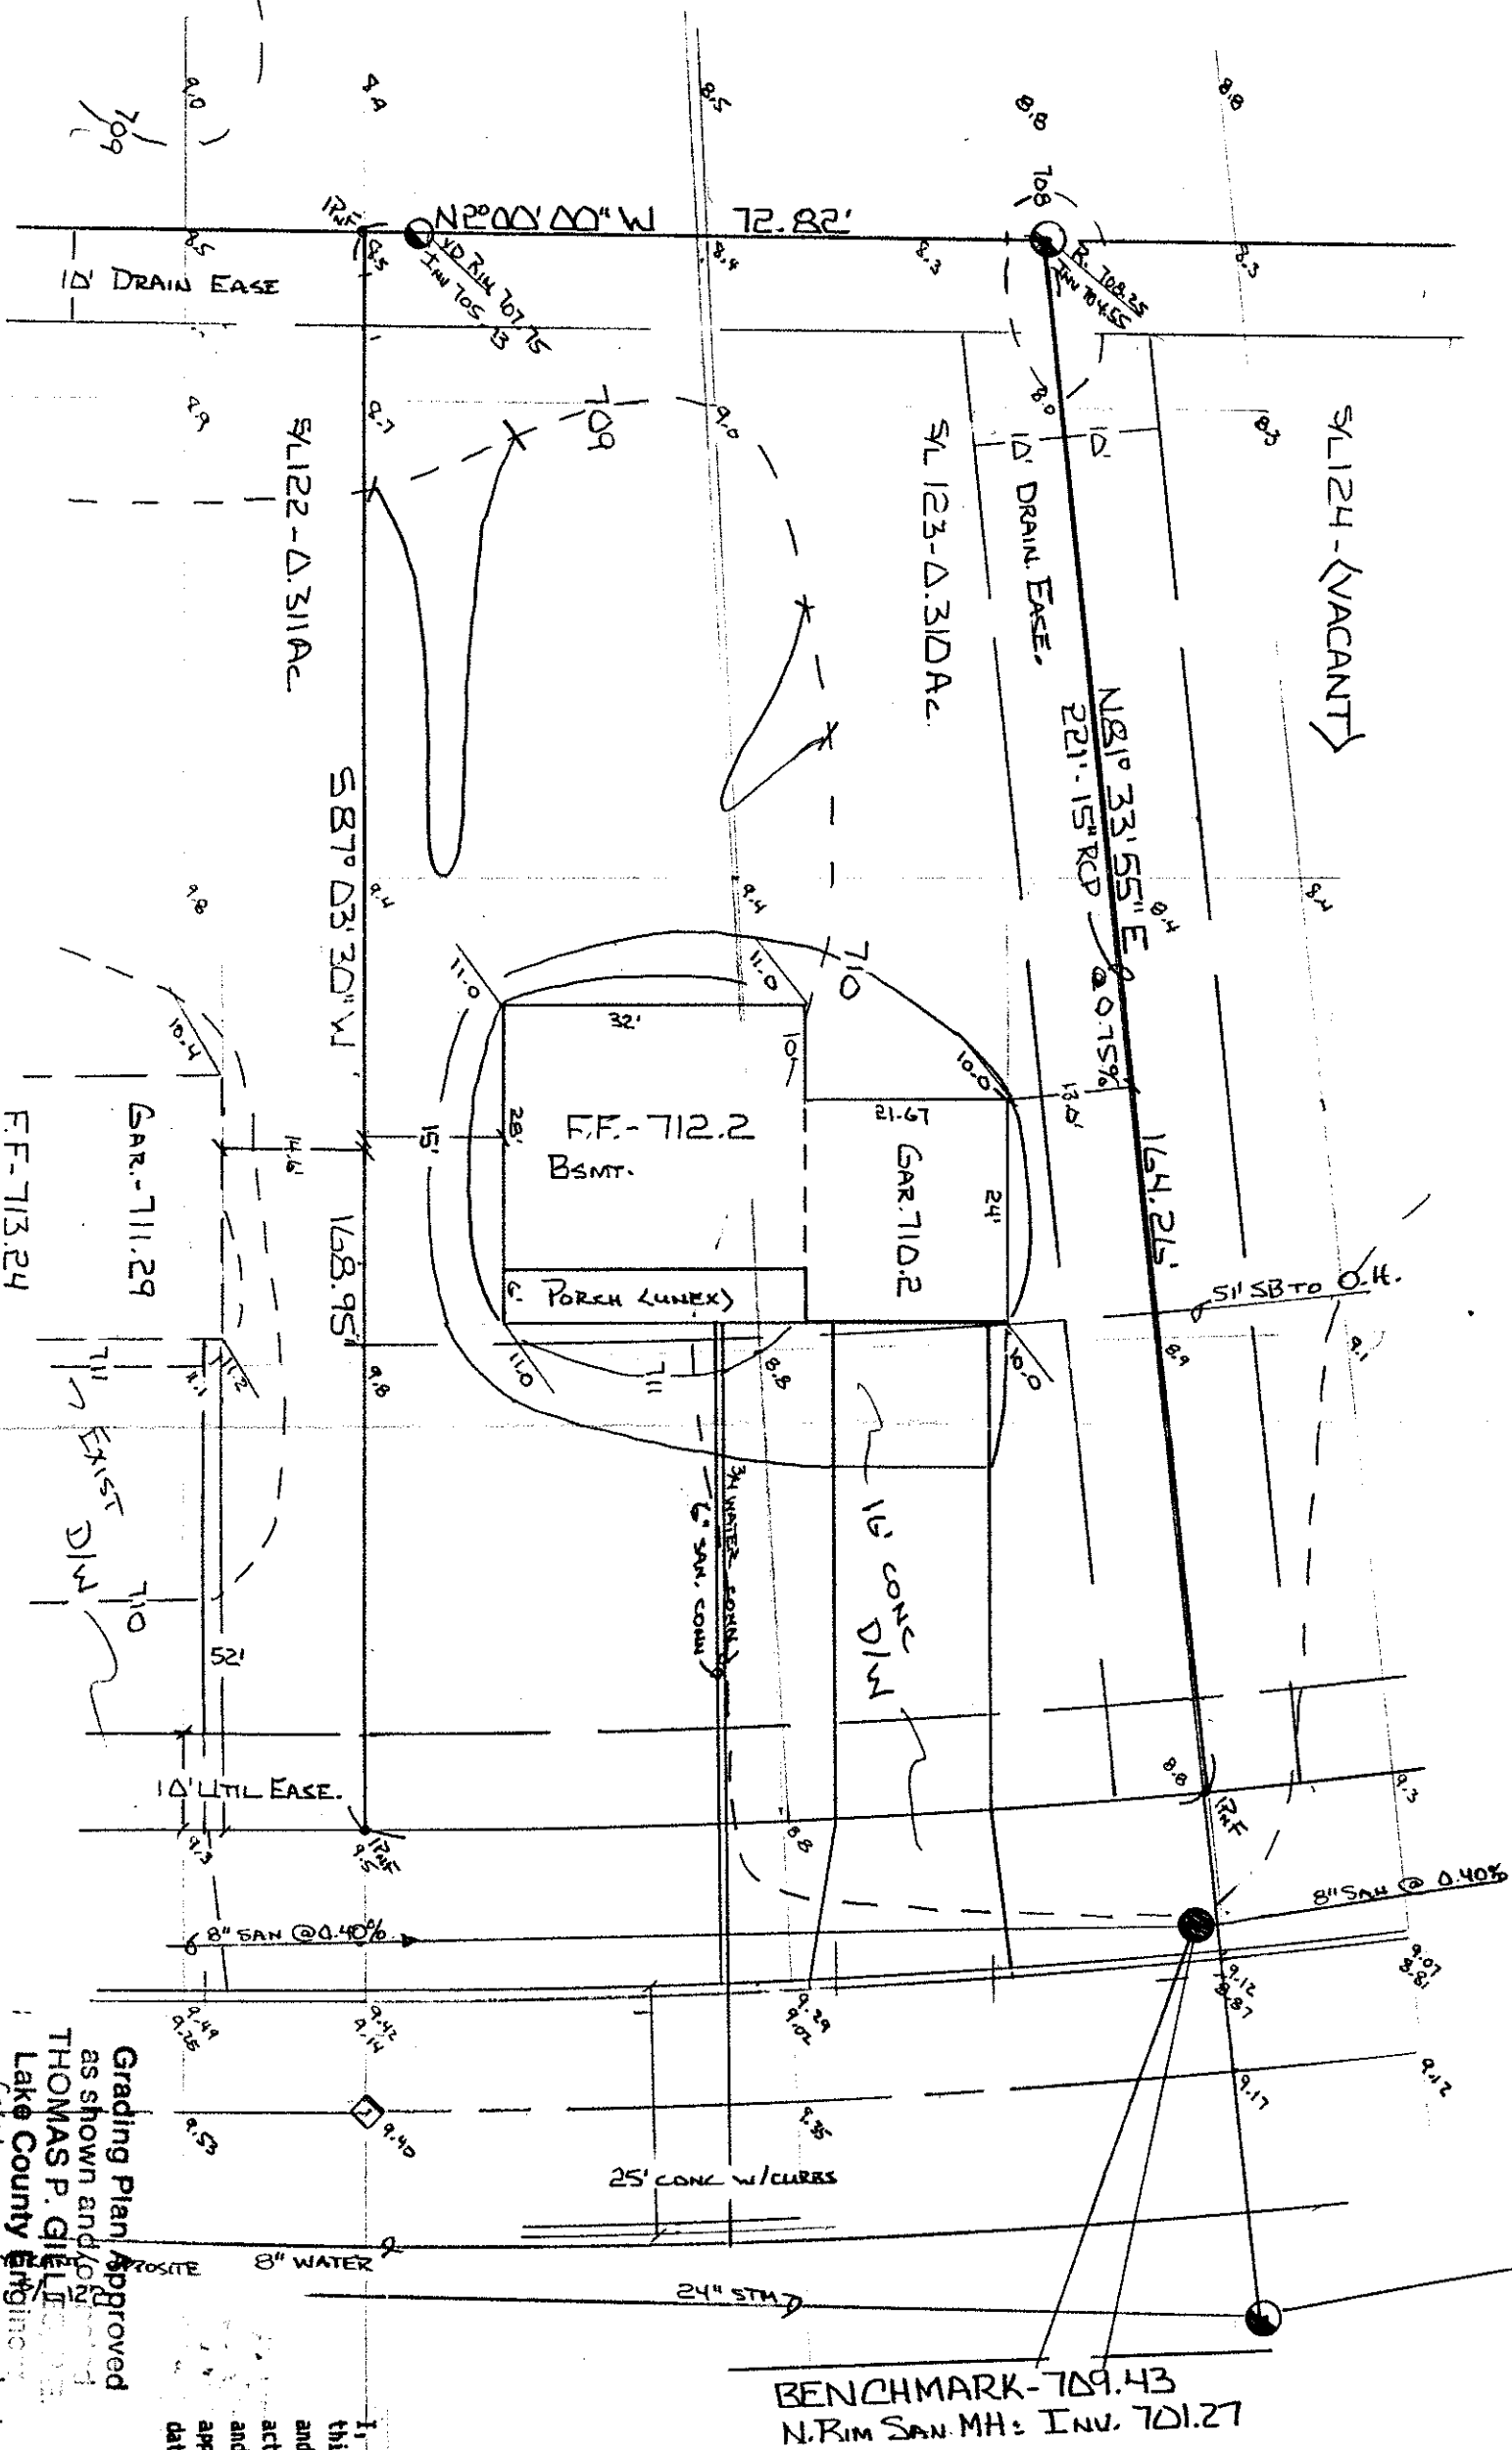

VILLAGE SURVEYING Co.
202 THIRB ST., FAIRPORT HBR., OH. 44077
216 (357-1359)

By THOMAS P. GILBERT
DISCHARGE Sump pump TO
STORM SEWER.

Grading Plan Approved
as shown and/or
THOMAS P. GILBERT
Lake County Engineer

I, the undersigned hereby certify that
this topography, indicated by 1' contours,
and elevations shown hereon represent an
actual field survey made by me on / APRIL 15, 1991
and that the elevations were taken at
appropriate intervals and that as of that
date they existed as indicated hereon.

CURVE DATA
RADIUS - 924.93'
ARC - 88.67'
CHORD - 88.64'
BEARING - S54°17'E

This Permit Expires
PAINESVILLE TOWNSHIP
ZONING APPROVED
#7833
THOMAS P. GILBERT

