


TOWNSHIP OF TRINITYVILLE, LAKE COUNTY, OHIO.

BEING SUBLOT NO. 121, HEATHERSTONE VILLAGE SUBD.,
TOWNSHIP OF TRINITYVILLE, LAKE COUNTY, OHIO.

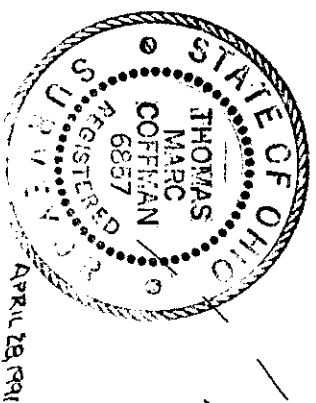

I, the undersigned hereby certify that this topography, indicated by 1' contours, and elevations shown hereon represent an actual field survey made by me on April 8, 1991 and that the elevations were taken at appropriate intervals and that as of that date they existed as indicated hereon.

7. M. Coffman, P.S.
No 6857

Grading Plan Approved
as shown and/or noted
THOMAS P. GILLES, P.E.

By GJH Date 5/3/01

DISCHARGE Sump Pump
TO STORM SEWER.

This Permit Expires 4/29/92
PAINESVILLE TOWNSHIP
ZONING APPROVED
7770
[Signature]
Zoning Inspector

BENCHMARX-711.21
N. Rim. SAN M. H. 8/12D: INV-7D2-4-