

SITE PLAN
FOR

R.C. REED CONSTRUCTION

BEING SUBLOT 114 OF THE HEATHERSTONE VILLAGE
SUBDIVISION NO. 1, PAINESVILLE TOWNSHIP, LAKE COUNTY, OHIO

Grading Plan Approved

as shown and/or noted

THOMAS P. GILLES, P.E.

Lake County Engineer

BY *THP* Date 5.21.87


VILLAGE SURVEYING CO.
202 THIRD STREET
FAIRPORT HARBOR, OH. 44077

THIS PLAN WAS PREPARED BY ME
AND IS ACCURATE TO THE BEST
OF MY KNOWLEDGE AND BELIEF




* SUBLOTS NOT OTHERWISE
NOTED HEATHERSTONE
DEVELOPMENT CO.

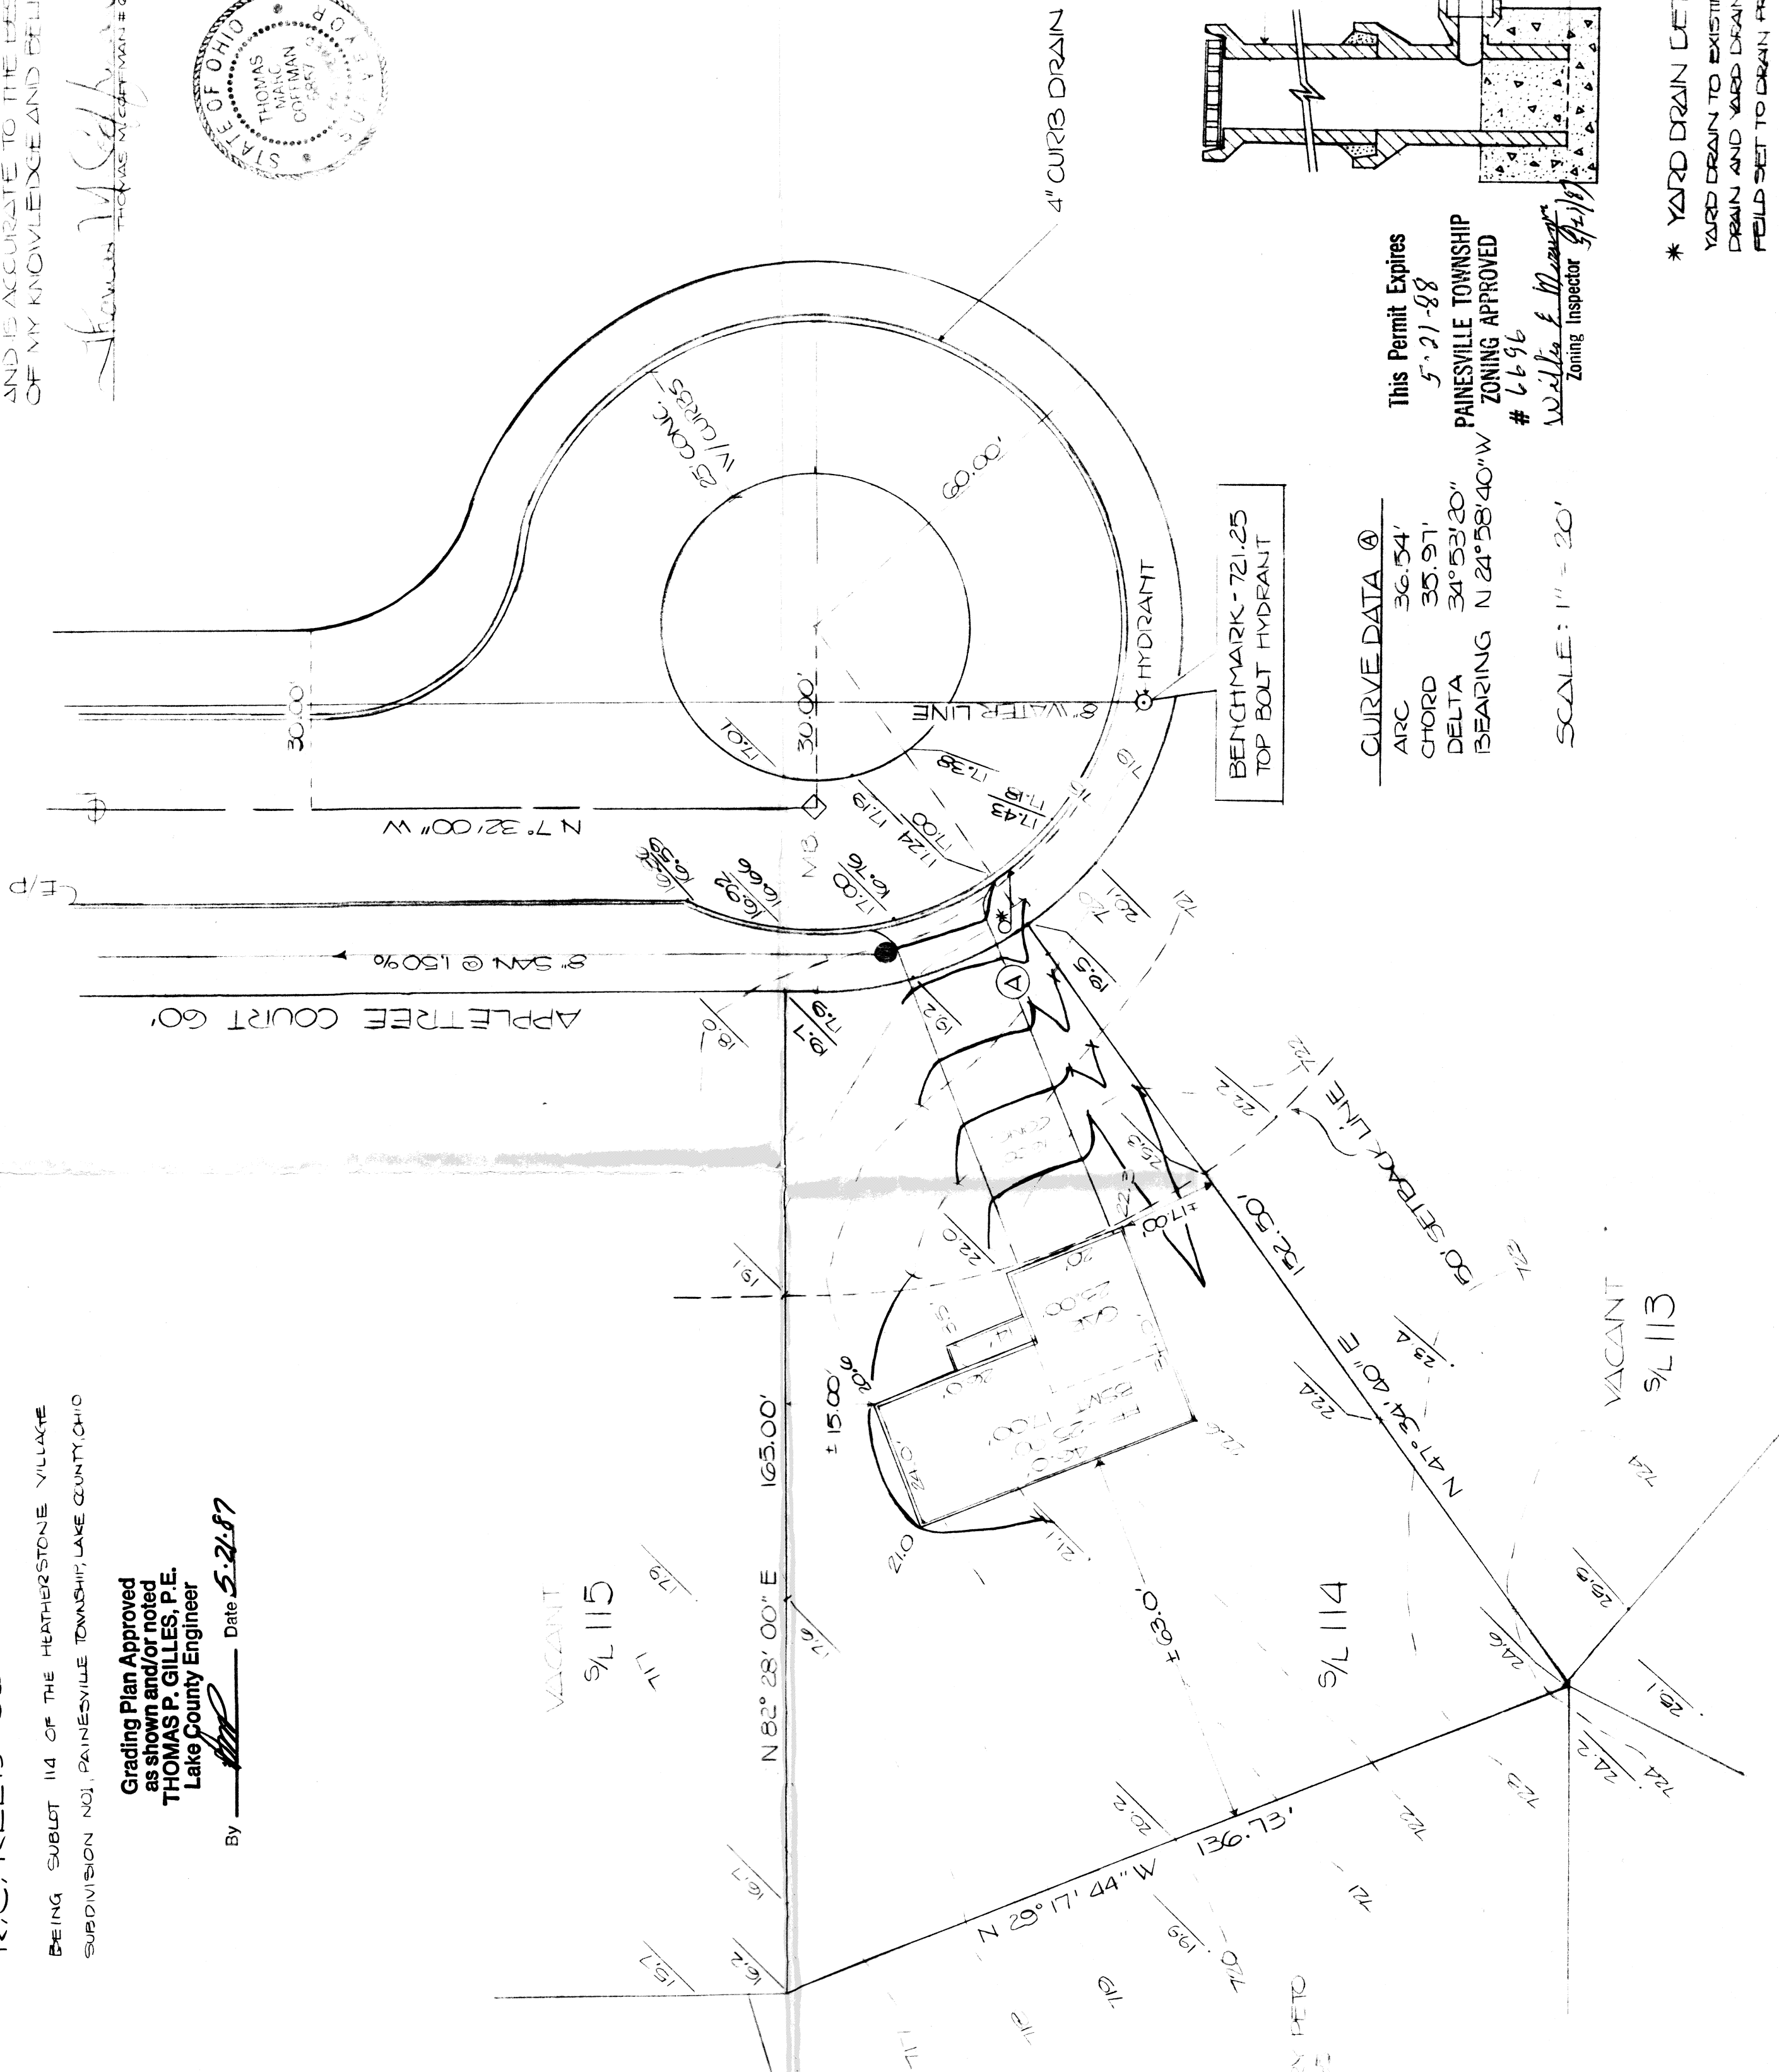

CURVE DATA @

ARC	36.54'
CHORD	35.91'
DELTA	34°53'20"
BEARING	N 24°58'40" W


This Permit Expires
5-21-88

PAINESVILLE TOWNSHIP
ZONING APPROVED
6696

William E. McLaughlin
Zoning Inspector 5/21/87

SCALE: 1" = 20'

BENCHMARK - 721.25
TOP BOLT HYDRANT

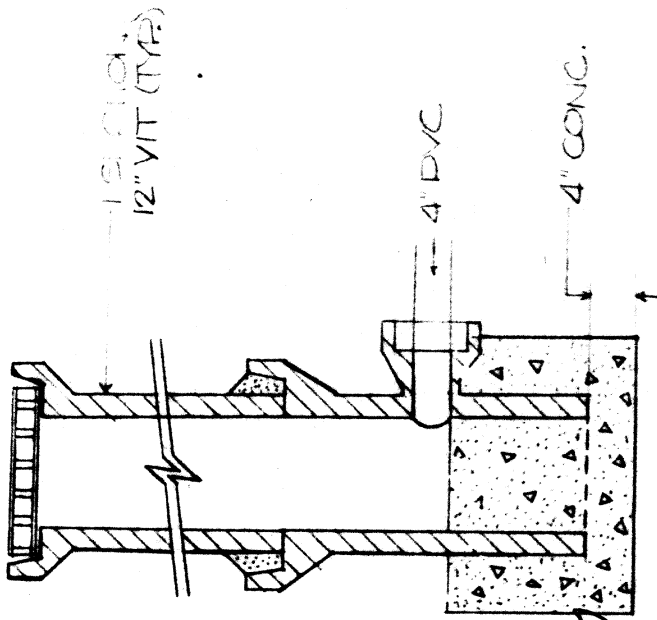

* YARD DRAIN DETAIL
YARD DRAIN TO EXISTING CURB
DRAIN AND YARD DRAIN TO THE
FIELD SET TO DRAIN PROPOSED
SWALE.