

BENCHMARK - 721.25
TOP BOLT HYDRANT

R.C. REED CONSTRUCTION

SUBDIVISION NO. PAINESVILLE TOWNSHIP LAKE COUNTY, OHIO

SITE PLAN
- FOR -


Grading Plan Approved
as shown and/or noted
THOMAS P. GILLES, P.E.
Lake County Engineer

By *THP* Date *2/1/87*

SCALE: 1" = 20'

N


CURVE DATA	
A = 40.00'	
C = 39.21'	
Δ = 38°12'00"	
N 60°31'20" W	

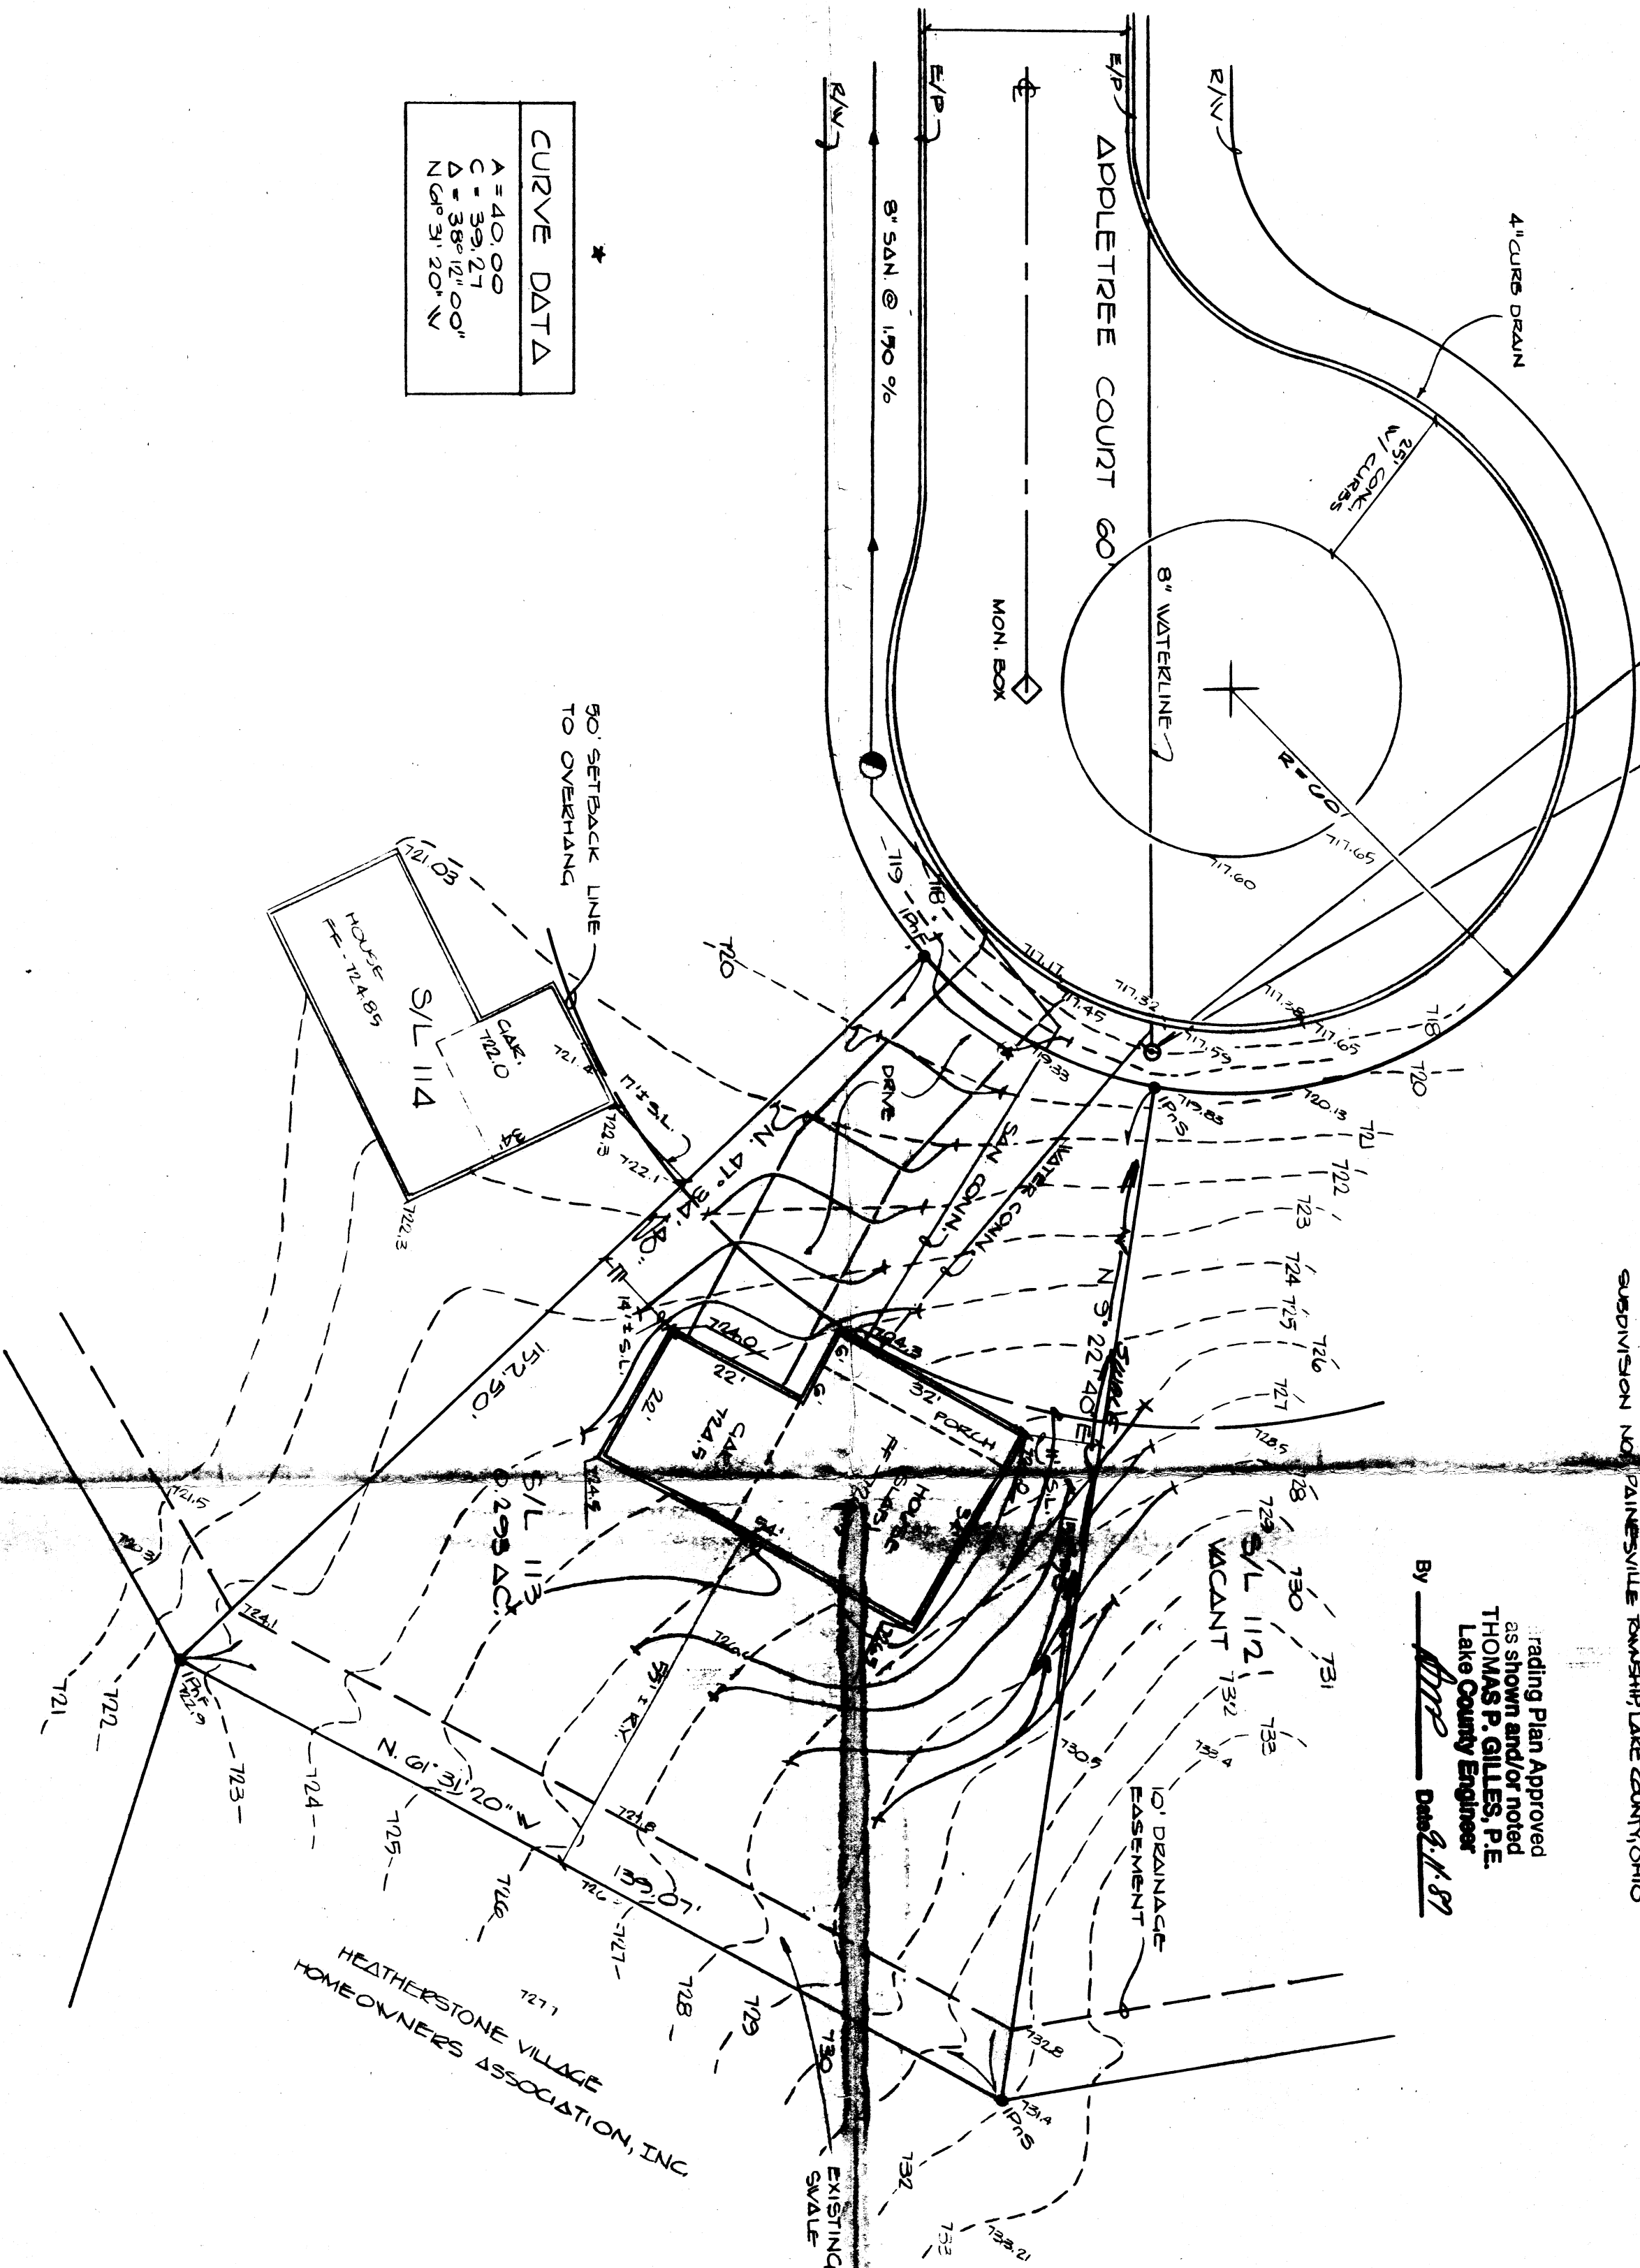

This Permit Expires
9-9-88
PAINESVILLE TOWNSHIP
ZONING APPROVED
6798
Walter E. M. [Signature]
Zoning Inspector 9/9/87

THIS PLAN WAS PREPARED BY ME AND IS
TRUE AND ACCURATE TO THE BEST OF
MY KNOWLEDGE AND BELIEF.

Thomas M. Coffman
THOMAS M. COFFMAN NO. 6857

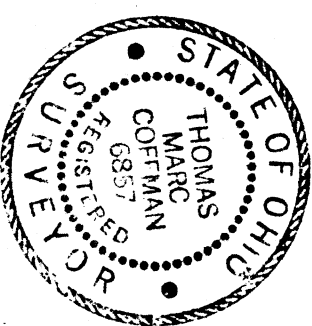

VILLAGE SURVEYING CO.

THOMAS M. COFFMAN, P.S.
202 THIRD STREET, FAIRPORT HARBOR, OHIO 44077
(216) 351-1555