


SITE PLAN

FOR
WAYNE HAWKINS

BEING KNOWN AS S/L 52 IN BRIARWOOD FARM SUB'D.
PAINESVILLE TOWNSHIP, LAKE COUNTY, OHIO.

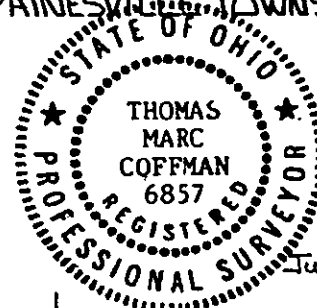

July 24, 1999

SCALE: 1"=20'

EXIST.
PROP.

EXIST.
PROP.

Grading Plan Approved
as shown and/or noted
THOMAS P. GILLES, P.E.
Lake County Engineer

By TAM Date 8/16/99
Lower F.G. to 680.5
Swale as shown

THEODORE & KATIE MCKOWN
V. 291-449

DALE GELLIARTH
V. 425-971

DAVID & KIMBERLY CLUCAS
990004327

VILLAGE SURVEYING CO.
P.O. BOX 1096, FAIRPORT HARBOR, OH 44077
(419) 357-1359

I, the undersigned hereby certify this
topography, indicated by 1' contours,
and elevations shown hereon represent
an actual field survey by me on July 22, 1999
and that the were taken at appropriate
intervals and that as of that date they
existed as indicated hereon.

J. M. Coffman P.S.

EXISTING HOUSE
F.F. - 681.98

DAVID & LISA HRVATIN
980022088

EXIST.
SHED
15'

N 60° 16' 05" E 183.24'

20' LOCAL SERVICE DRAINAGE EASEMENT

N 60° 16' 05" E 108.52'

N 60° 14' 16" E 106.46'

KEITH & PATRICIA CARROLL
980018232

BENCHMARK - 678.90 N. RIM SAN. MH
INV. - 669.44

APPROVED
PAINESVILLE TOWNSHIP
ZONING DEPARTMENT
199903069

ARBORDALE

LANE 60'

12" STORM SEWER

8" SANITARY SEWER @ 0.54%

UTILITY EASEMENT

50' SETBACK LINE

16' CONC D/W

6" SAN CONN
@ 1% M/W

75.00'
S 29° 43' 55" E

8" STM SEWER

R-678.79
I-673.62

679

678.74

679.1

679.1

677.54

677.54

677.78










































678.26

678.26

