This Permit Expires
MAY 1 1980
PAINESVILLE TOWNSHIP
ZONING APPROVED
#4759
R. M. Hall
Zoning Inspector
5/2/79

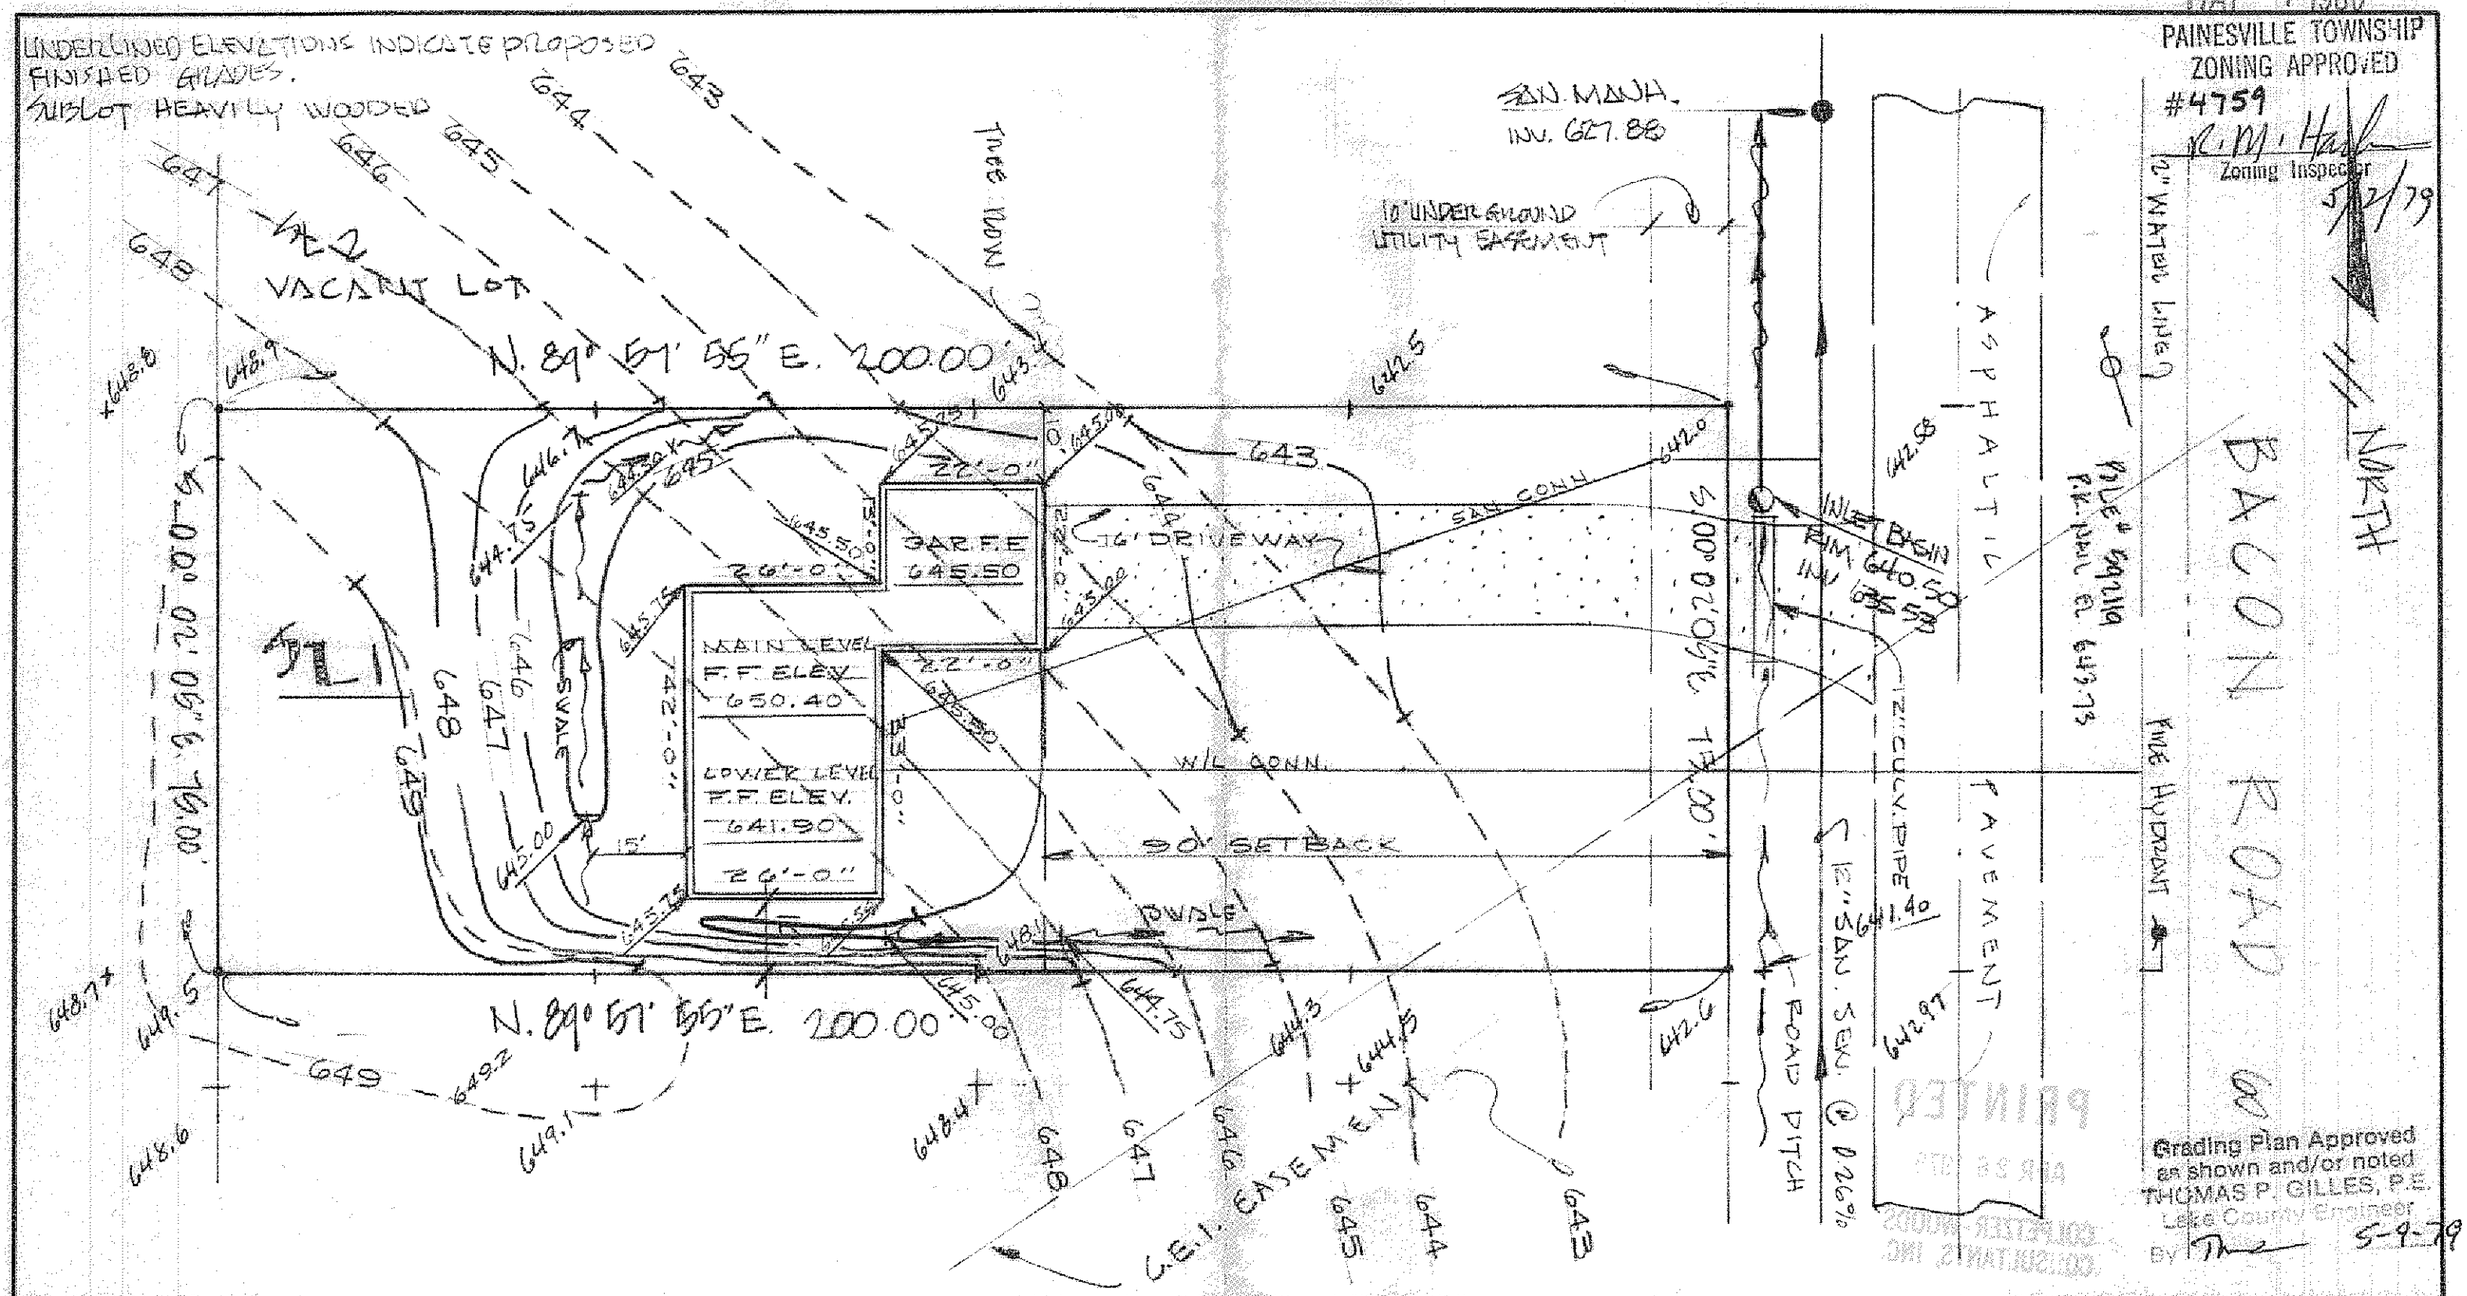

Grading Plan Approved as shown and/or noted
THOMAS P. GILLES, P.E.
Lake County Engineer
BY 5-9-79

DESIGN CERTIFICATION	AS BUILT CERTIFICATION			
THIS PLAT WAS PREPARED BY ME, AND IS CORRECT TO THE BEST OF MY KNOWLEDGE AND BELIEF.	I HEREBY CERTIFY THAT THE CIRCLED GRADES ARE EXISTING FINISH GRADES CHECKED IN THE FIELD ON _____ AND THAT SURVEY IS CORRECT TO THE BEST OF MY KNOWLEDGE AND BELIEF.	COLPETZER · WOODS CONSULTANTS, INC. ~~186 SOUTH STATE STREET • PAINESVILLE, OHIO 44077~~ • (216) 357-7569 4470 Mentor Avenue, Mentor, Ohio	DATE 10/4/78 SCALE 1" = 20' DRWN BY CB CHKD BY E JOB NO 7815 FB 332 PG 1	SITE PLAN FOR: EDWARD H. TRESGER, INC. 8100 DEERWOOD BLVD., MENTOR, OHIO. SUBLOT No. 1 IN THE PINES SUBDIVISION No. 1 PAINESVILLE TWP., OHIO.
REG. SURVEYOR NO. 4785	REG. SURVEYOR NO. _____			