


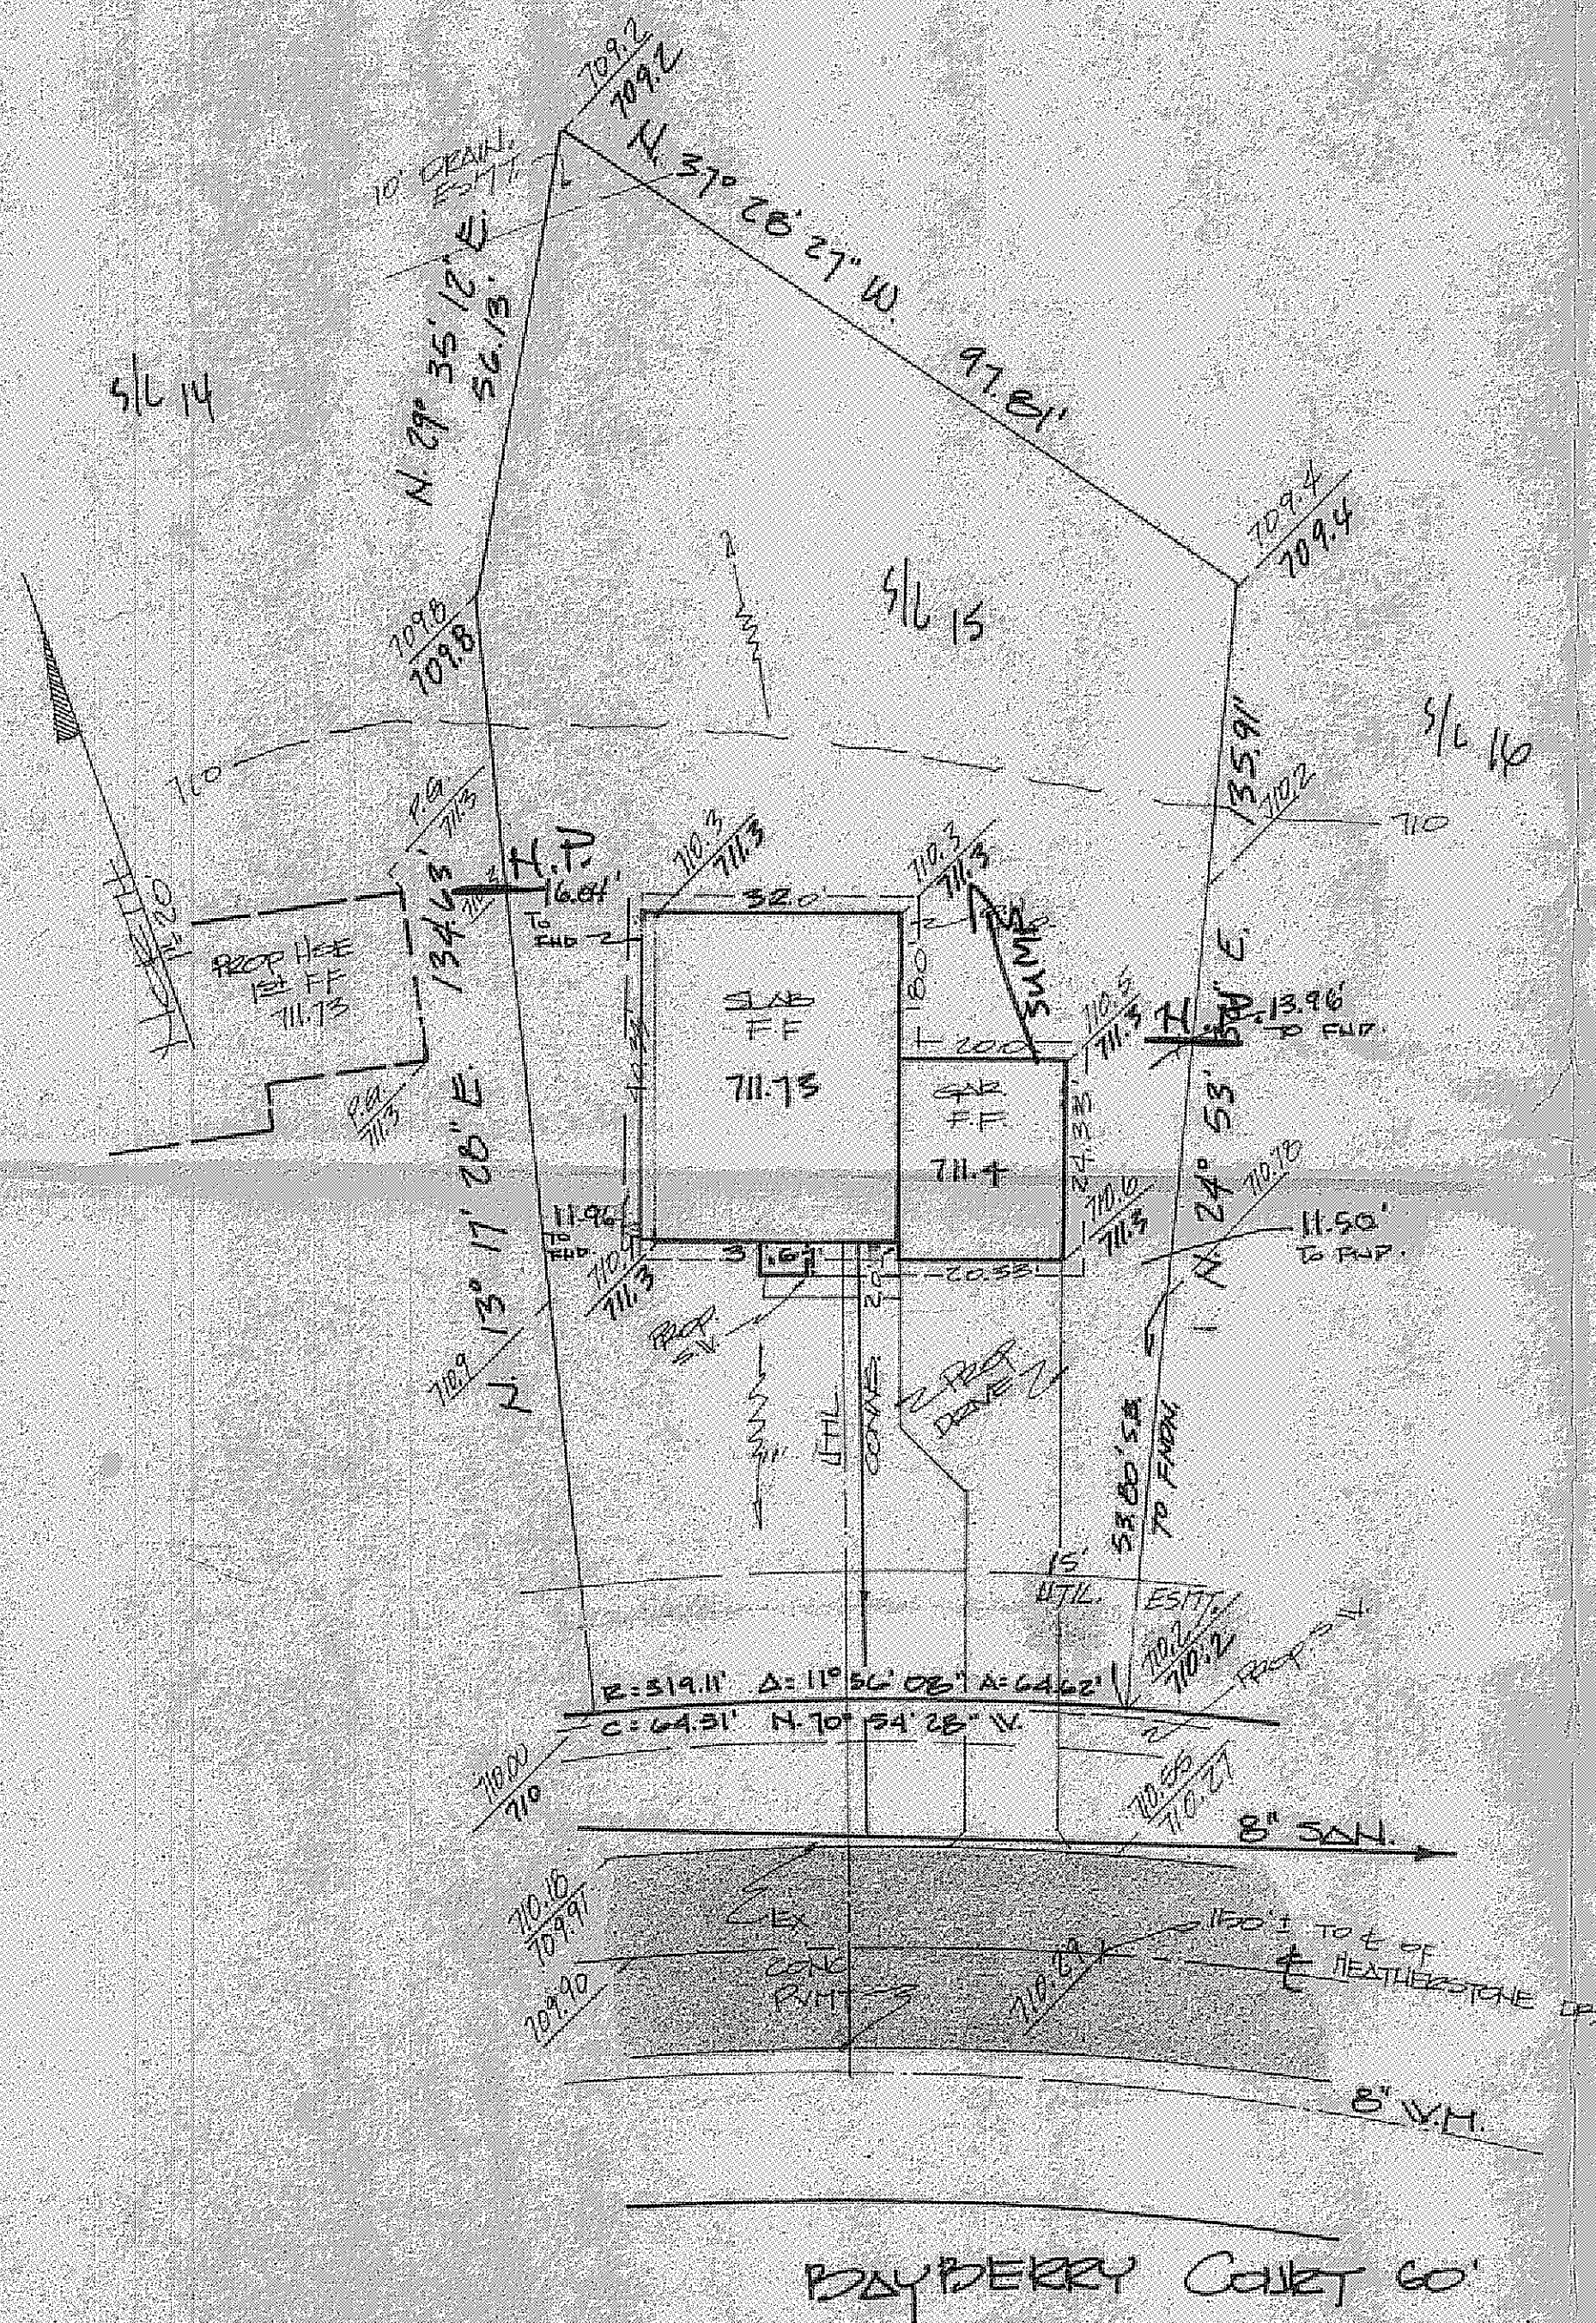

SITE PLAN

PAINESVILLE TOWNSHIP **LAKE COUNTY, OHIO**
for: MEADOW VOOD HOMES
 CLIENT OWNER
2800 CHAGIN VOODHOMES
 ADDRESS STREET CITY ZIP

HEATHERSTONE
 SUBDIVISION NAME
 VOL. - PG. **2800-1**
 SUBLOT NO. STREET LOT TRACT
 VOLUME PAGE
 PERM. PARCEL NO. STREET

LEGEND

SANITARY MANHOLE ---●--- WATER VALVE (GAS) ---●---
 STORM MANHOLE ---●--- WATER METER (GAS) ---●---
 INLET OR CATCH BASIN ---●--- AS BUILT ELEVATION ---●---
 HYDRANT ---●---
 EXISTING CONTOURS ---●--- INDICATES
 PROPOSED CONTOURS ---●--- DIRECTION OF
 EXIST. ELEV. ---100.0--- PROP. ELEV. ---100.0--- SURFACE DRAINAGE

REMARKS

ALL BOUNDARY DATA SHOWN WAS OBTAINED FROM IDEEOS, RECORDED
 SUBDIVISION PLAT OR OTHER PUBLIC RECORDS
 LOCATIONS AS SHOWN OF ADJACENT WELLS AND SEPTIC TANKS OBTAINED FROM
 LAKE COUNTY HEALTH DEPARTMENT

DESIGN CERTIFICATION

THIS PLAT WAS PREPARED BY ME, AND IS CORRECT
 TO THE BEST OF MY KNOWLEDGE AND BELIEF.

NAME SURVEYOR REGISTRATION NO.

CHECK LIST

NO. OF BEDROOMS
 DIMENSIONS
 BEARINGS
 TIE TO NEAREST STREET
 SUBLOT NO. PARCEL NO.
 SURROUNDING OWNERS
 BLDG. DIMENSIONS FIN. GR.
 BLDG. TIES FLR. GRADES
 APRON TYPE WIDTH THICKNESS
 SIDEWALK TYPE WIDTH THICKNESS
 CULVERT TYPE DIA. LENGTH
 ROCK OUTCROPPINGS
 WATER MAIN SIZE, LOCATION
 SAN. SEWER SIZE & GR. LOC.
 SAN. MH. CAST. ELEV. INV. ELEV.
 SAN. CONN. SIZE, LOC. DEPTH
 STORM SEWER SIZE & GR. LOC.
 STORM MH. CAST. ELEV. INV. ELEV.
 PAV'T TYPE GRADES
 GAS LINE LOC. SIZE PRESSURE
 SEPTIC TANK LOCATION & DUPLICATION AREA
 WELL LOCATION
 ISOLATION RADIUS FROM WELL

REVISIONS			PLAN PREPARED BY:		
NO.	DATE	BY	BABCOCK • JONES & ASSOCIATES, INC.		
1	6-12-80	W.B.	270 MAIN ST.	SUITE #20	PAINESVILLE, OHIO
2					
3			DRAWN BY	SCALE 1" = 20'	PHONE NO. 357-1811
4			CHK'D.	DATE 3-15-80	DRAWING NO. 80-004
5			CREW CHIEF B.B.	APP'D.	1/15

"AS BUILT" CERTIFICATION

I, HEREBY CERTIFY THAT THE CIRCLED GRADES ARE EXISTING
 FINISH GRADES CHECKED IN THE FIELD ON 19
 AND ARE CORRECT TO THE BEST OF MY KNOWLEDGE AND BELIEF.

REGISTERED SURVEYOR

REG. NO.

Grading Plan Approved
 as shown and/or noted
 THOMAS P. GILLES, P.E.
 Lake County Engineer

By

Date

This Permit Expires
 JUL 16 1981

PAINESVILLE TOWNSHIP
 ZONING APPROVED

5126
 R.M. Hark
 Zoning Inspector

7/15/80