

SITE PLAN



PAINESVILLE TOWNSHIP
LAKE COUNTY, OHIO
FOR
M.M. BOGART DEVELOPMENT CORP.

I HEREBY CERTIFY THAT THIS PLAN IS AN
ACCURATE AND TRUE REPRESENTATION OF SAID
PROPERTY.

David K. Mostoller R.S. #6949

I HEREBY CERTIFY THAT THE CIRCLED GRADES
ARE EXISTING FINISH GRADES CHECKED IN THE
FIELD ON 19 AND ARE
CORRECT TO THE BEST OF MY KNOWLEDGE AND
BELIEF.

David K. Mostoller R.S. #6949

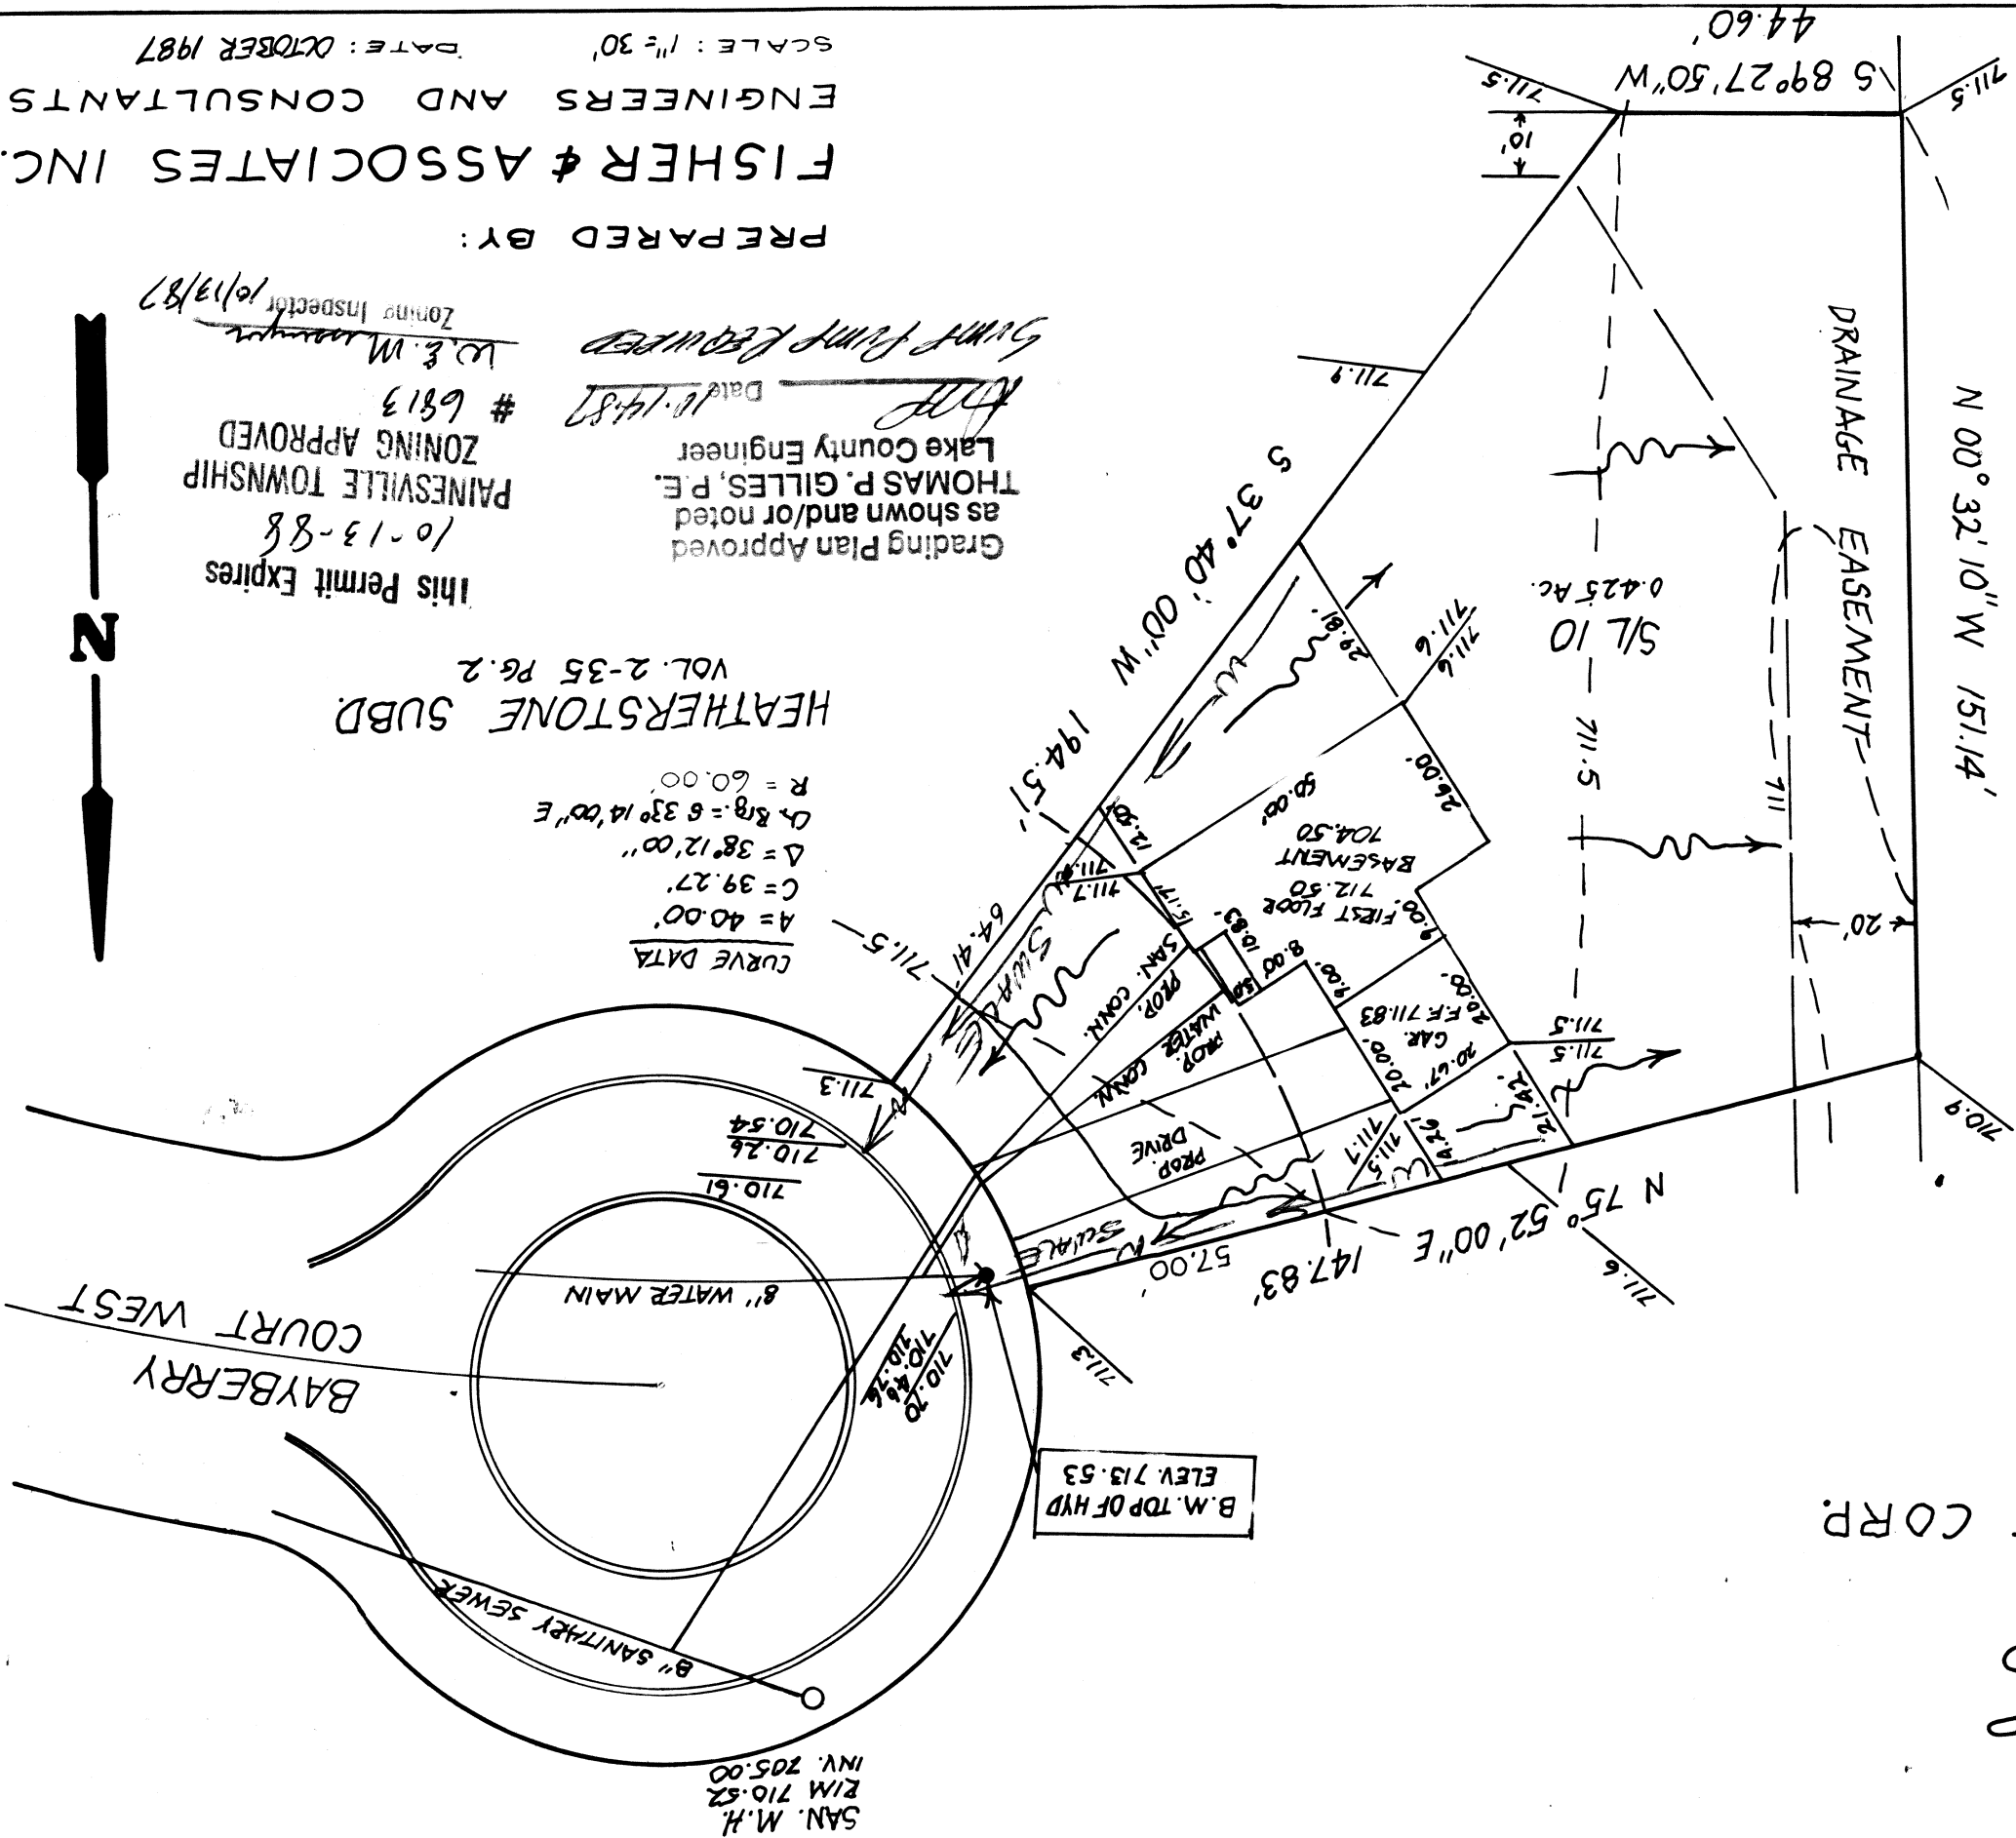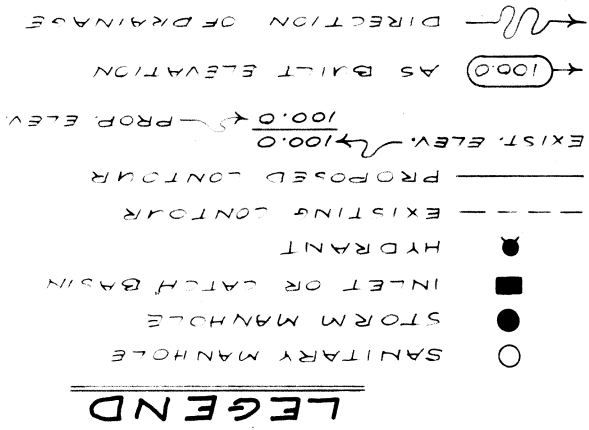

FISHER & ASSOCIATES INC.
ENGINEERS AND CONSULTANTS
SCALE: 1"=30'
DATE: OCTOBER 1987

PREPARED BY:

Grading Plan Approved
as shown and/or noted
THOMAS P. GILLES, P.E.
Lake County Engineer
Date: 10/14/87
Zoning Inspector 10/13/87
#6813
PAINESVILLE TOWNSHIP
ZONING APPROVED
10-13-88
this Permit Expires

HEATHERSTONE SUBD.
VOL. 2-35 PG. 2

CURVE DATA
A = 40.00'
C = 39.27'
Δ = 38°12'00"
Ch. 8g. = 633°14'00" E
R = 60.00'

B.M. TOP OF HYD.
ELEV. 713.53

SAN. M.H.
E/M 710.52
INV. 705.00