

HEATHERSTONE VILLAGE
HOMEOWNERS ASSOC., INC.

* All SUBLOTS IN THE NAME OF THE
HEATHERSTONE DEVELOPMENT CO.

CURVE DATA		
(A)	30.00'	RADIUS
	27.59'	ARC
	26.62'	CHORD
(B)	60.00'	RADIUS
	58.11'	CHORD
	58.11'	BEARING



BEING SUBLOT No. 157 OF THE HEATHERSTONE VILLAGE
SUBD. No. 1, PAINESVILLE TWP., LAKE COUNTY, OHIO

APPROVED BY: *TM*

DATE: OCT. 1986

SCALE: 1" = 20'

THIS PLAT WAS PREPARED BY ME
AND IS ACCURATE TO THE BEST
OF MY KNOWLEDGE AND BELIEF.

REG. SURVEYOR
#6857

SITE PLAN
FOR
R.C. REED CONST.

#422 BAYBERRY CT.

Zoning Inspector 11/7/86


#6551
R.M. Hark

PAINESVILLE TOWNSHIP
ZONING APPROVED

NOV 07 1987

This Permit Expires

Grading Plan Approved
as shown and/or noted
THOMAS P. GILLES, P.E.
Lake County Engineer

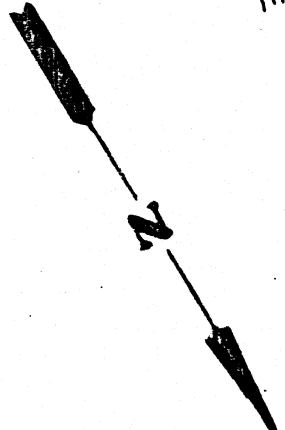

BAYBERRY COURT EAST 60'
8" SAN @ 2.00%

BENCHMARK - 712.45
N RIM SAN. MH #4150

GAR - 717.25
R-STY SLAB
FF - 718.0
46'
26'
24'

SAN CONDU.
WATER CONDU.

S/L 158 (VACANT)

S/L 157

S/L 156 (VACANT)

HYD - S/L 155