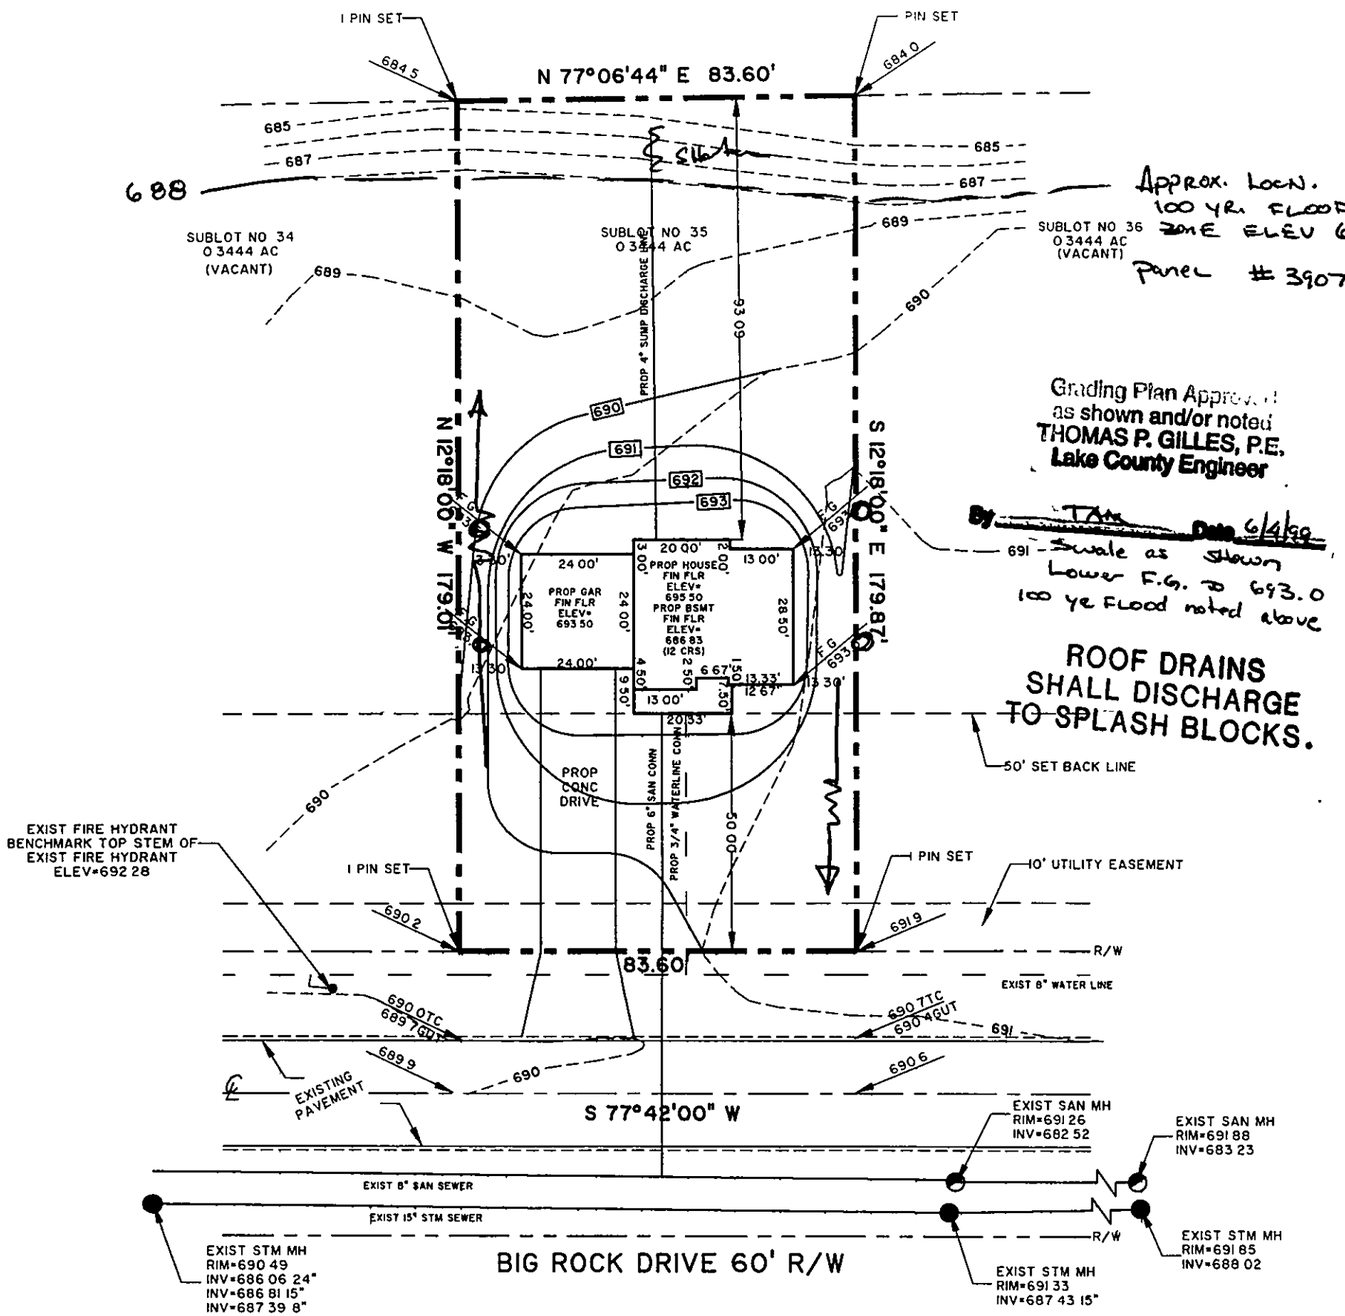

Grading Plan Approved
as shown and/or noted
THOMAS P. GILLES, P.E.
Lake County Engineer
By TAM Date 6/4/99

APPROVED
PAINESVILLE TOWNSHIP
ZONING DEPARTMENT
19990155
DWN

GENERAL NOTES:

1. DRIVEWAY APRON TO BE 6" THICK
2. BENCHMARK - TOP STEM OF FIRE HYDRANT LOCATED IN FRONT OF SUBLOT No. 34 , ELEV. = 692 28

LEGEND

EXISTING CONTOUR
PROPOSED CONTOUR

100.00 EXISTING ELEVATION
100.00 PROPOSED ELEVATION

CERTIFICATION

"I THE UNDERSIGNED HEREBY CERTIFY THAT THIS TOPOGRAPHY INDICATED BY 1' CONTOURS AND ELEVATIONS SHOWN HEREON REPRESENTS AN ACTUAL SURVEY MADE BY ME ON THE 6TH DAY OF MAY , 1999 AND THE ELEVATIONS WERE TAKEN AT APPROPRIATE INTERVALS AND AS OF THAT DAY THEY EXISTED AS INDICATED HEREON.

"I HEREBY CERTIFY THAT THIS PLAN WAS PREPARED BY ME AND IS CORRECT TO THE BEST OF MY KNOWLEDGE"

DAVID W NOVAK, P S No 7507

GRAPHIC SCALE

30 0 15 30 60 120

(IN FEET)
1 inch = 30 ft.

REV No	DESCRIPTION	DATE	BY	CHK'D

FORM No A3-2 (06/29/98)

STATE OF OHIO — DAVID W NOVAK S-7507 REGISTERED SURVEYOR

Himebaugh and Novak
Surveyors and Site Consultants
38342 Western Parkway, Unit 10
Willoughby, Ohio 44094
(440) 946-1761, (440) 918-0486 Fax.

LITTLE MOUNTIAN HOMES, INC.
1447 NORTH RIDGE ROAD, PAINESVILLE, OH. 44077

DATE MAY 25, 1999
DRAWN BY C.R. KRAFT
CHECKED BY: DWN
APPROVED BY
F.B. No -- PG --

SITE PLAN

SUBLOT NO. 35 BIG ROCK DRIVE, PAINESVILLE, OH 44077
EASTERN WOODLANDS SUBDIVISION, PAINESVILLE, OH.

SCALES
HORIZ: 1" = 30'
VERT NONE
CONTRACT No
99022-35
SHEET No 1 OF 1