

SITE	PLAN
------	-------------

R.L. MOORE 7121 Ravenna Rd. Concord Ohio 44077

48 SUBLOT No

Eastern Woodlands
SUBDIVISION NAME

Painesville Twp.

0hio

VOL. PAGE


Foresight Engineering Group

440 286-1010 440 286-1034 fax 320 Center Street, Unit F Chardon, Ohio 44024

Engineers & Surveyors

DESIGN CERTIFICATION

This Site Plan was prepared by Foresight Engineering Group, Inc., and is correct to the best of my knowledge and belief.

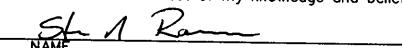

CHECK LIST

LOT DIMENSIONS & BEARINGS TIE TO NEAREST STREET SUBLOT No. (PARCEL No.) SURROUNDING OWNERS SURROUNDING OWNERS
BUILDING DIMENSIONS
SETBACK, SIDEYARD, REARYARD
FINISH GRADES
DRIVE & APRON TYPE, WDTH, THICKNESS
SIDEWALK TYPE, WDTH, THICKNESS
CULVERT TYPE, DIAM., LENGTH WATER MAIN SIZE, LOCATION SAN. SEWER SIZE, % GRADE, LOC. SAN. SEWER SIZE, % GRADE, LOC.
SAN. MH. CAST. ELEV., INV. ELEV.
SAN. CONN. SIZE, % GRADE. LOC.
STROM SEWER SIZE, % GRADE. LOC.
STORM MH. CAST. ELEV., INV. ELEV.
PAVT TYPE, GRADE, CURBS
GAS LINE LOC., SIZE
SEPTIC SYSTEM & DUPLICATION
WELL LOCATION & ISOLATION RADIUS



STATE SEAL

"AS BUILT" CERTIFICATION

I hereby certify that the circled information is existing as obtained on the site ___ correct to the best of my knowledge and belief.

NAME

SCALE : 1" = 20'	1
FILE NAME: I: \RIm19908\SL-48	2
DATE : May 24, 1999	3

BENCHMARK:

SAS Manhole Rim elev. =

"I, the undersigned hereby certify that this topography, indicated by 6", 1' or 2' contours, and the elevations shown hereon represent an actual field survey made by Foresight Engineering Group, Inc. on the 12 day of March 19 99 and that the elevations were taken at appropriate intervals and that as of that date they existed as indicated hereon."



CALL TOLL PRIZE 800-362-2764

EXISTING UNDERGROUND UTILITIES NOTES: The location both horizontal and vertical of the underground utilities shown hereon, have been obtained by a diligent and comprehensive search of available records. Verification by field observation, has been conducted where practical. However, Foresight Engineering Group, Inc. does not guarantee the completeness nor accuracy thereof.