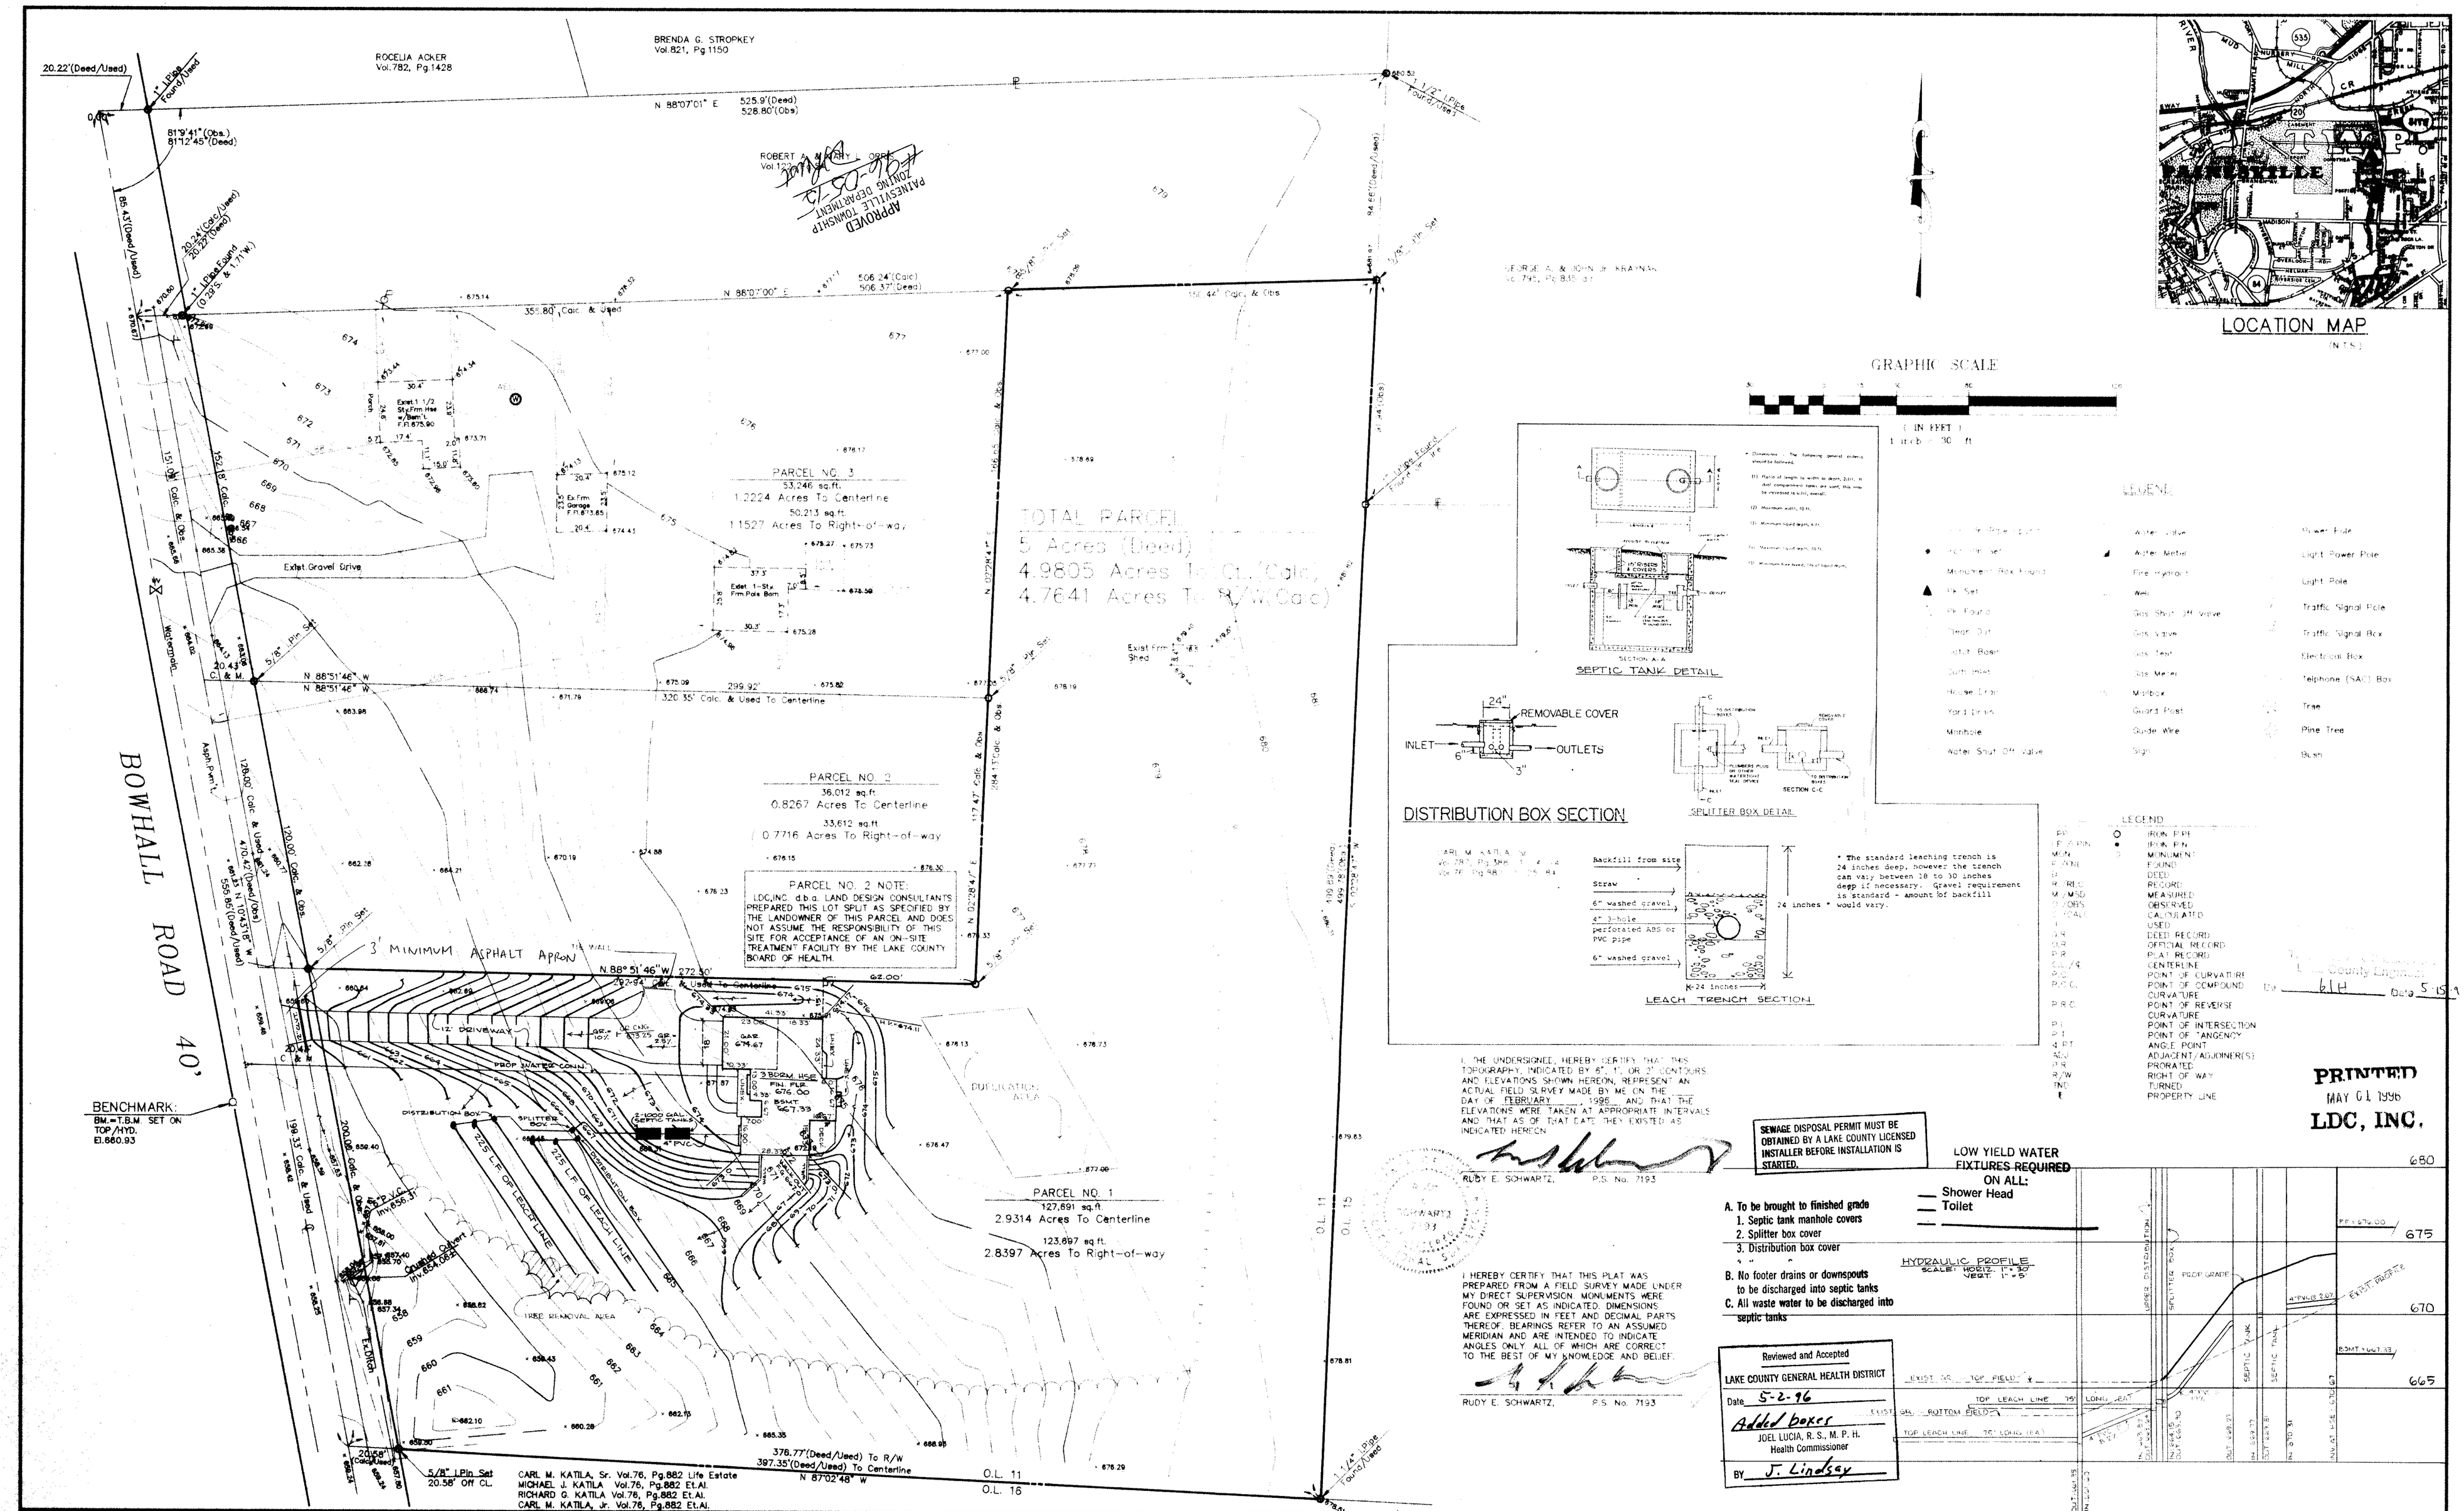

REV. No.		DATE	BY	CH'K'D

LDC, Inc. d.b.a.
LAND DESIGN consultants
Civil Engineers and Surveyors
8585 EAST AVENUE · MENTOR, OHIO 44060

P.P.N.: 11B-32F-2, BOWHALL ROAD

LANDS SHOWN ARE KNOWN AS BEING PART OF ORIGINAL PAINESVILLE TOWNSHIP LOT No.11, IN TRACT No.1, SITUATED NOW IN THE TOWNSHIP OF PAINESVILLE, COUNTY OF LAKE, STATE OF OHIO AND KNOWN AS BEING A PARCEL OF LAND CONVEYED TO DAVID G. RUSNAK BY DEED RECORDED IN VOL. 729, PGS. 557, 559

DATE	MARCH, 1996
SCALE: HOR.	1"=30'-0"
VERT.	
FILENAME	GSV\TOPO.DWG
CH'K'D BY	R.E.S.

BOUNDARY, LOCATION & TOPOGRAPHIC SURVEY OF A LOT SPLIT FOR:
RUSTIC HOMES

SHEET 1 OF 1

CONTRACT No.