


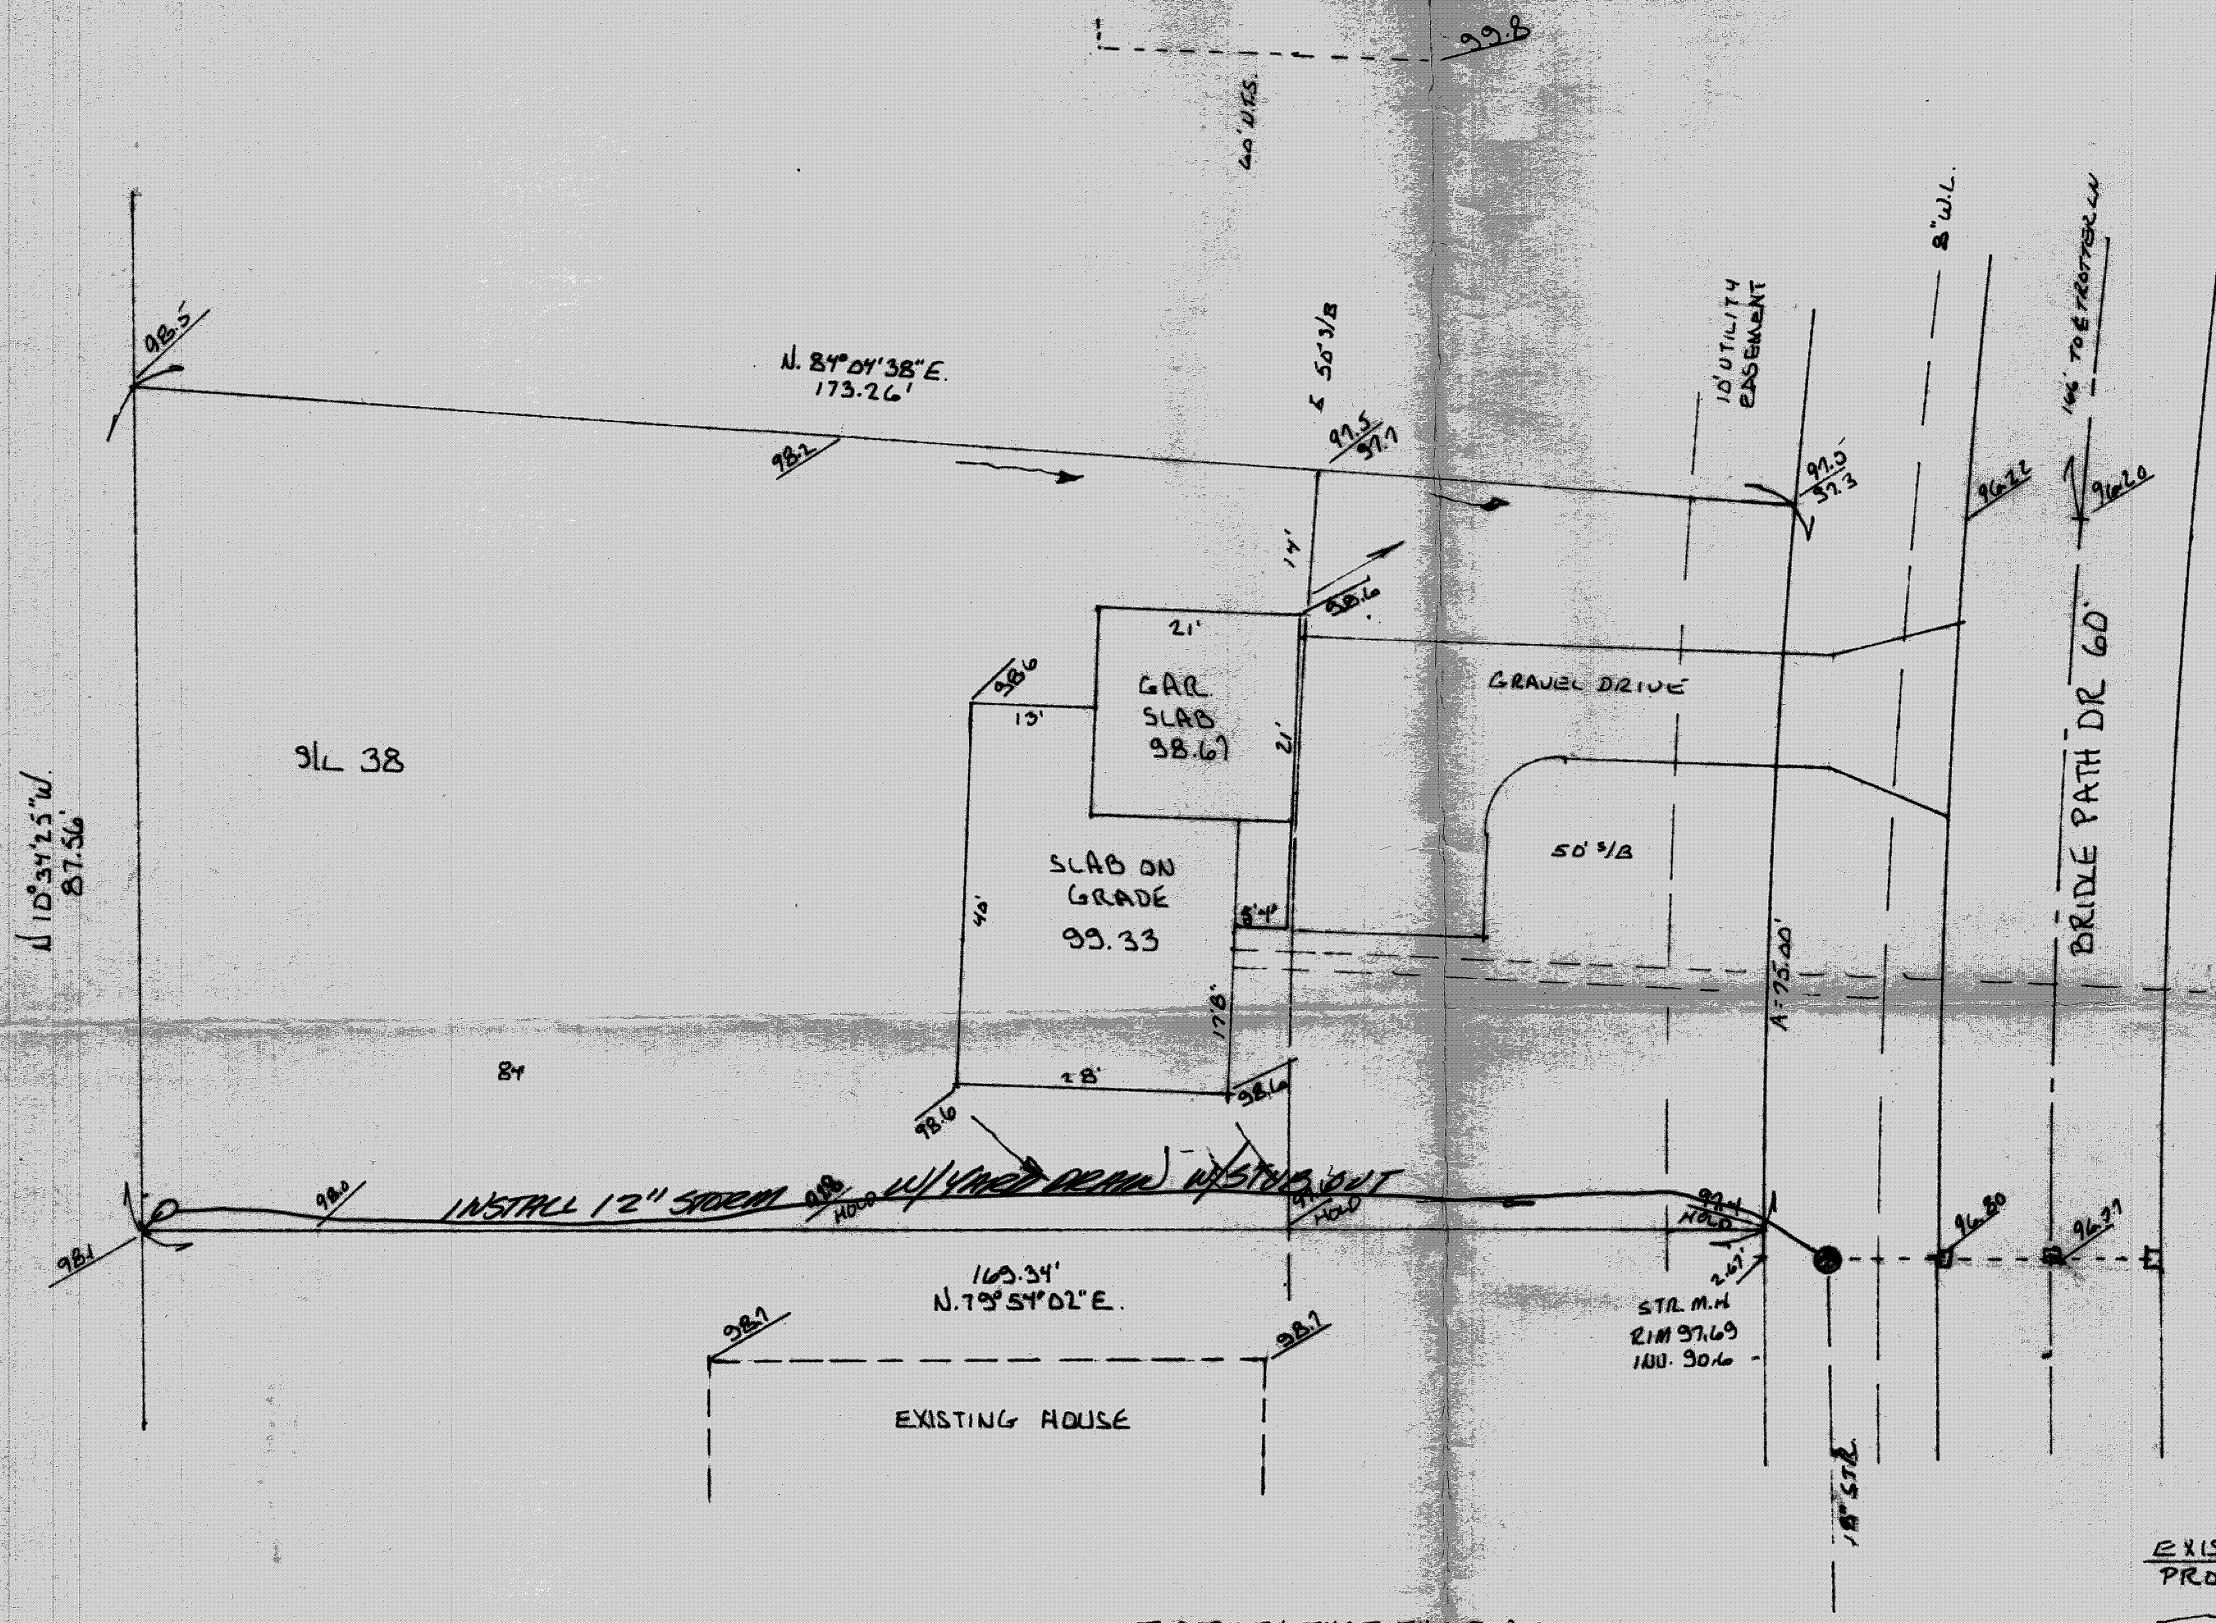

Grading Plan Approved
as shown and/or noted
THOMAS P. GILLES, P.E.
Lake County Engineer
By APR Date 2.6.86

This Permit Expires
JAN 25 1986
PAINESVILLE TOWNSHIP
ZONING APPROVED
6320
R.M. Har
Zoning Inspector 1/25/86

BEACHMARK
TOP STEM OF HYDRANT
AT SUBLT 35
ASSUME ELV. 100.00

I CERTIFY THAT THIS PLAN
WAS PREPARED BY ME AND
IS CORRECT TO THE BEST OF
MY KNOWLEDGE AND BELIEF
John C. Skonieczny
REG. SURVEYOR #6350
JOHN C. SKONIECZNY
7739 VIEWMOUNT DR
PAINESVILLE OHIO
44077
PH 352-7742

SITE PLAN for IDEAL AMERICAN HOMES		
SCALE: 1"=20'	APPROVED BY	DRAWN BY J.C.S.
DATE: DEC. 85		PLAT 7-4-1
BEING SUBLT 38 IN THE SIERRA PARK SUBDIVISION		
TOWNSHIP OF PAINESVILLE COUNTY OF LAKE STATE OF OHIO		
JOB # 85-467	DRAWING NUMBER 85-524	