


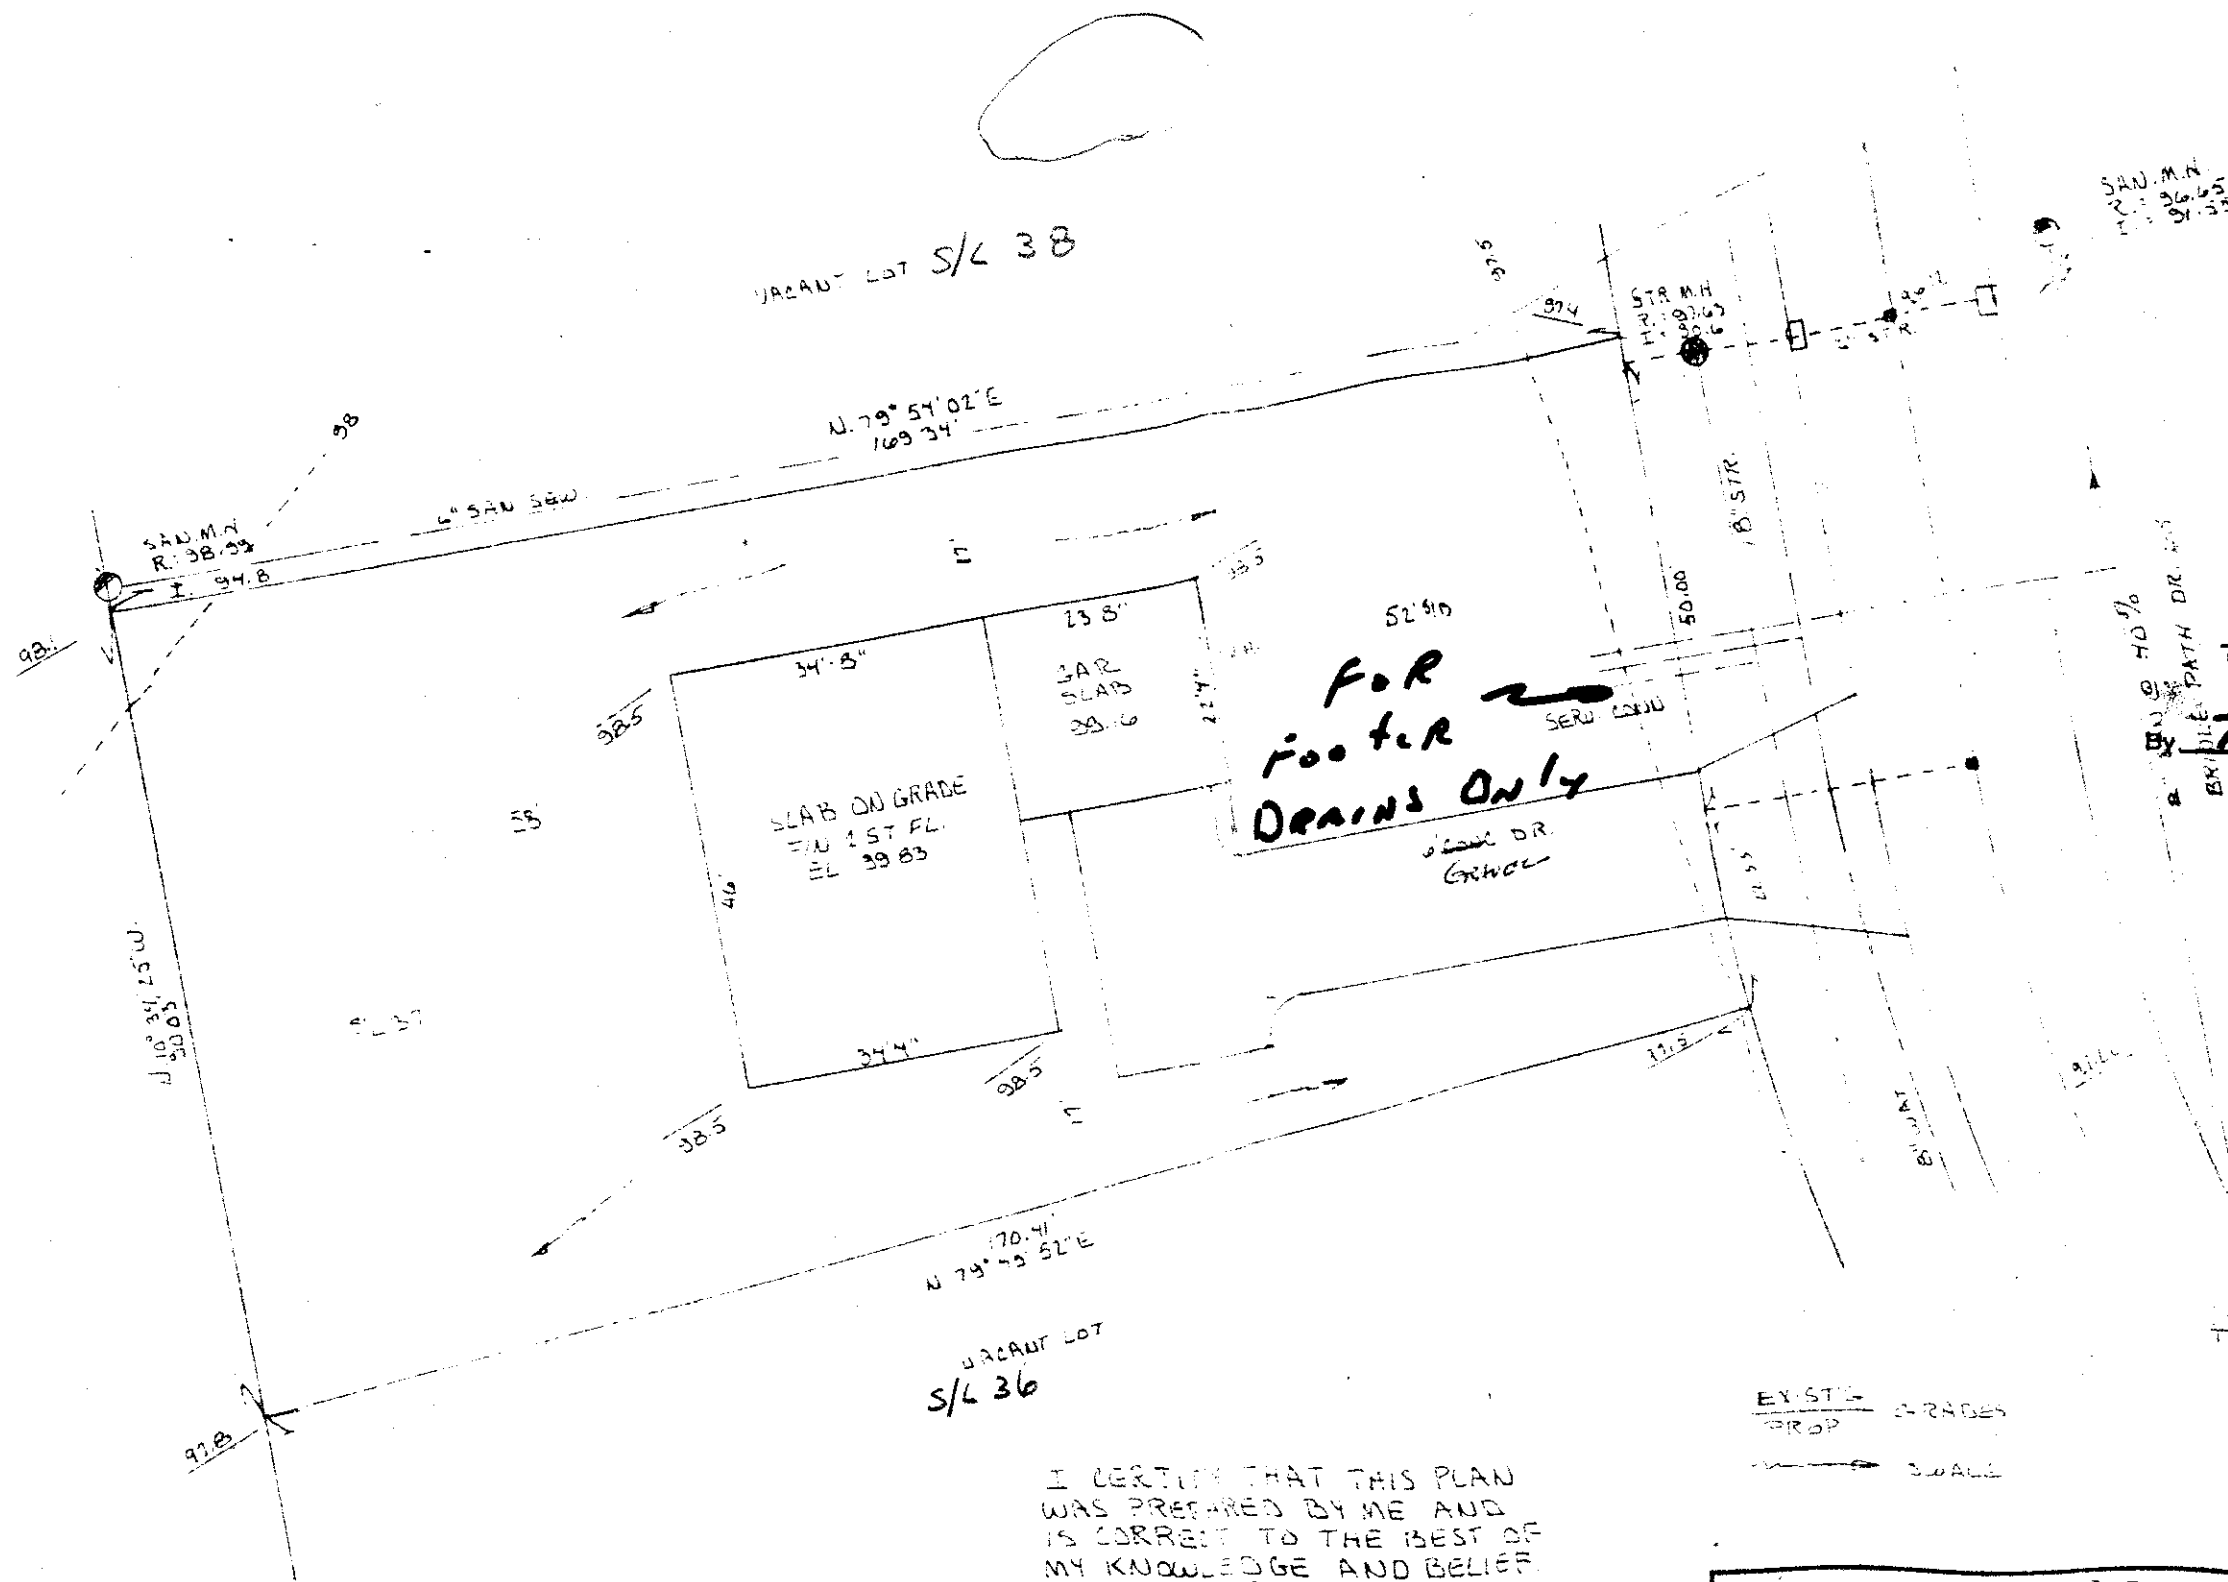

Grading Plan Approved
 as shown and/or noted
 THOMAS P. GILLES, P.E.
 Lake County Engineer
 By TS Date 4-1-83

This Permit Expires
 MAR 26 1984
 PAINESVILLE TOWNSHIP
 ZONING APPROVED
 # 37686
R.M. Hulen
 Zoning Inspector 3/26/83

BENCHMARK
 TOP STEM OF HYDRANT
 AT SUBLOT 35
 ASSUME ELEV. 100.00

EXISTING GRADES
 PROP. GRADES
 WALL

I CERTIFY THAT THIS PLAN
 WAS PREPARED BY ME AND
 IS CORRECT TO THE BEST OF
 MY KNOWLEDGE AND BELIEF.
John A. Skowronsky
 JOHN A. SKOWRONSKY
 7739 VIEWMOUNT DR.
 PAINESVILLE OHIO
 PH 352-7742

SITE PLAN for		
IDEAL AMERICAN HOMES		
SCALE: 1"=20'	APPROVED BY	DRAWN BY J.C.S.
DATE: MAR 83		PLANNED
BEING S/L 37		
SIERRA PARK SUBDIVISION		
TOWNSHIP OF PAINESVILLE COUNTY OF LAKE STATE OF OHIO		
DRAWING NUMBER		33 385