


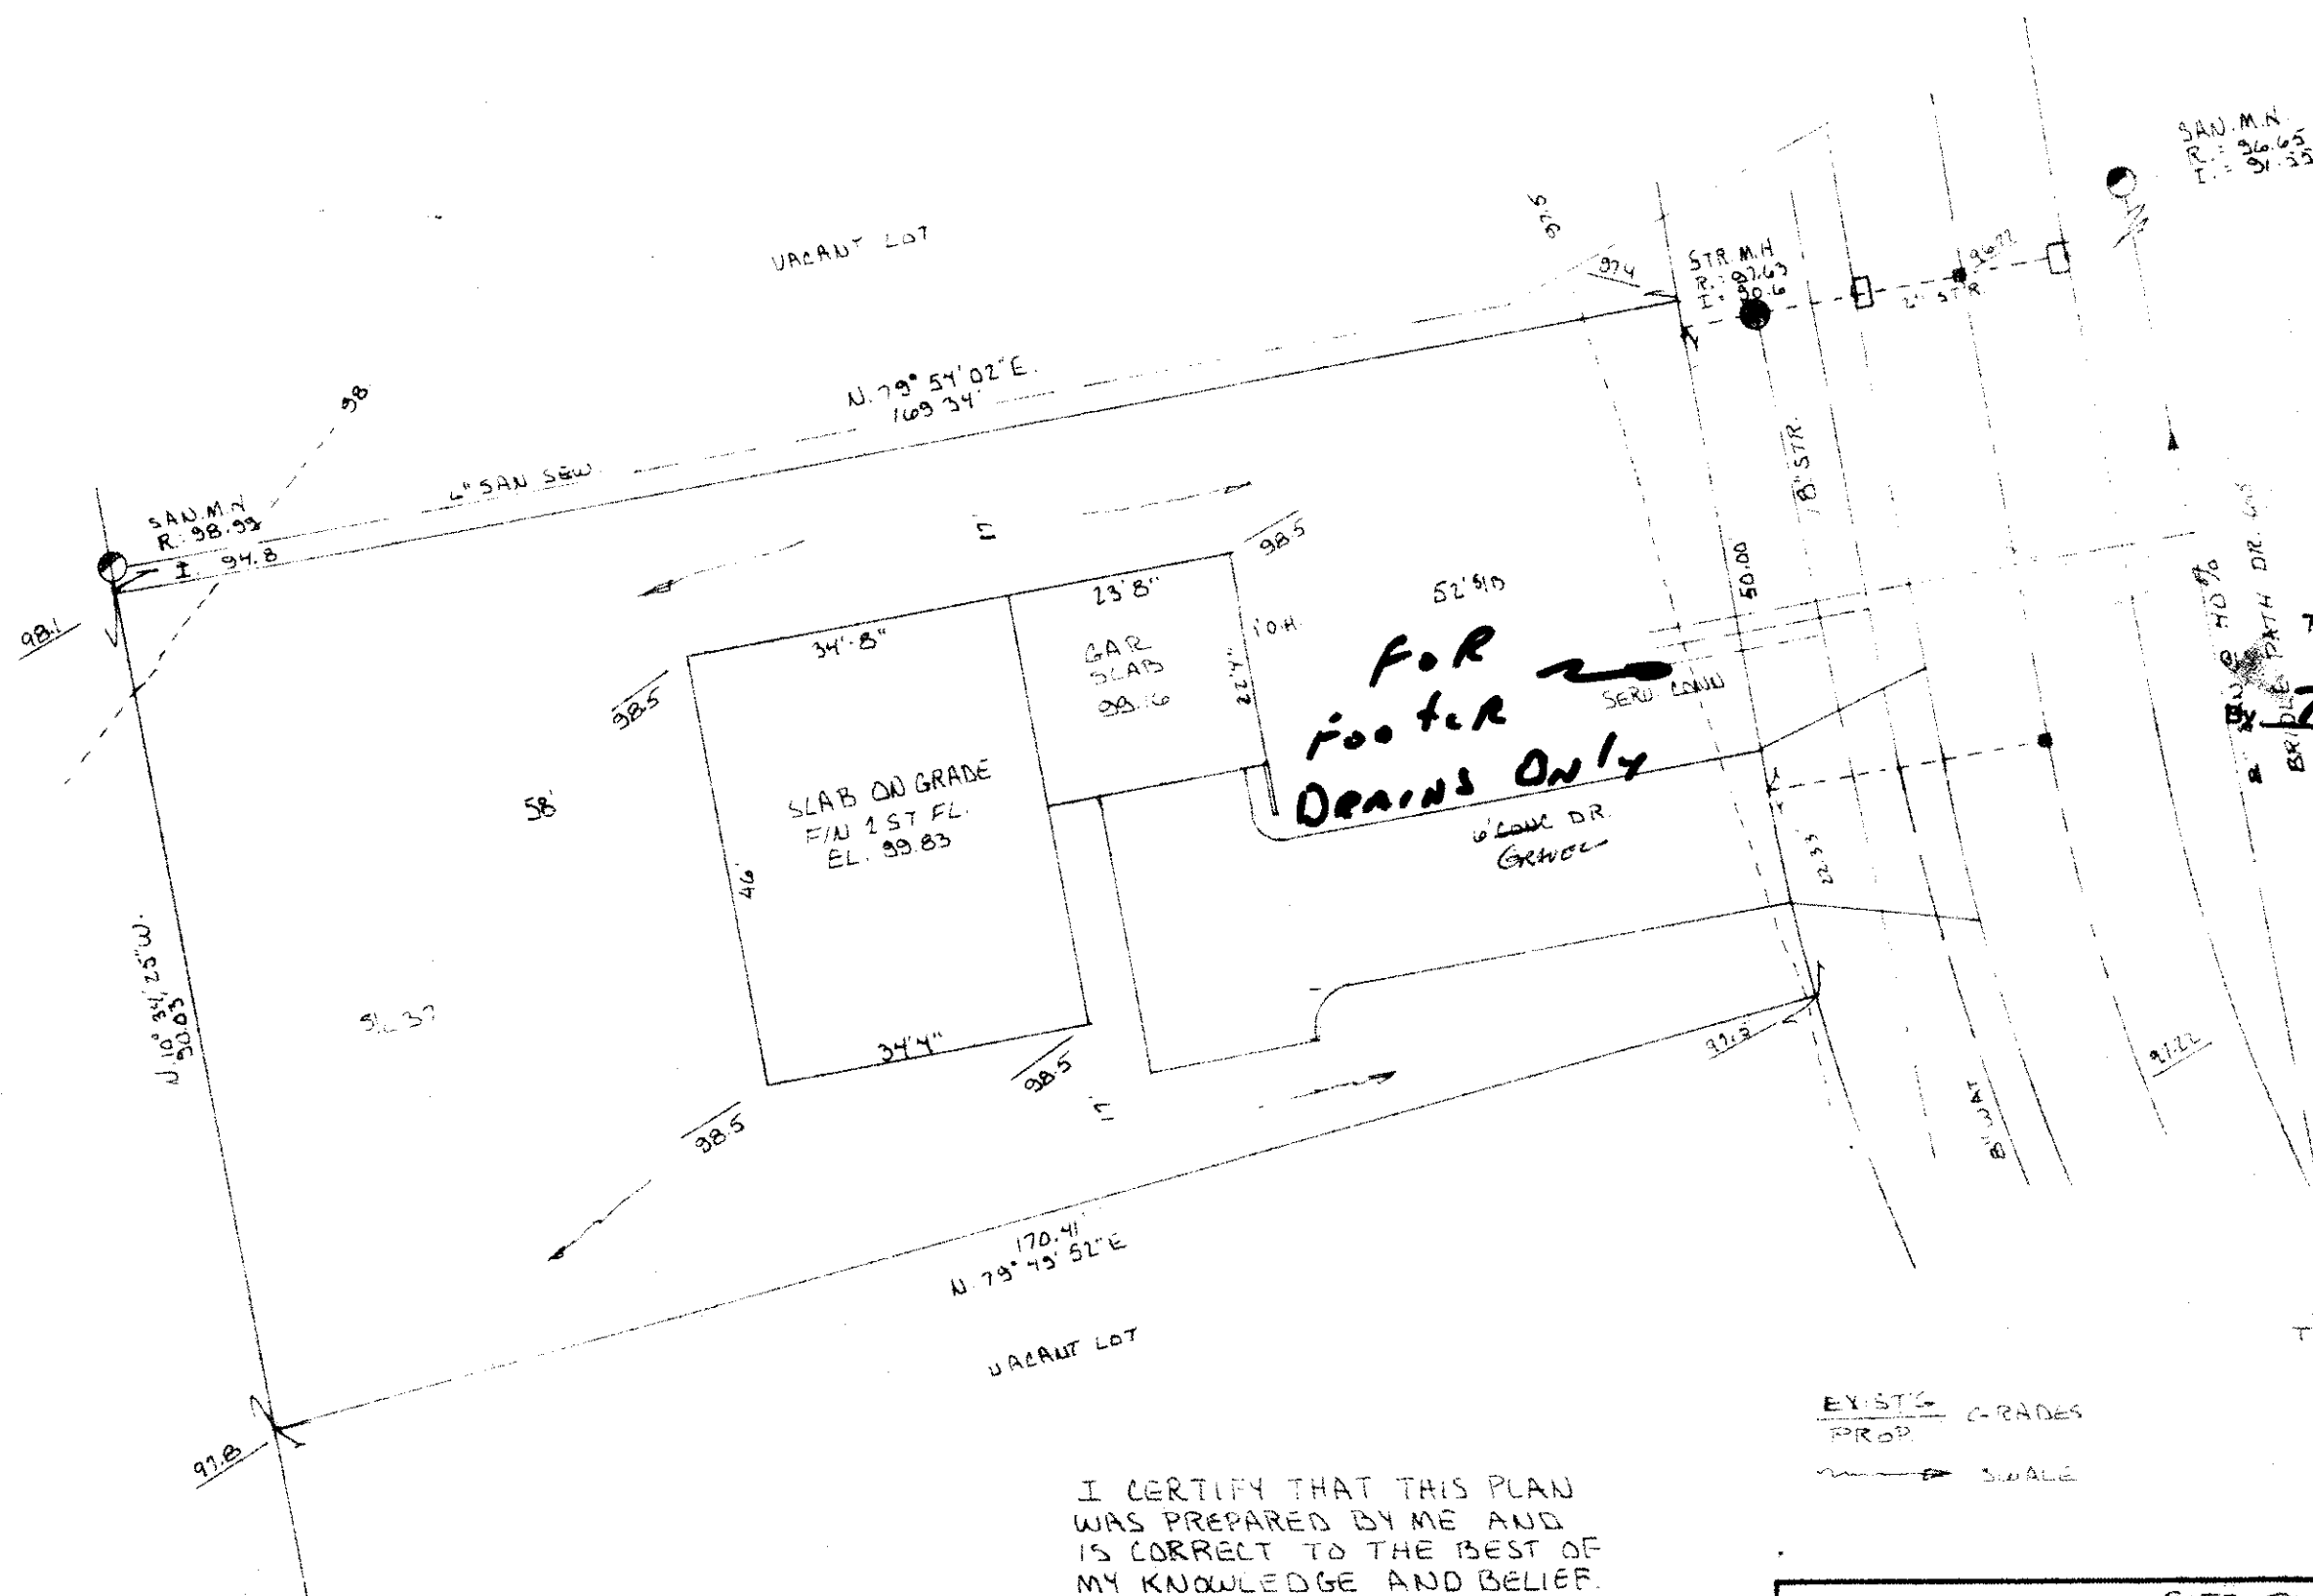

Grading Plan Approved
as shown and/or noted
THOMAS P. GILLES, P.E.
Lake County Engineer

Date **4-1-83**

This Permit Expires
MAR 20 1984
PAINESVILLE TOWNSHIP
ZONING APPROVED

5686

R. M. Harlan
Zoning Inspector 3/26/83

BENCHMARK
TOP STEM OF HYDRANT
AT SUBLOT 35
ASSUME ELV. 100.00

EXIST'G GRADES
PROP. SWALE

I CERTIFY THAT THIS PLAN
WAS PREPARED BY ME AND
IS CORRECT TO THE BEST OF
MY KNOWLEDGE AND BELIEF.

John E. Skowron
JOHN E. SKOWRON
7739 VIEWMOUNT DR.
PAINESVILLE OHIO
PN 352-7742

SITE PLAN FOR IDEAL AMERICAN HOMES		
SCALE: 1"=20'	APPROVED BY	DRAWN BY J.C.S.
DATE: MAR-83		PLAT 4-4
BEING 51.37 SIERRA PARK SUBDIVISION		
TOWNSHIP OF PAINESVILLE COUNTY OF LAKE STATE OF OHIO		
DRAWING NUMBER		83-385