


IDEAL AMERICAN HOMES 501 SITE PLAN	
SCALE: 1"=20'	APPROVED BY
DATE: MAR-83	DRAWN BY J.C.S. PLAT Y-Y
BEING 51.35 91ERRA PARK SUBDIVISION TOWNSHIP OF PAINESVILLE COUNTY OF LAKE STATE OF OH.	
DRAWING NUMBER 83-386	

I CERTIFY THAT THIS PLAN
WAS PREPARED BY ME AND
IS CORRECT TO THE BEST OF
MY KNOWLEDGE AND BELIEF

John C. Skowieczny
REG. SURVEYOR # 0356
JOHN C. SKOWIECZNY
7739 NICHOLSON DR
PAINESVILLE OHIO
PN 352-7742

This Permit Expires
MAR 26 1984
PAINESVILLE TOWNSHIP
ZONING APPROVED
5687
R.M. Lutz
Zoning Inspector 3/26/83

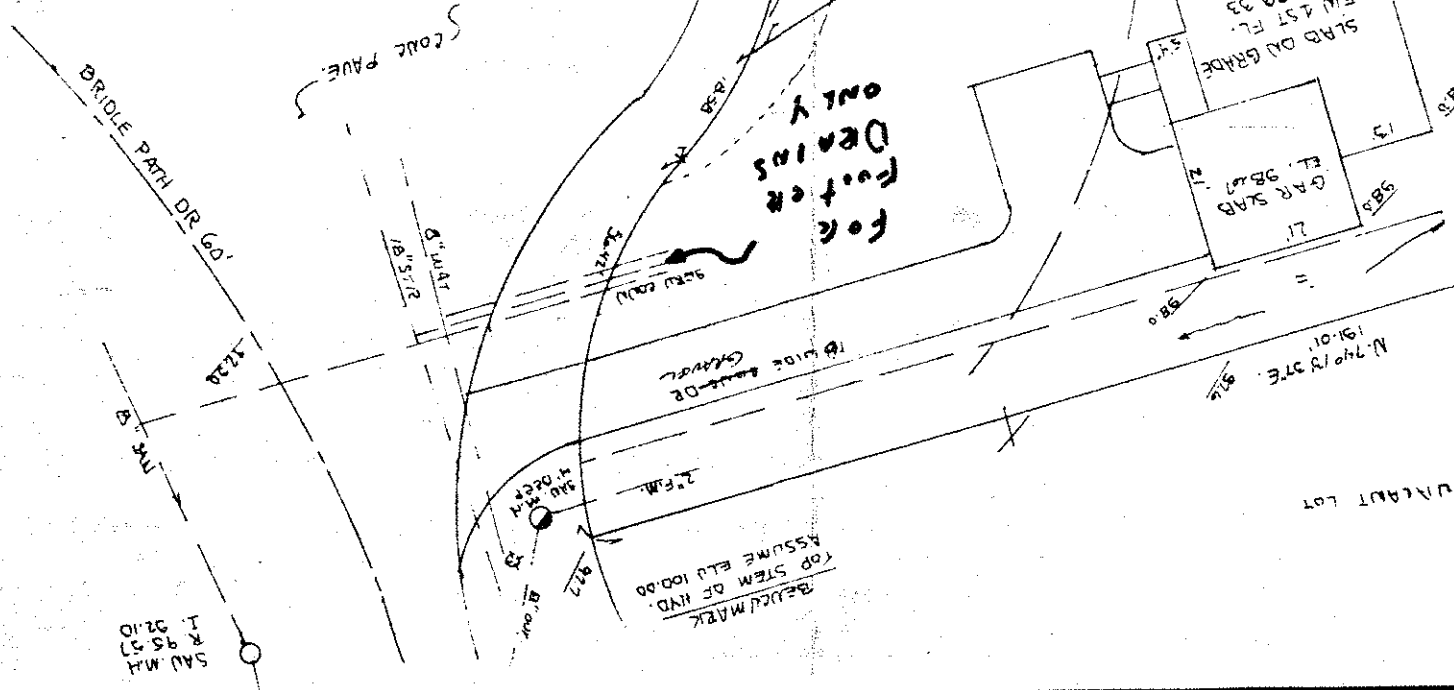

EXISTG	PROP
GRADE	

5047